



REV. NO. DESCRIPTION
REVISED AS-BUILT

REV. DATE APPROVED
8-14-00

CHS ENGINEERS, INC.
12507 Bel-Red Road Suite 101
Bellevue, Washington 98005-2500
425-6373-3693, Fax 637-3694

JMGR, Inc.
ARCHITECTS/ENGINEERS
12000 1st Avenue, Suite 310
Maple Valley, Washington 98149
206-206-9600, Fax 521-1337

USARC/OMS - Phase One
Ft. Lawton, WA

GENERAL SITE PLAN
LOCATION AND VICINITY MAPS

PROJ. NUMBER: H&R PM 10707
ISSUE: YEAR 1 1994
DESIGNED BY: J. AS
DRAWN BY: J. DJ
SCALE: 1" = 100'
DATE CHECKED BY: J. AS
DATE 1 IS JUNE 97
APPROVED BY: J. AS

C1.0 AS-BUILT



FORT LAWTON USARC/OMS

GENERAL NOTES

- PROJECT BASE MAPPING (SHEETS C1.1, C1.2 AND C1.3) MAP COMPILED FROM AERIAL PHOTOGRAPHY FLOWN 22-JULY-1994. SUPPLEMENTED BY FIELD SURVEY PERFORMED SEPTEMBER 1994. U.S. ARMY CORPS OF ENGINEERS, SEATTLE DISTRICT FIELD BOOK FILE NO. 15-228, BOOKS 1-15. HORIZONTAL CONTROL BASED ON WASH. COORD. SYSTEM, NO. ZONE, NAD83/91. VERTICAL CONTROL BASED ON N.A.V.D. '86.
- LOCATIONS SHOWN FOR EXISTING UTILITIES ARE APPROXIMATE. IDENTIFICATION LOCATION MARKING AND RESPONSIBILITY FOR UNDERGROUND FACILITIES OR UTILITIES LOCATION IS GOVERNED BY THE PROVISIONS OF CHAPTER 19.122 REVISED CODE OF WASHINGTON. CONTRACTOR SHALL VERIFY THE LOCATION OF ALL UNDERGROUND UTILITIES BEFORE DIGGING. CALL 1-800-424-5555 BEFORE YOU DIG.
- MINIMUM SEPARATION OF POTABLE WATER MAINS AND SANITARY SEWER LINES SHALL BE TEN (10) FEET HORIZONTALLY FOR PARALLEL PIPE, AND THREE (3) FEET VERTICALLY FOR PERPENDICULAR OR OBLIQUE CROSSINGS. MEASURED FROM OUTSIDE EDGE TO OUTSIDE EDGE. SITUATIONS OCCURRING WITH LESS THAN MINIMUM SEPARATION SHALL BE CONSTRUCTED IN ACCORDANCE WITH SECTION 2.41 OF THE "CRITERIA FOR SEWAGE WORKS DESIGN" PUBLISHED BY THE WASHINGTON STATE DEPARTMENT OF ECOLOGY AS REVISED OCTOBER 1985.
- THE CONTRACTOR IS CAUTIONED THAT OVERHEAD ELECTRICAL SERVICE LINES ARE GENERALLY NOT SURVEYED. ELECTRICAL LINES SHOWN ON THE DRAWINGS ARE LOCATED BY POINT TO POINT. POWER POLE-TO-POWER POLE CONNECTION. THE CONTRACTOR IS RESPONSIBLE FOR DETERMINING THE EXTENT OF ANY HAZARD CREATED BY OVERHEAD ELECTRICAL POWER IN THE PROJECT AREA AND FOR FOLLOWING THE APPROPRIATE SAFETY PROCEDURES FOR CONSTRUCTION UNDER OR ADJACENT TO SUCH FACILITIES.



GENERAL SITE PLAN
SCALE: 1" = 100' C.I. = 2'

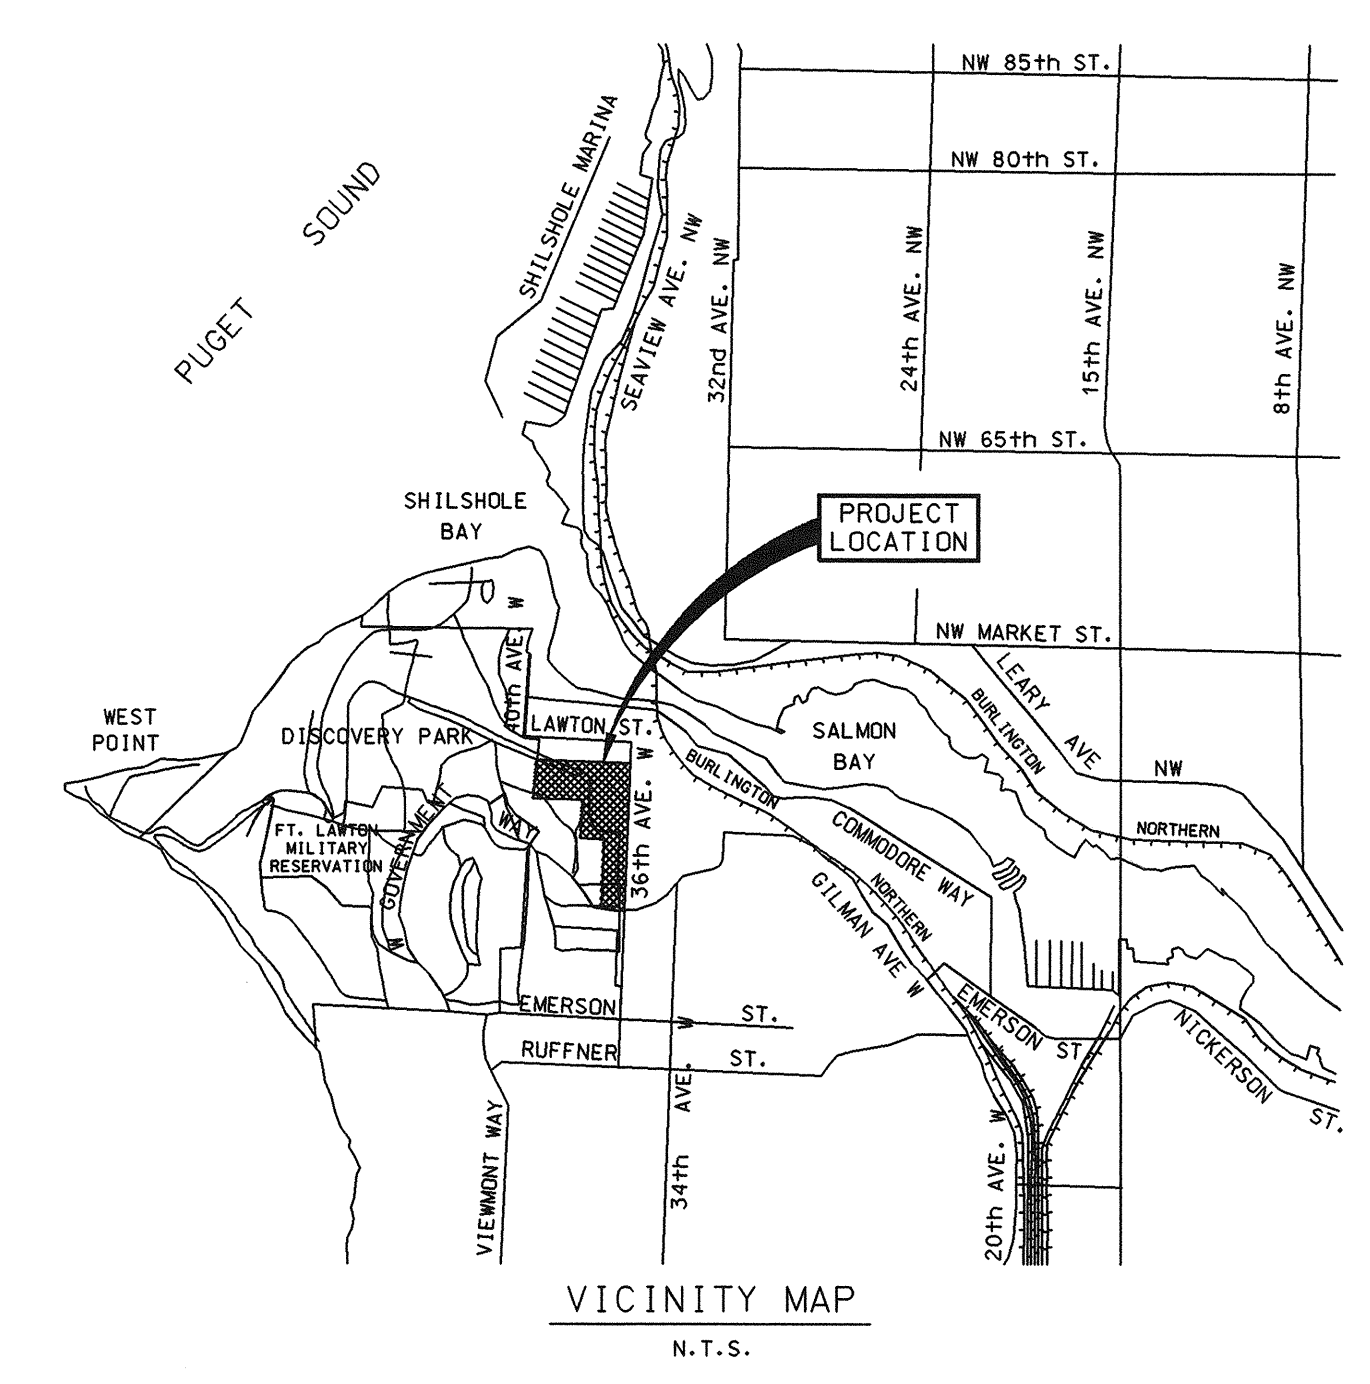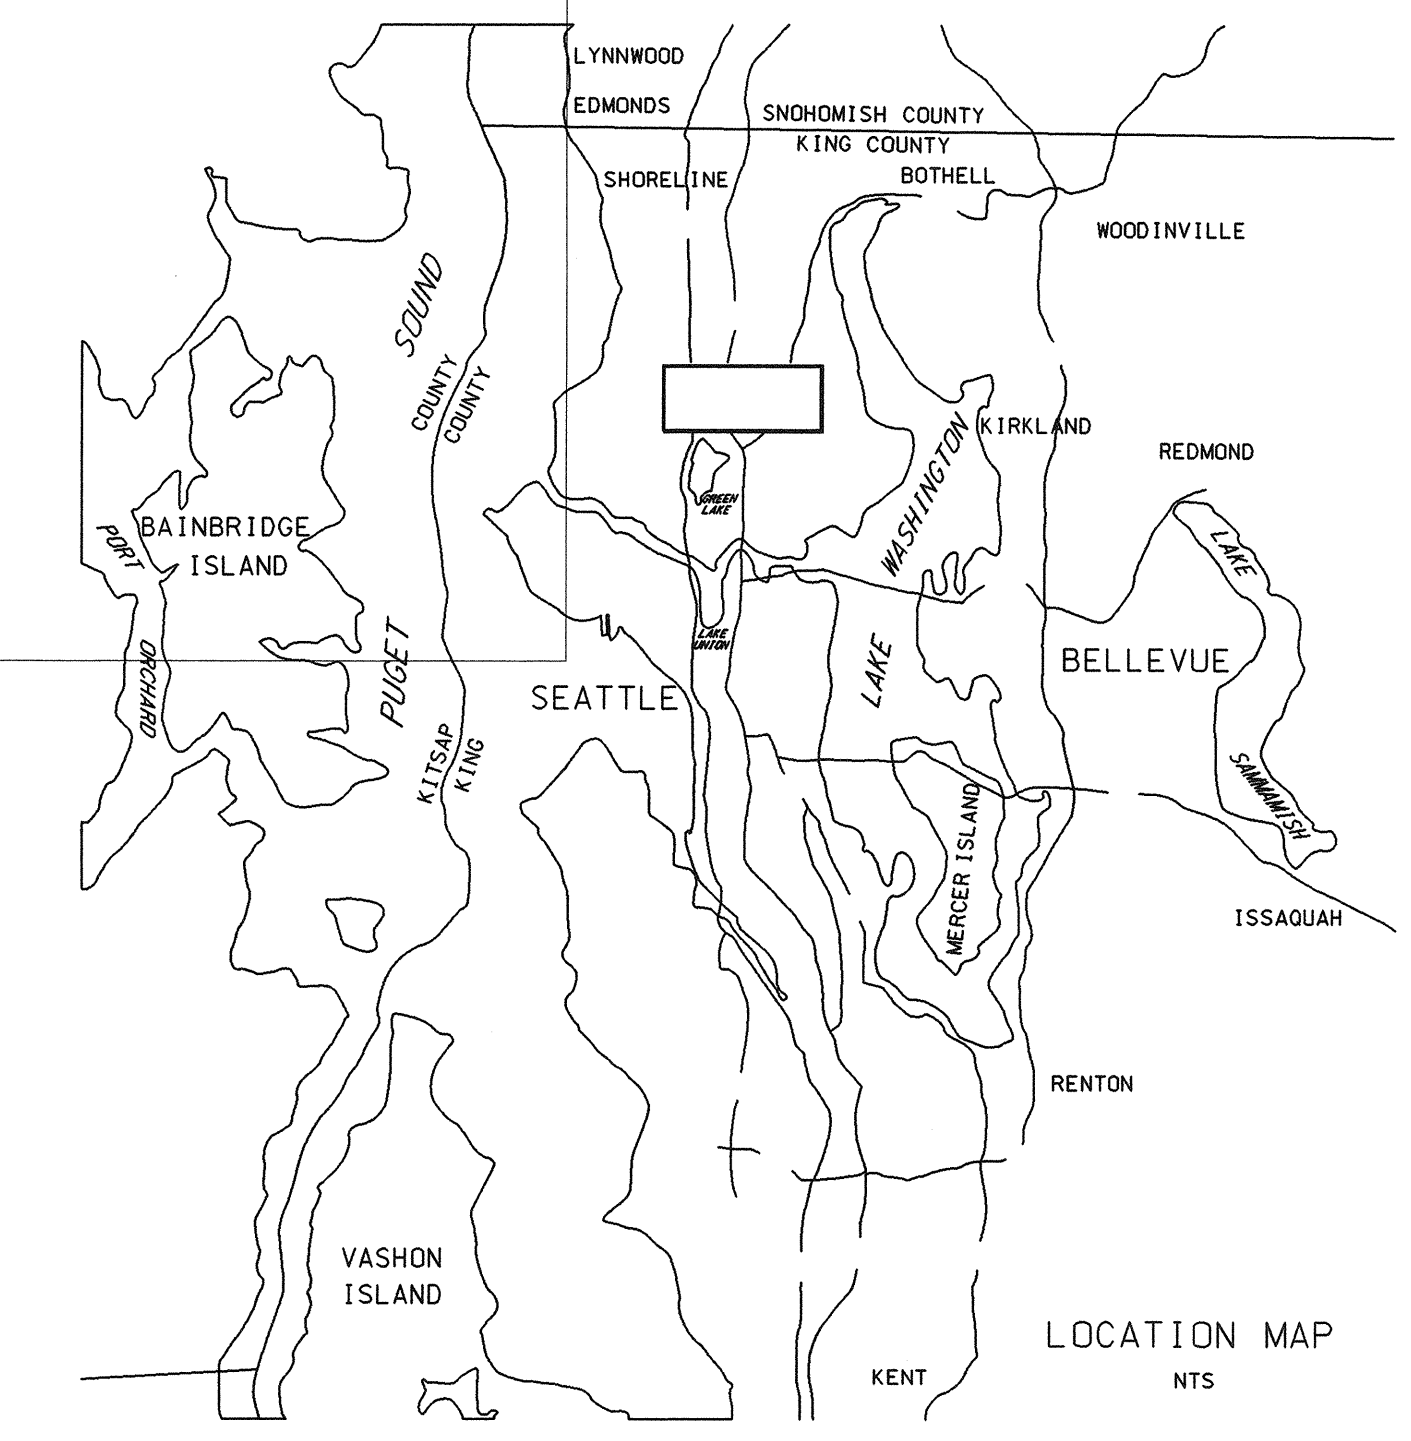

VICINITY MAP
N.T.S.