

Redline Markups

for the

2023 City of Seattle Standard Plans for Municipal Construction

The Standard Plans shown here depict the proposed edits of the 2020 Standard Plans used to create the 2023 Construction Standards.

RDWY	Roadway
RECONN	Reconnect
RED	Reducer
REF	Refer/Reference
REINF	Reinforce/Reinforcement
RELOC	Relocate
REM	Remove
REPL	Replace
REQD	Required
RET	Retire/Retired
RET WALL	Retaining Wall
RF	Rock Facing
RGS	Rigid Galvanized Steel
RIT	Round Inlet Top
RJ	Restrained Joint
RLWY	Railway
RP	Rock Pocket
RPBA	Reduced Pressure Backflow Assembly
RR	Railroad
RS	Rigid Steel
RT	Right
S	South
SB	Sandbox
SCH	Schedule
SCL	Seattle City Light
SDCI	Seattle Department of Construction & Inspections
SDS	Street Designation Sign
SD	Service Drain
SDOT	Seattle Department of Transportation
SEC	Section
SHLD	Shield
SHT	Sheet
SL	Sleeve, Street Light

§	Survey Line
SLHH	Street Light Handhole
SNS	Street Name Sign
SP	Strain Pole
SPCS	Spaces
SPEC	Specifications
SPR	Seattle Parks & Recreation
SPU	Seattle Public Utilities
SQ	Square
SS	Stainless Steel, Side Sewer—Combined
SSD	Sub-Surface Drain
SSS	Side Sewer—Sanitary
SSTONE	Sandstone
ST	Street
STA	Station
STD	Standard
STL	Steel
STL P	Steel Pipe
STM LOG	Steam Log
STRUCT	Structure/Structural
SW	Sidewalk
SY	Square Yard
SYS	System
T	Tee
TB	Test Boring
TC	Traffic Control
TCB	Telephone Cable
TCD	Telephone Conduit
TCHH	Traffic Control Handhole
TD	Telephone Duct
TEB	Telephone Enclosure Box
TEL	Telephone
TEMP	Temporary

REF STD SPEC SEC 1-01.2



City of Seattle

NOT TO SCALE

ABBREVIATIONS

ITEM

EXISTING

PROPOSED

Pavement, HMA or
WMA (CL $\frac{1}{2}$ ")

2" ASPH

2"

Roadway Cement
Concrete, (type to be
shown in drawings)

6" CONC

2" HMA or WMA, CL $\frac{1}{2}$ "
Over Roadway Cement
Concrete Base

2" ASPH/6" CONC

2" HMA or WMA, CL $\frac{1}{2}$ "
over HMA or WMA, CL 1"

8" ASPH

REF STD SPEC SEC



City of Seattle

NOT TO SCALE


**STANDARD SYMBOLS
PAVING**

ITEM


EXISTING

PROPOSED



Type 410b Curb & Gutter

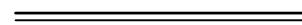



Type 410c Curb

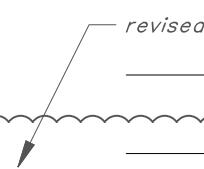



Cement Concrete Walk

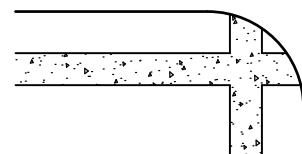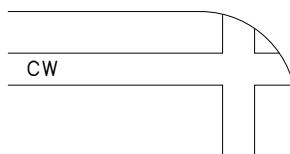



Pervious Concrete Walk

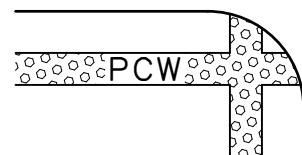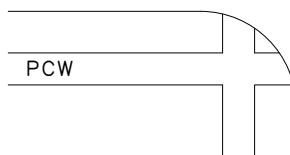

Curb Ramp

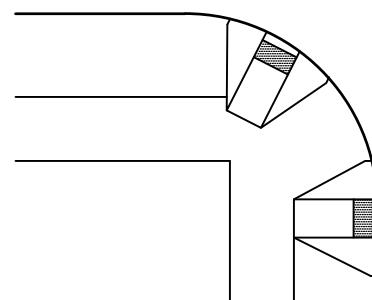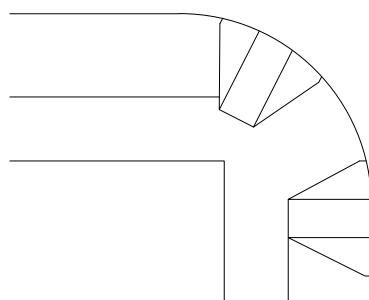


Type 430a Conc Dwy

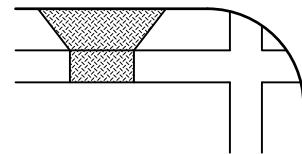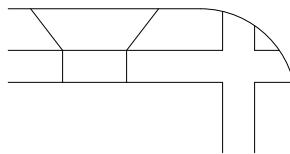

Pervious Concrete Surface



Grading




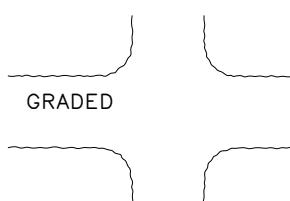
STANDARD SYMBOLS
PAVING

REF STD SPEC SEC



City of Seattle

NOT TO SCALE

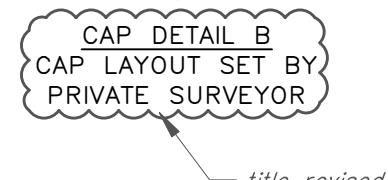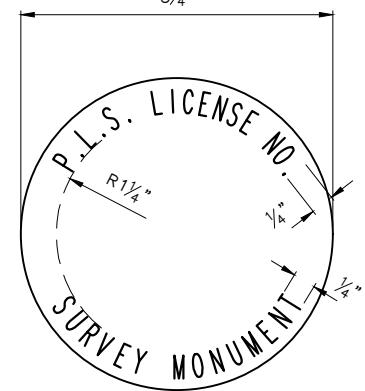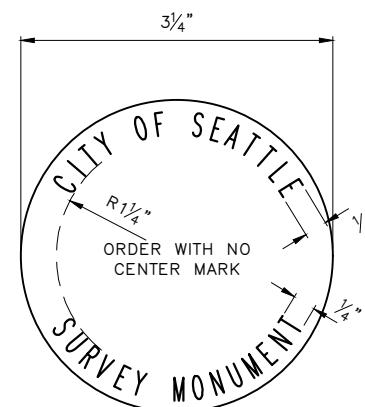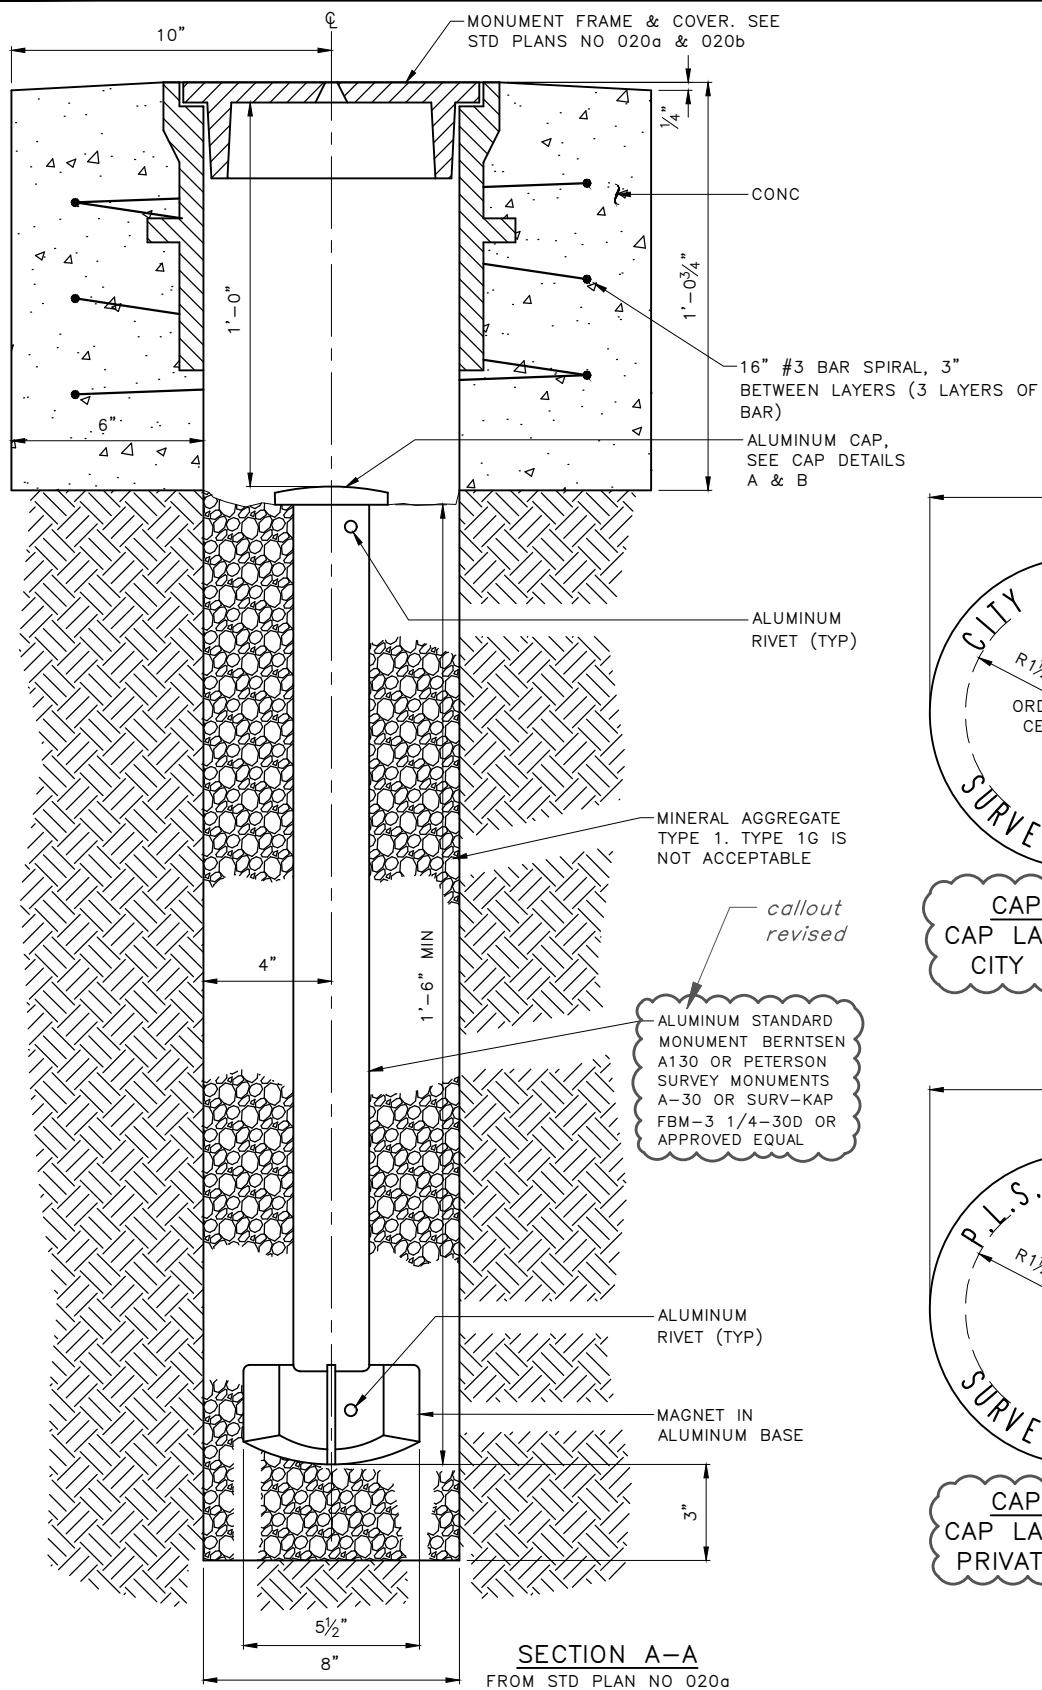


REF STD SPEC SEC 8-13



City of Seattle

NOT TO SCALE

SURVEY MONUMENT

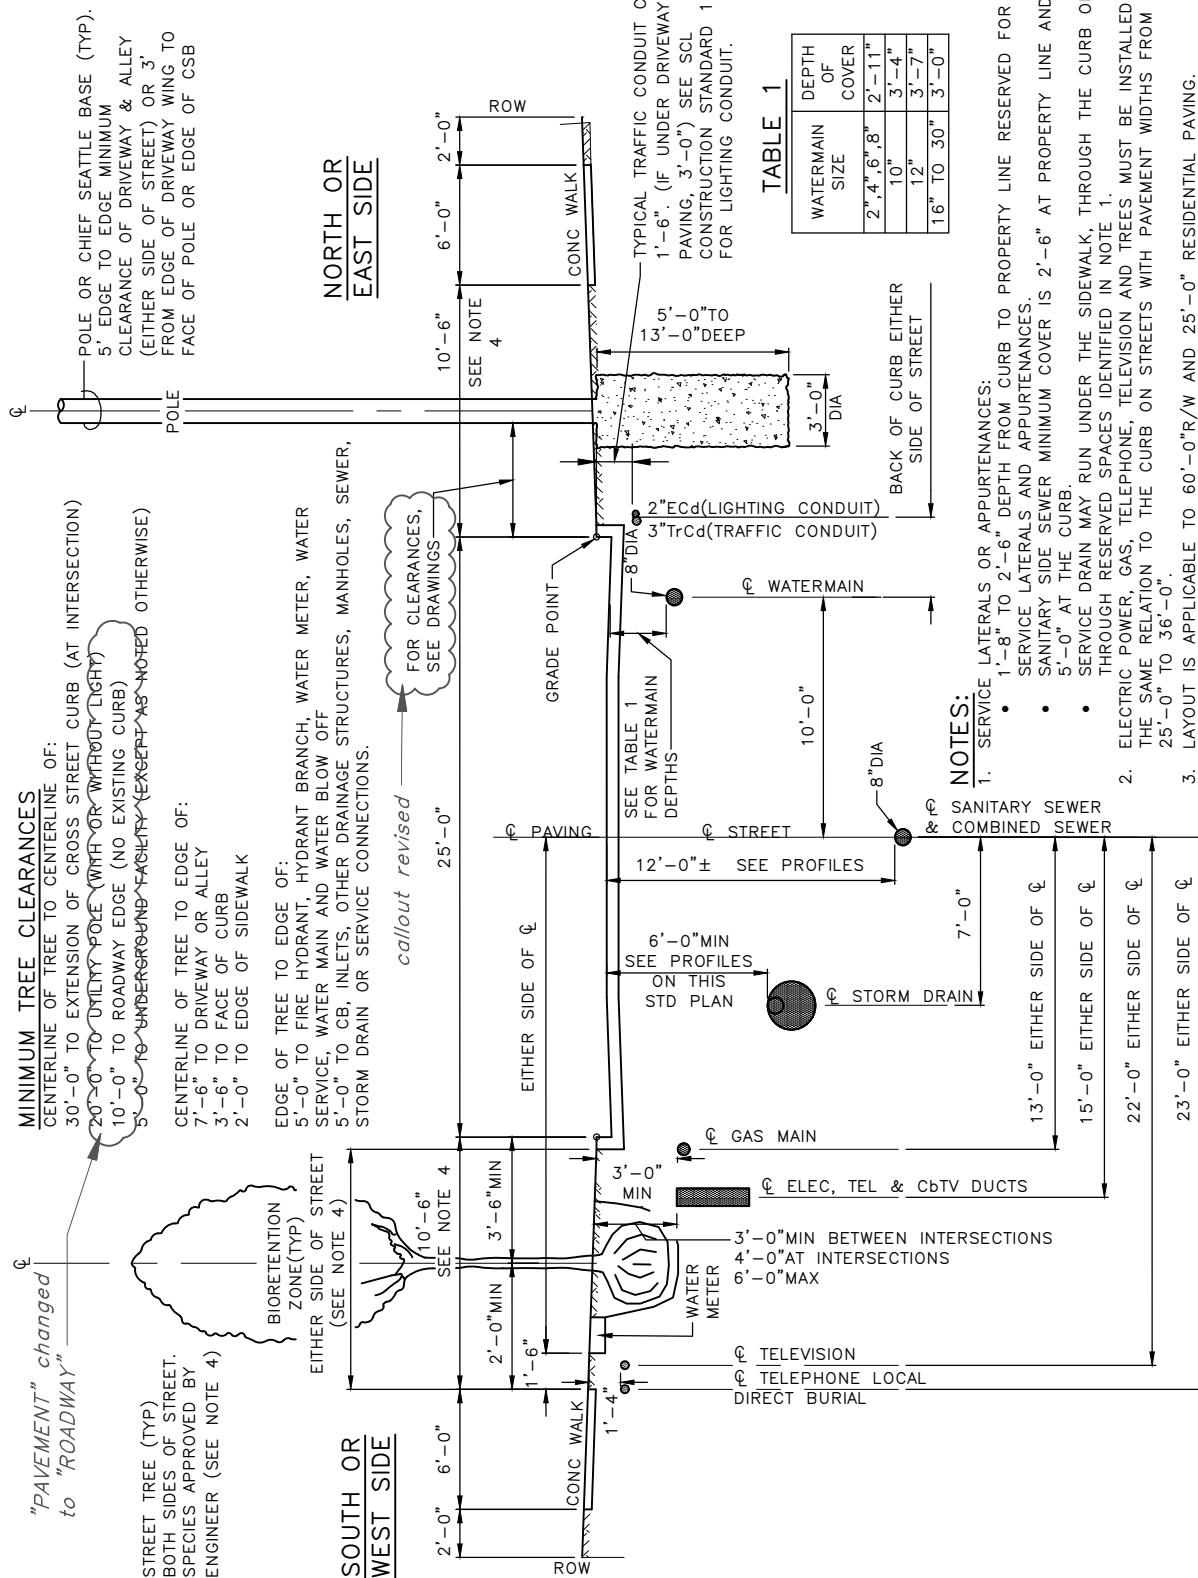

1. SERVICE LATERALS OR APPURTENANCES:
 - 1'-8" TO 2'-6" DEPTH FROM CURB TO PROPERTY LINE RESERVED FOR SERVICE LATERALS AND APPURTENANCES.
 - SANITARY SIDE SEWER MINIMUM COVER IS 2'-6" AT PROPERTY LINE AND 5'-0" AT THE CURB.
 - SERVICE DRAIN MAY RUN UNDER THE SIDEWALK, THROUGH THE CURB OR THROUGH RESERVED SPACES IDENTIFIED IN NOTE 1.
 - 2. ELECTRIC POWER, GAS, TELEPHONE, TELEVISION AND TREES MUST BE INSTALLED IN THE SAME RELATION TO THE CURB ON STREETS WITH PAVEMENT WIDTHS FROM 25'-0" TO 36'-0".
 - 3. LAYOUT IS APPLICABLE TO 60'-0"R/W AND 25'-0" RESIDENTIAL PAVING.
 - 4. REDUCING CLEARANCE BETWEEN A NEW UTILITY AND EXISTING TREE/PLANTING STRIP, REDUCING CLEARANCE BETWEEN A NEW/REPLACEMENT TREE AND EXISTING UTILITY, INCORPORATING GSI (BIORETENTION) INTO PLANTER STRIP OR CURB EXTENSION OR CHANGING THE 10'-6" WIDTH OF PLANTING STRIP REQUIRES REVIEW AND APPROVAL OF THE ENGINEER AND MAY REQUIRE ADDITIONAL MITIGATING MEASURES.
 - 5. BACKFILL OVER ALL UTILITY INSTALLATIONS BETWEEN BACK OF CURB AND R/W AND WITHIN 5' OF CENTERLINE OF TREES MUST BE PLANTING SOIL FOR A MINIMUM DEPTH EQUAL TO THE DEPTH OF THE ROOTBALL (NO CDF ALLOWED IN THIS ZONE).




<divREF STD SPEC SEC 1-07.16, 1-07.17, 1-07.28



City of Seattle

NOT TO SCALE

DESIRABLE LOCATIONS FOR UTILITIES (RESIDENTIAL STREET)

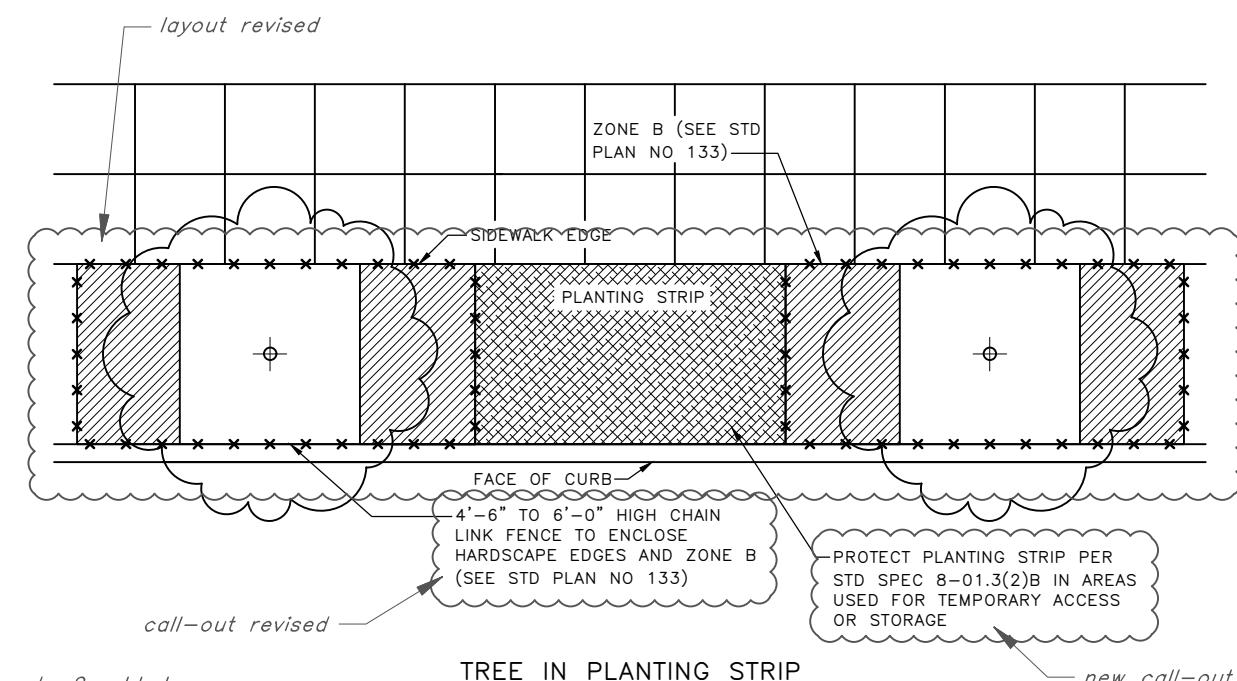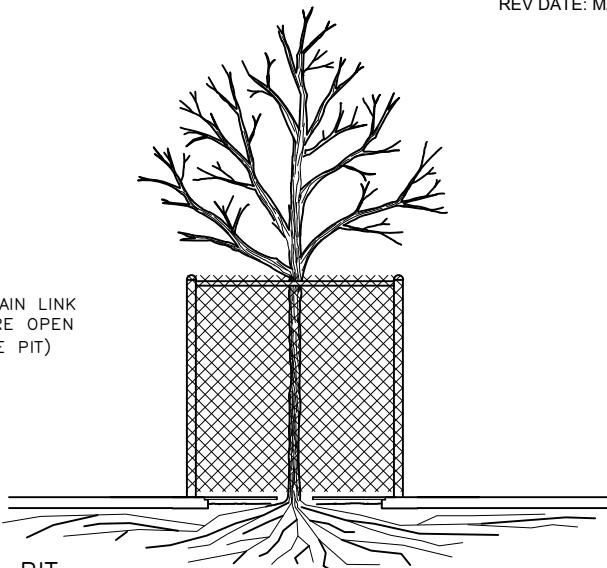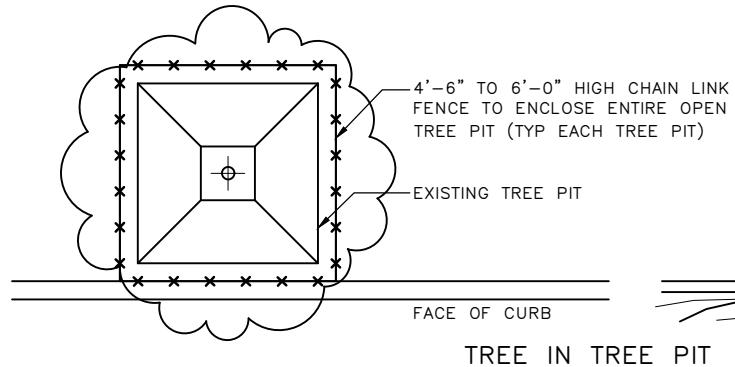

NOTES:

1. CONSIDER TRAFFIC TURNING VISIBILITY AND PEDESTRIAN VISIBILITY WHEN SELECTING FENCE HEIGHT; TYPICALLY SHORTER FENCING AROUND TREE PITS BETWEEN SIDEWALK AND ROADWAY IS DESIRED.
2. TO BE USED FOR TREES IN PLANTING STRIPS AND FOR WORK LASTING 31 CALENDAR DAYS OR MORE. FOR TREES IN TREE PITS AND LASTING 30 CALENDAR DAYS OR LESS, SEE STD PLAN 132b.

"TREE IN PLANTING STRIP-OPTION 2" removed


REF STD SPEC SEC 1-07.16(2), 8-01




City of Seattle

NOT TO SCALE


**TREE PROTECTION
DURING CONSTRUCTION**

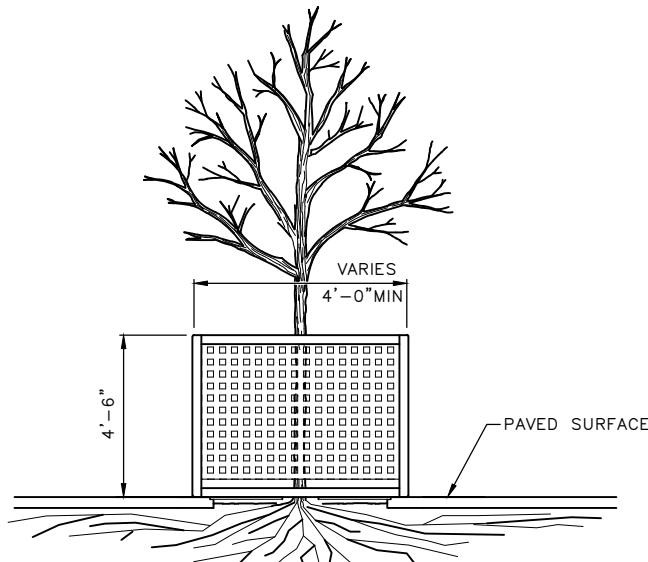


TYPICAL TREE GUARD RAIL

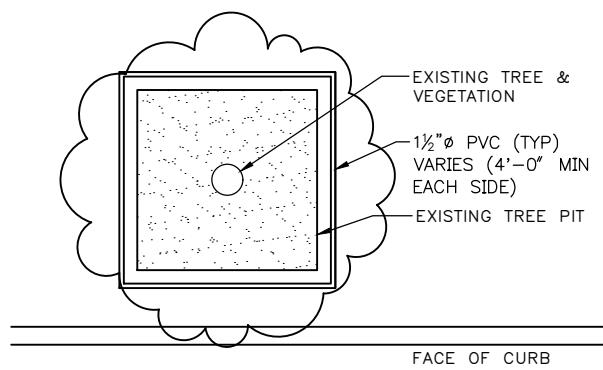

PLAN VIEW

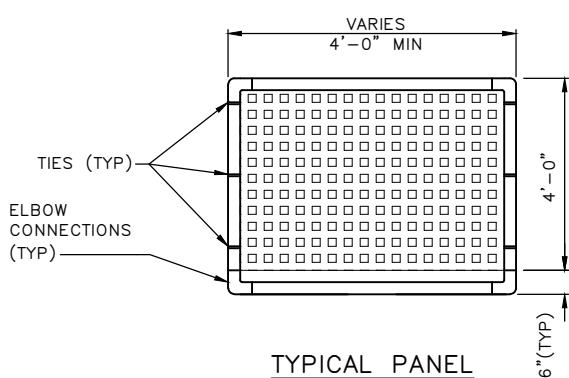

TYPICAL PANEL

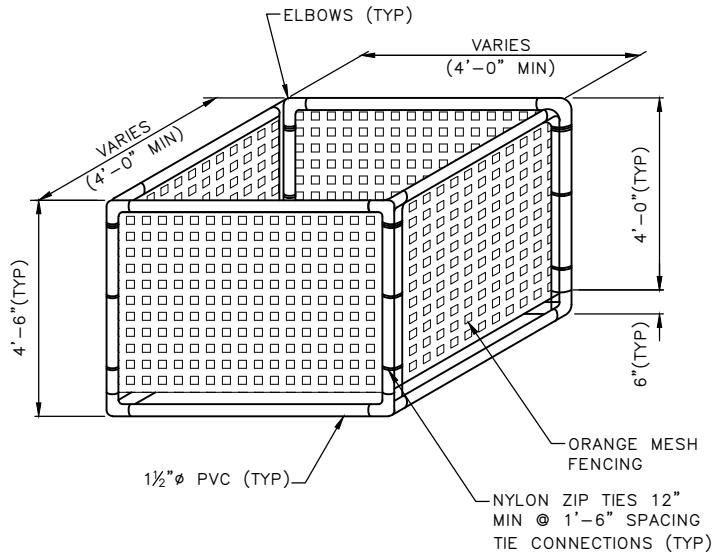

NOTES:

note 2 added

1. REUSABLE TEMPORARY PROTECTION FENCING USED TO PROTECT TREES IN TREE PITS MUST SURROUND THE ENTIRE UNPAVED TREE PIT AREA AND BE ANCHORED AND MAINTAINED IN A STABLE UPRIGHT CONDITION. SEE SECTION 8-07.3(2)b.
2. REUSABLE TEMPORARY PROTECTION FENCING USED ONLY FOR TREES IN TREE PITS AND ONLY FOR WORK LASTING 30 DAYS OR LESS. FOR TREES IN THE PLANTING STRIP AND WORK LASTING LONGER THAN 30 DAYS, SEE STD PLAN 132a.


REF STD SPEC SEC 1-07.16(2), 8-01



City of Seattle

NOT TO SCALE

REUSABLE TEMPORARY PROTECTION FENCE

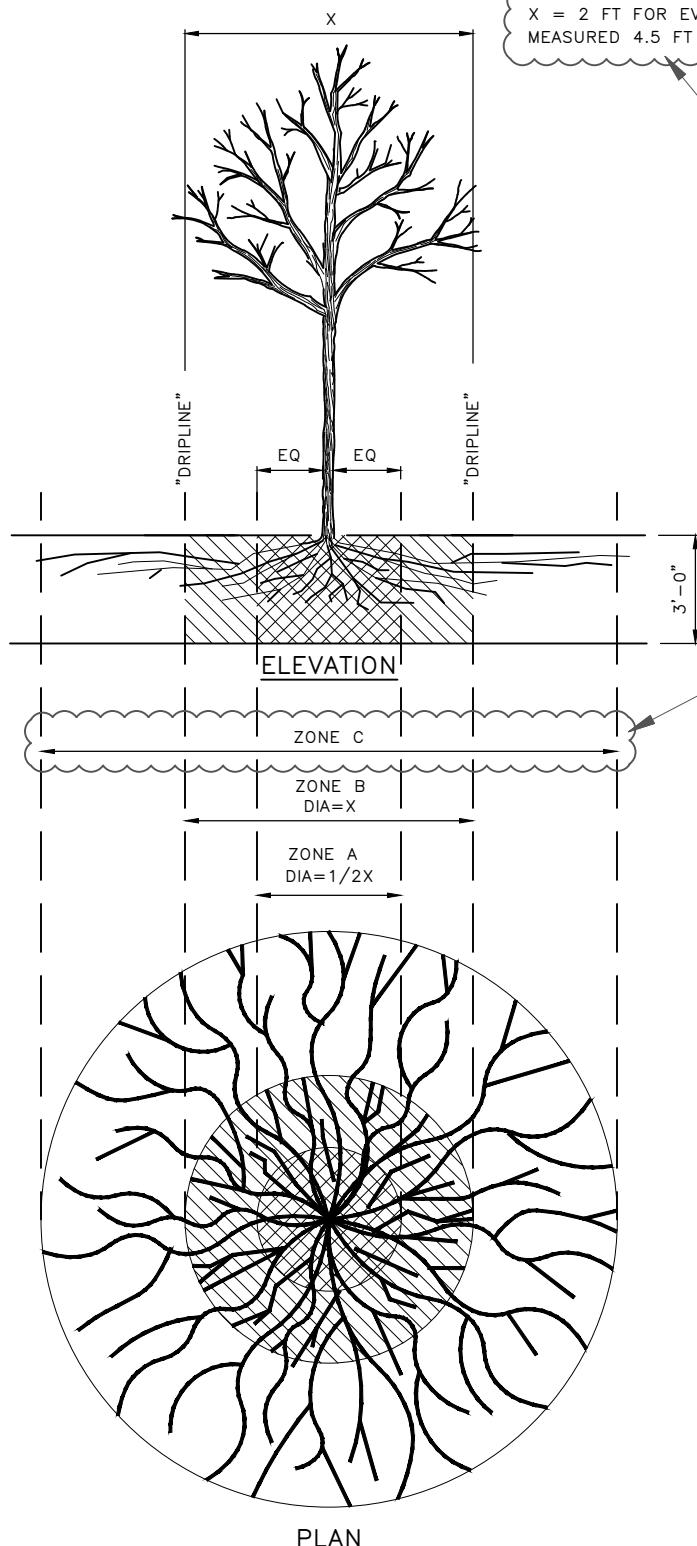

TRENCHING/EXCAVATION

ZONE A (INTERIOR CRITICAL ROOT ZONE)

1. NO DISTURBANCE ALLOWED WITHOUT SITE VISIT AND APPROVED TVSPP PER SECTION 8-01.3(2)B.
2. TUNNELING REQUIRED TO INSTALL UTILITIES 3'-0" OR DEEPER.

ZONE B (CRITICAL ROOT ZONE)

1. NO DISTURBANCE ALLOWED WITHOUT APPROVAL OF METHODS TO MINIMIZE ROOT DAMAGE.
2. NO MORE THAN 30 PERCENT OF ZONE B SHALL BE DISTURBED.
3. TUNNELING MAY BE REQUIRED FOR BELOW-GRADE IMPROVEMENTS.



ZONE C (EXTENDED ROOT ZONE)

1. DISTURBANCE ALLOWED BASED ON APPROVED PLANS. SEE NOTE.

NOTE:

SEVERANCE OF ROOTS LARGER THAN 2" REQUIRES ENGINEER'S APPROVAL.

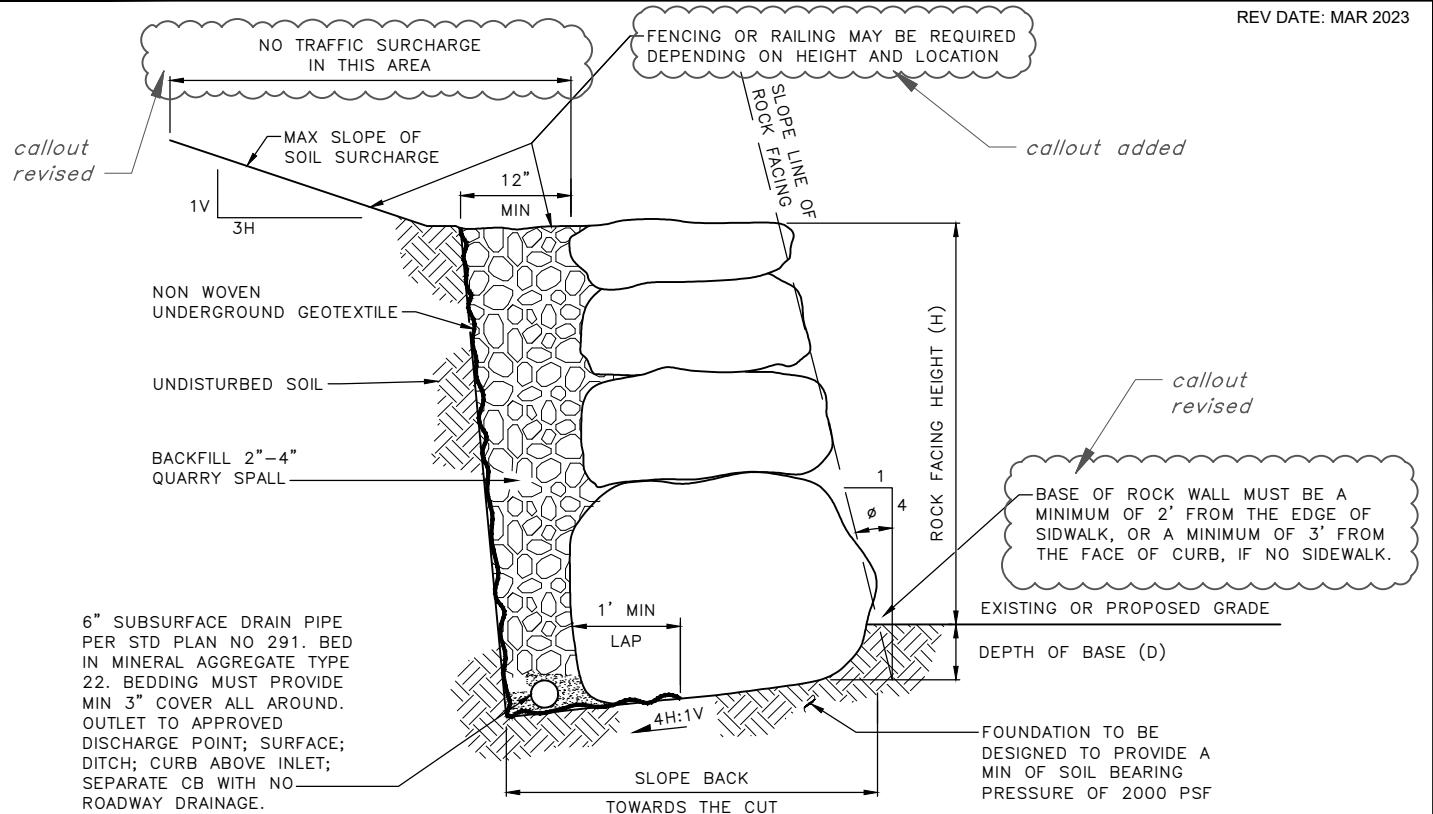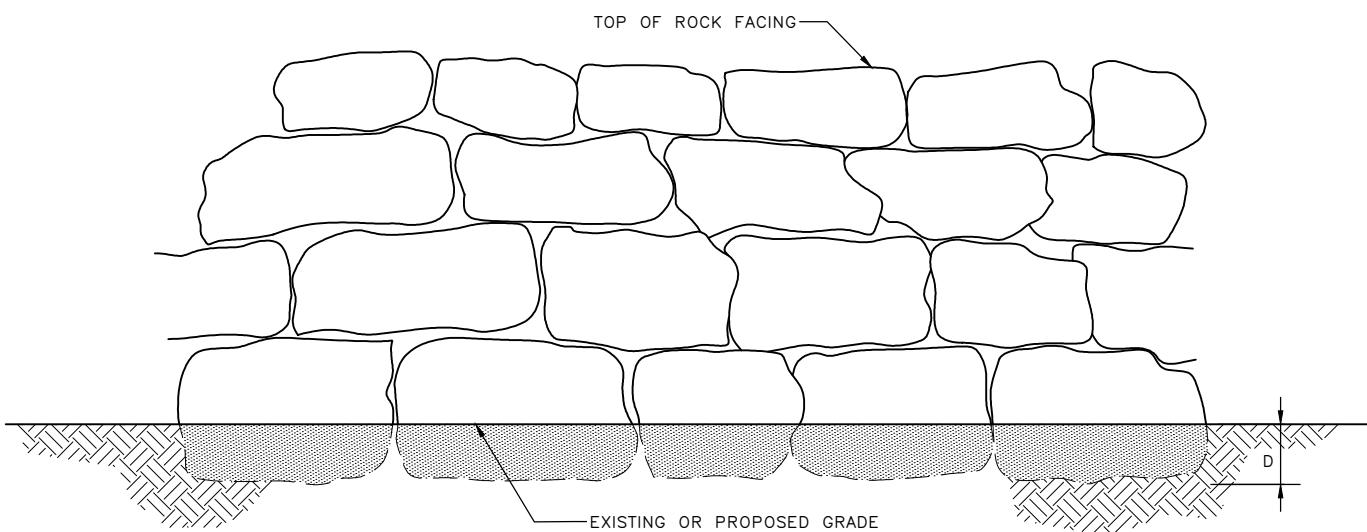

SECTIONELEVATION

		MINIMUM ROCK	
(H)	(D)	SIZE(BASE)	SIZE(TOP)
2 FEET	3 INCHES	2-MAN	1-MAN
4 FEET	6 INCHES	3-MAN	2-MAN
6 FEET	9 INCHES	4-MAN	2-MAN
8 FEET	12 INCHES	5-MAN	2-MAN

$\phi = 14^\circ \pm 1^\circ$


REF STD SPEC SEC 2-13



City of Seattle

NOT TO SCALE

ROCK FACING

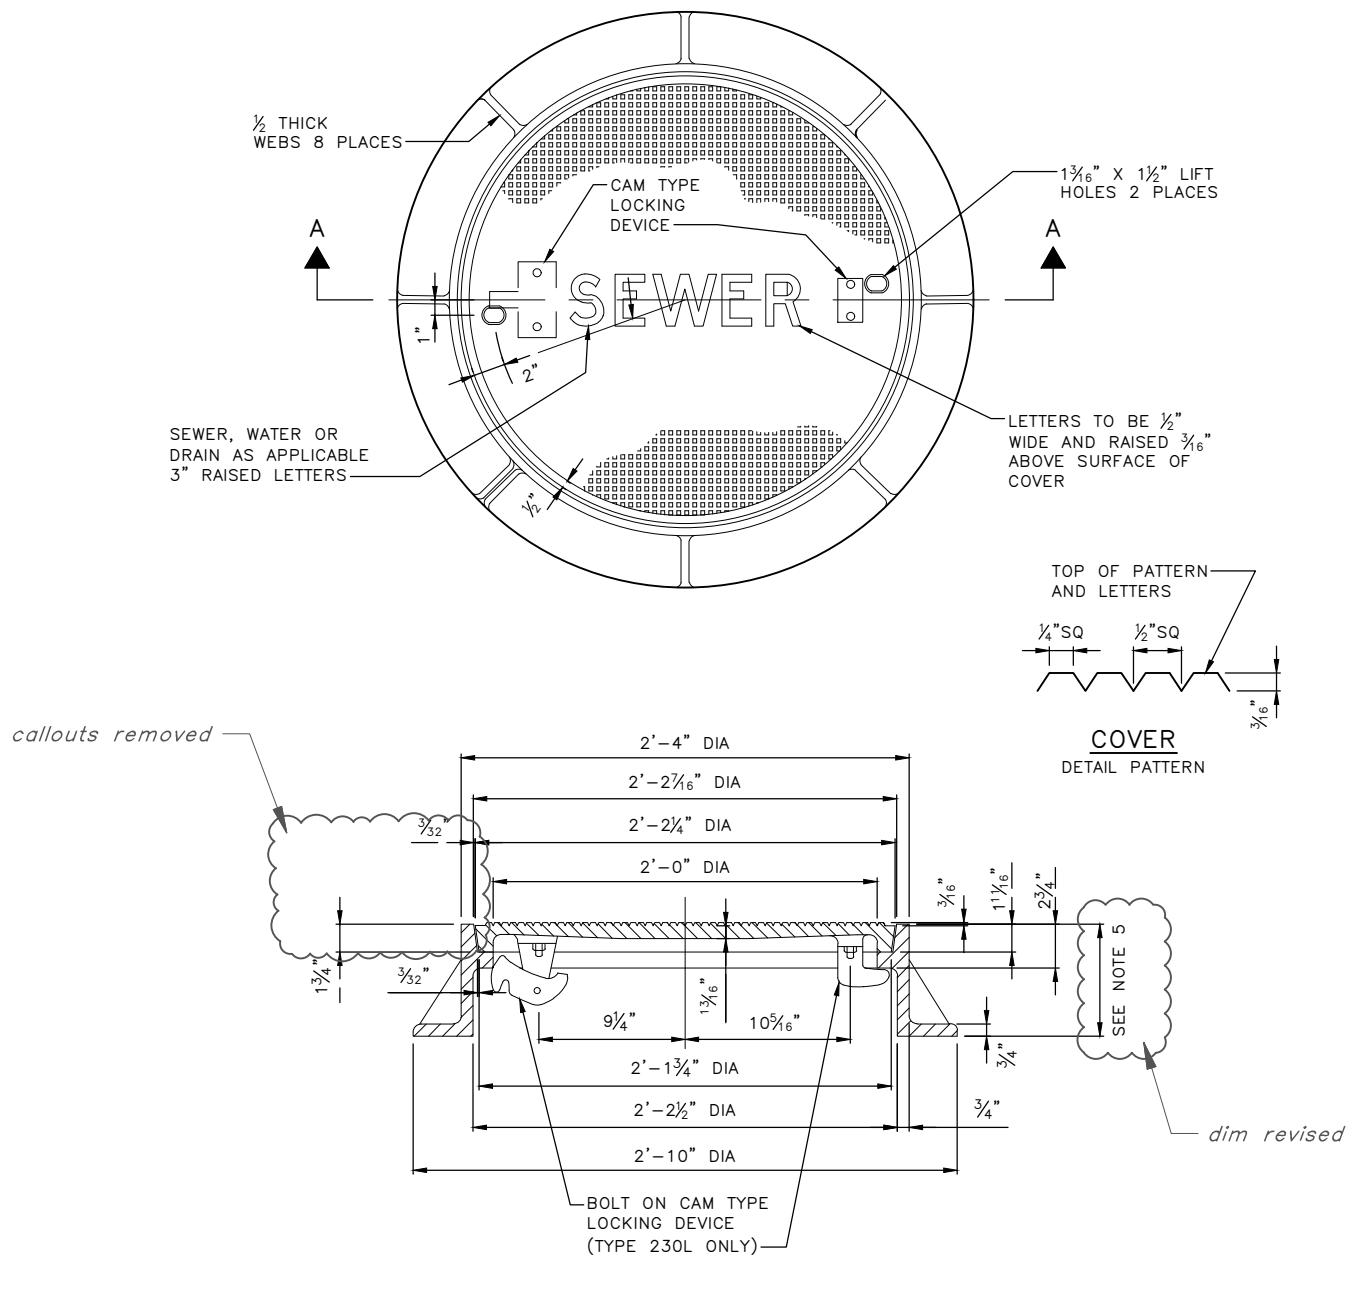

REF STD SPEC SEC 7-05, 9-12



City of Seattle

NOT TO SCALE

2'-0" DIAMETER
FRAME & COVER


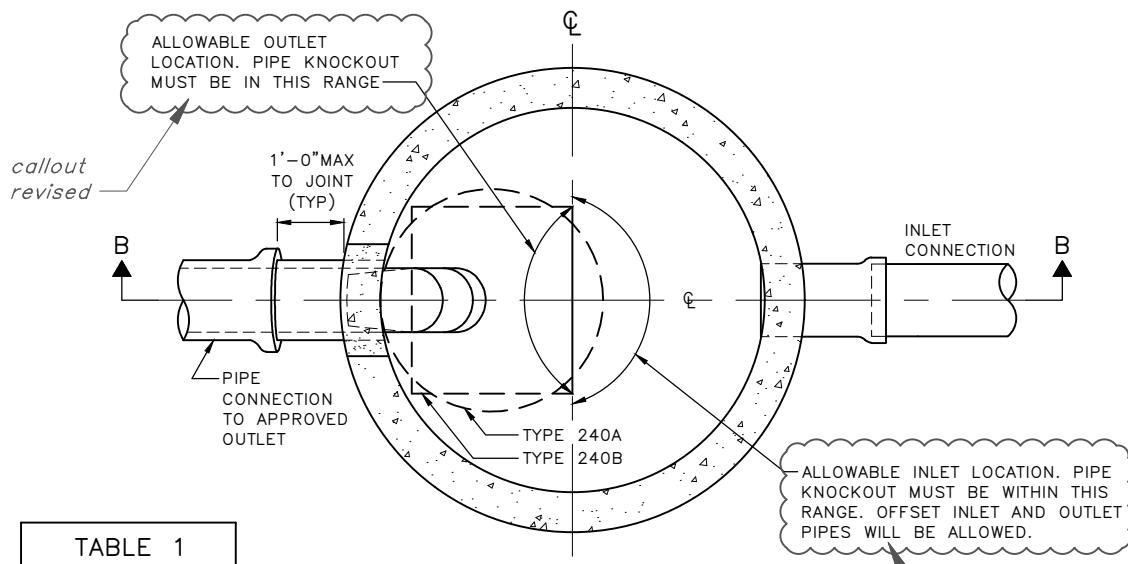


TABLE 1

6"φ	8" MIN 1'-4" MAX
8"φ	10" MIN 1'-4" MAX
12"φ	1'-3" MIN 2'-0" MAX

SECTION A-A

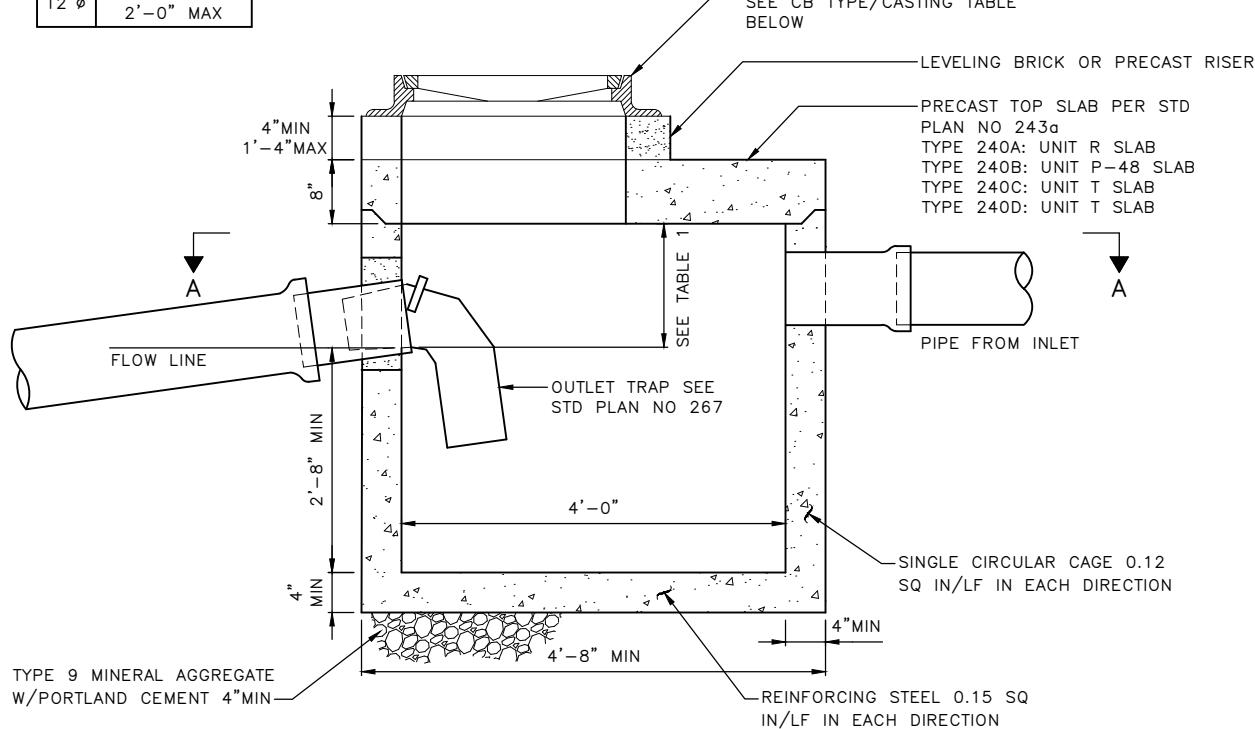

SECTION B-B

NOTES:

1. FRAME & GRATE OR FRAME & COVER MUST BE LOCATED OVER TRAP.
2. INVERT OF INLET PIPE MUST BE 2" MIN ABOVE INVERT OF OUTLET PIPE.
3. SEE STD PLAN 261 FOR ALLOWABLE OUTLET LOCATIONS.

CB TYPE	CASTING	
	FRAME	COVER
240A	PER STD PLAN 230	PER STD PLAN 230
240B	PER STD PLAN 264	PER STD PLAN 264
240C	PER STD PLAN 262	PER STD PLAN 265
240D	PER STD PLAN 263A	PER STD PLAN 265


REF STD SPEC SEC 7-05




City of Seattle

NOT TO SCALE

TYPE 240 CATCH BASIN

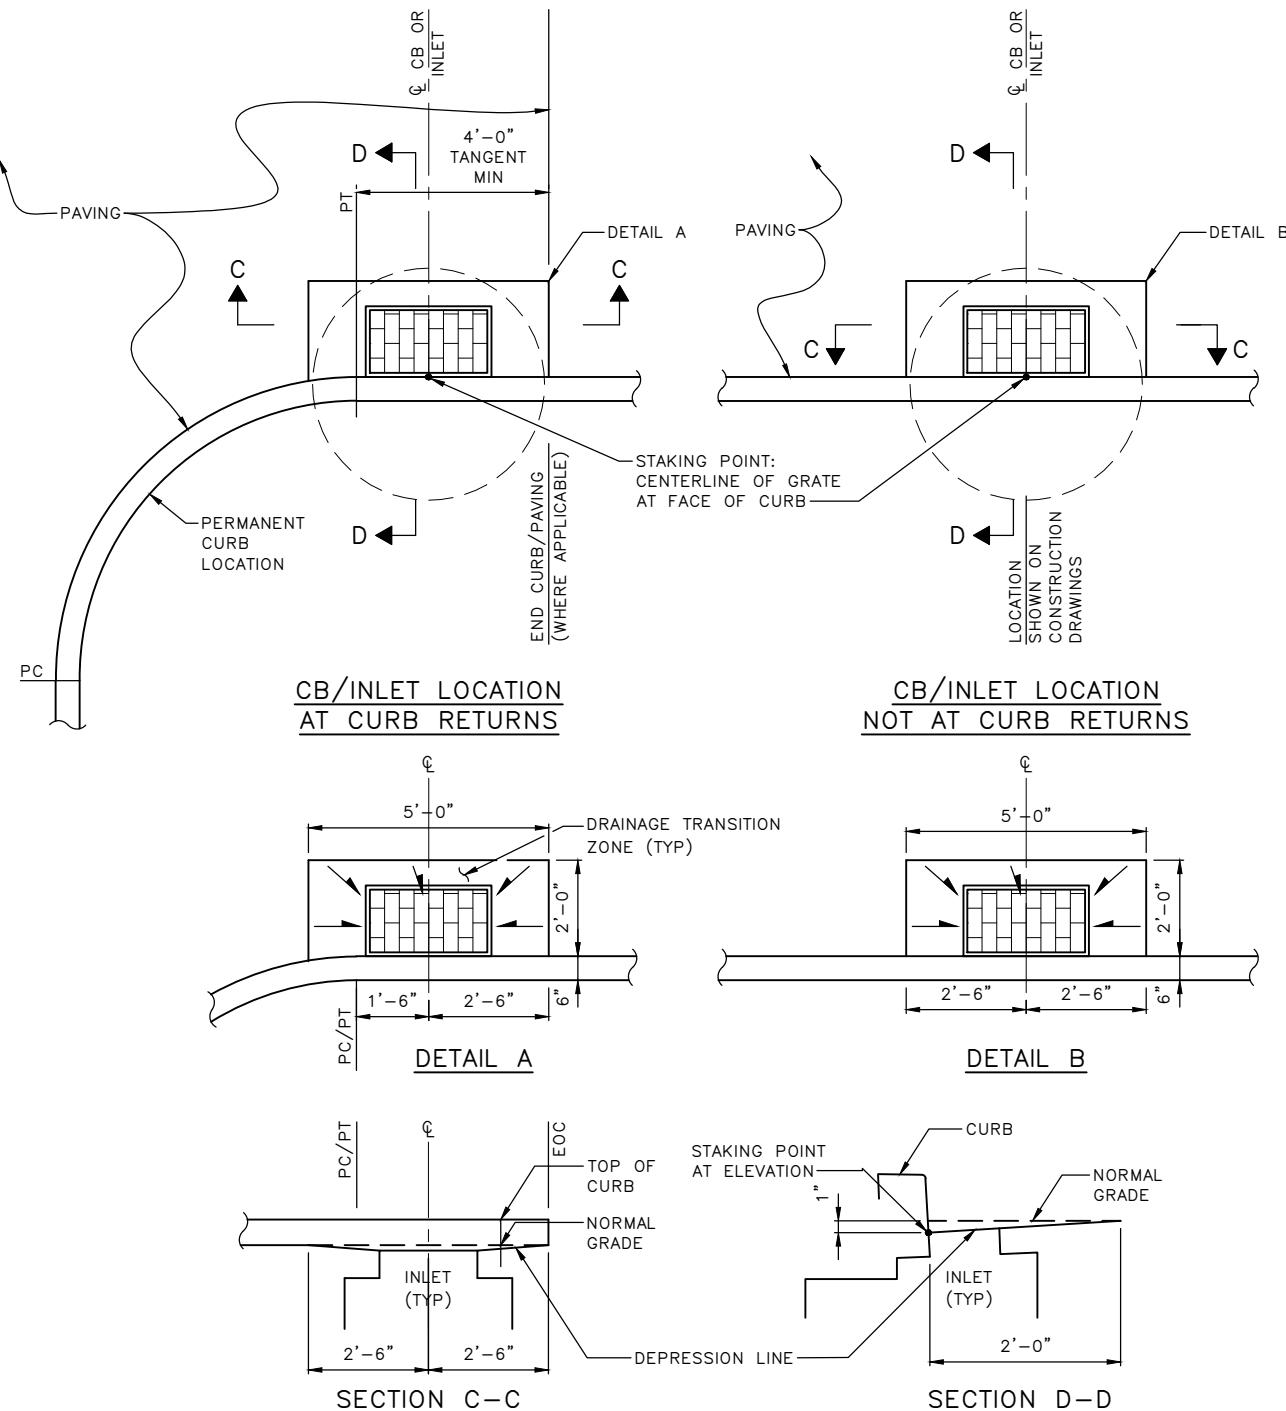


REV DATE: MAR 2021

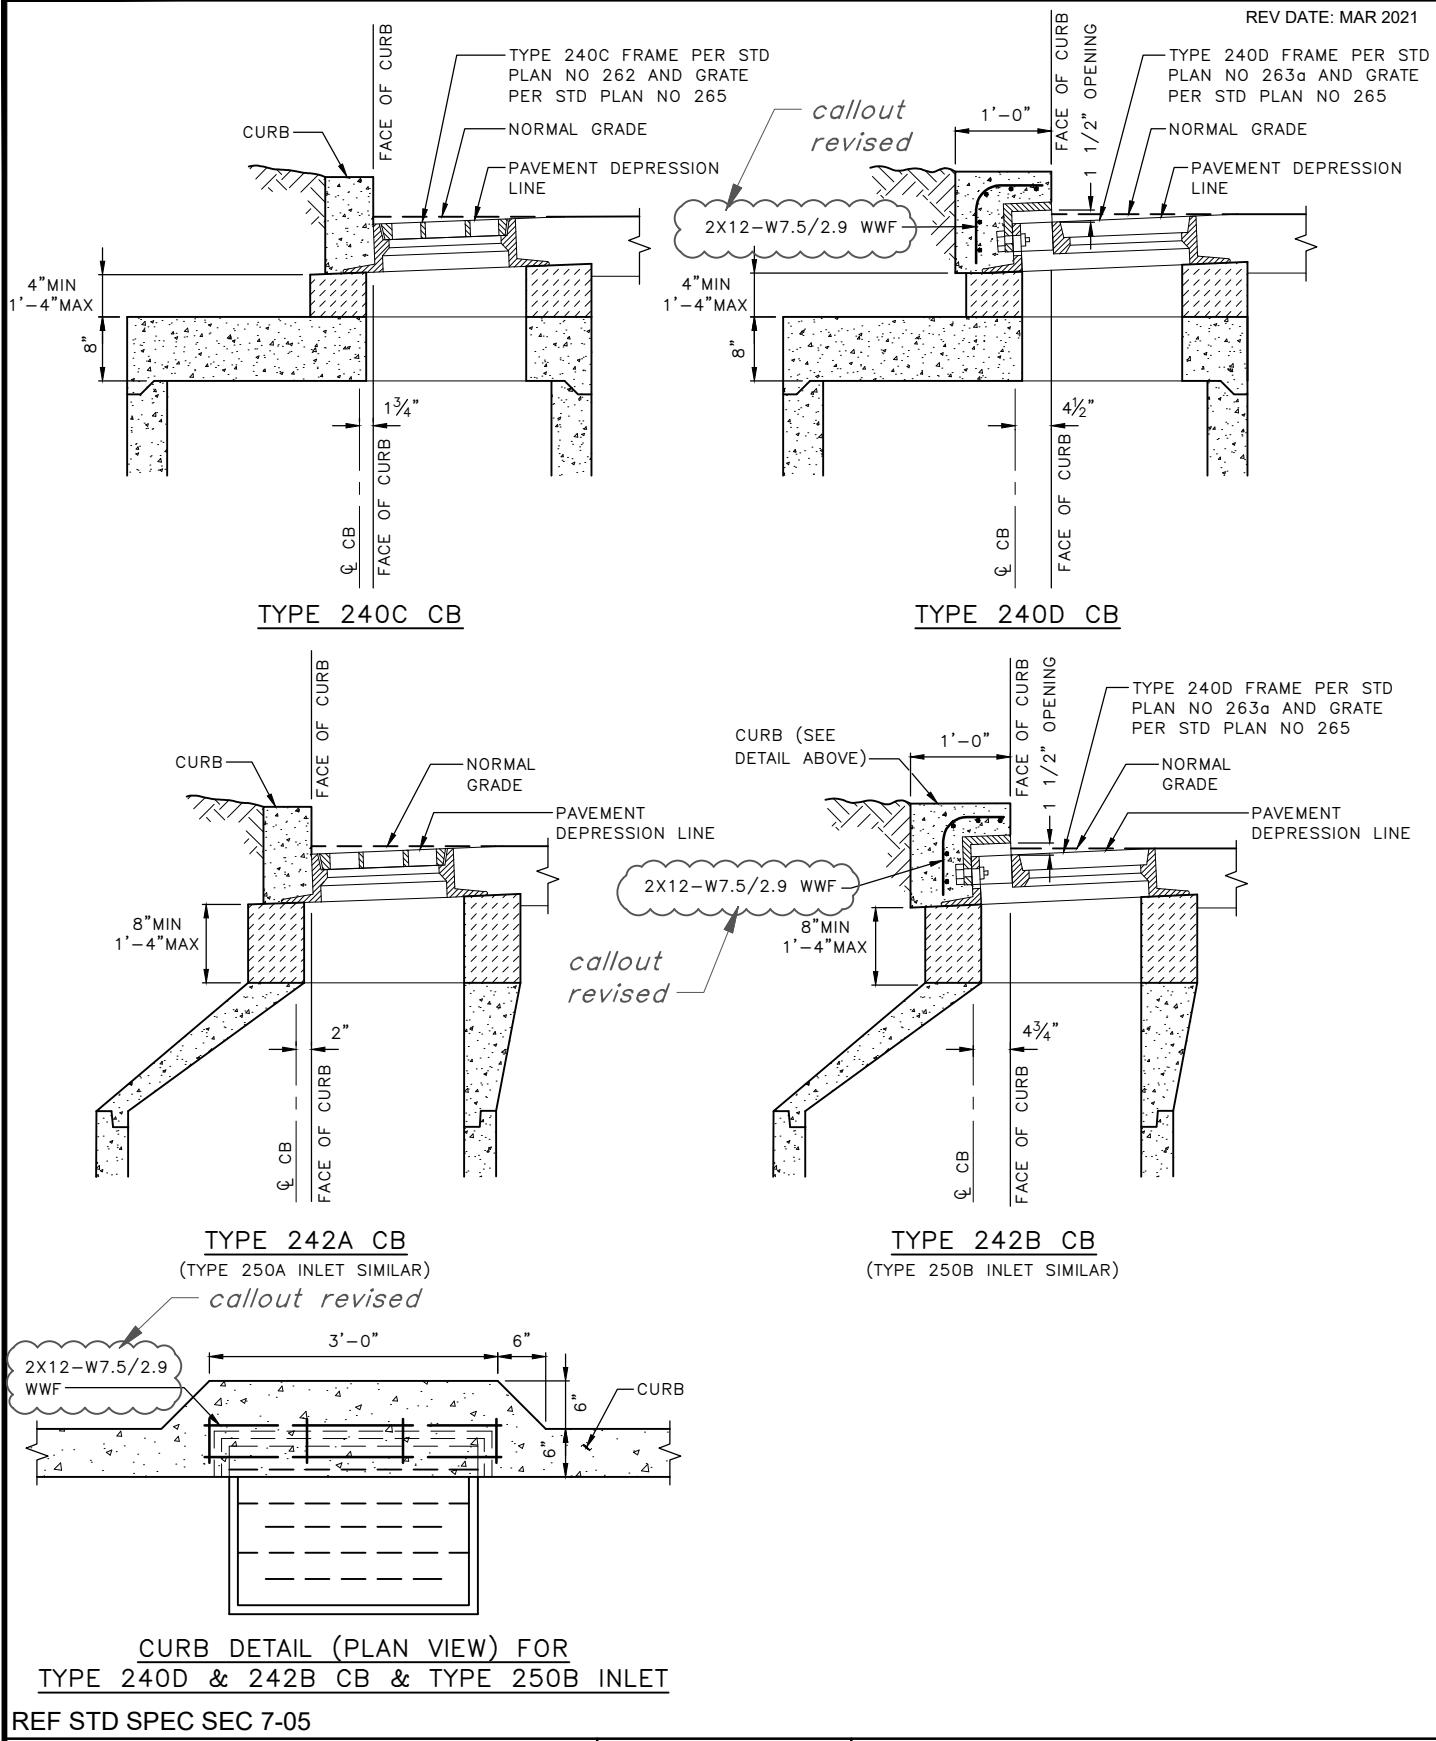

City of Seattle

NOT TO SCALE

CATCH BASIN &
INLET INSTALLATION

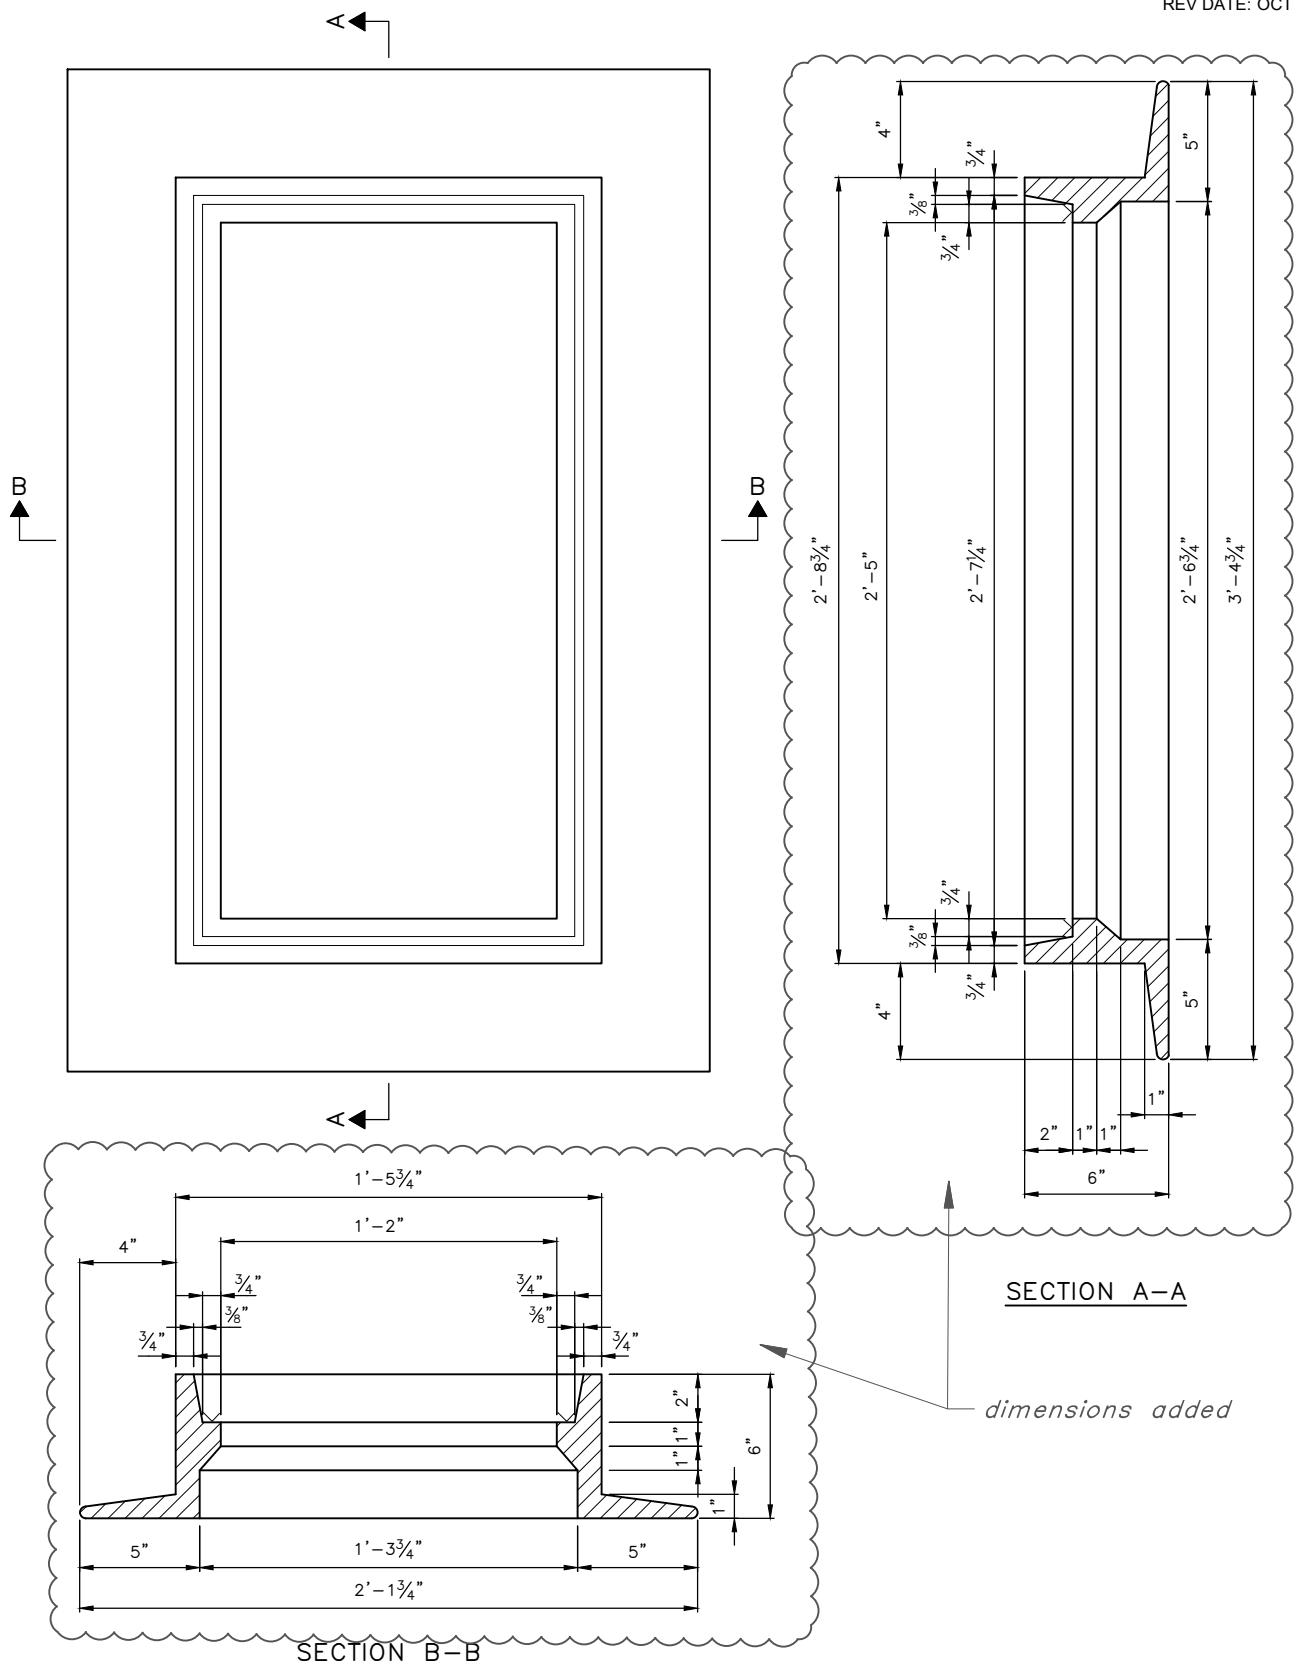


REF STD SPEC SEC 9-12



City of Seattle

NOT TO SCALE

TYPE 262 INLET FRAME

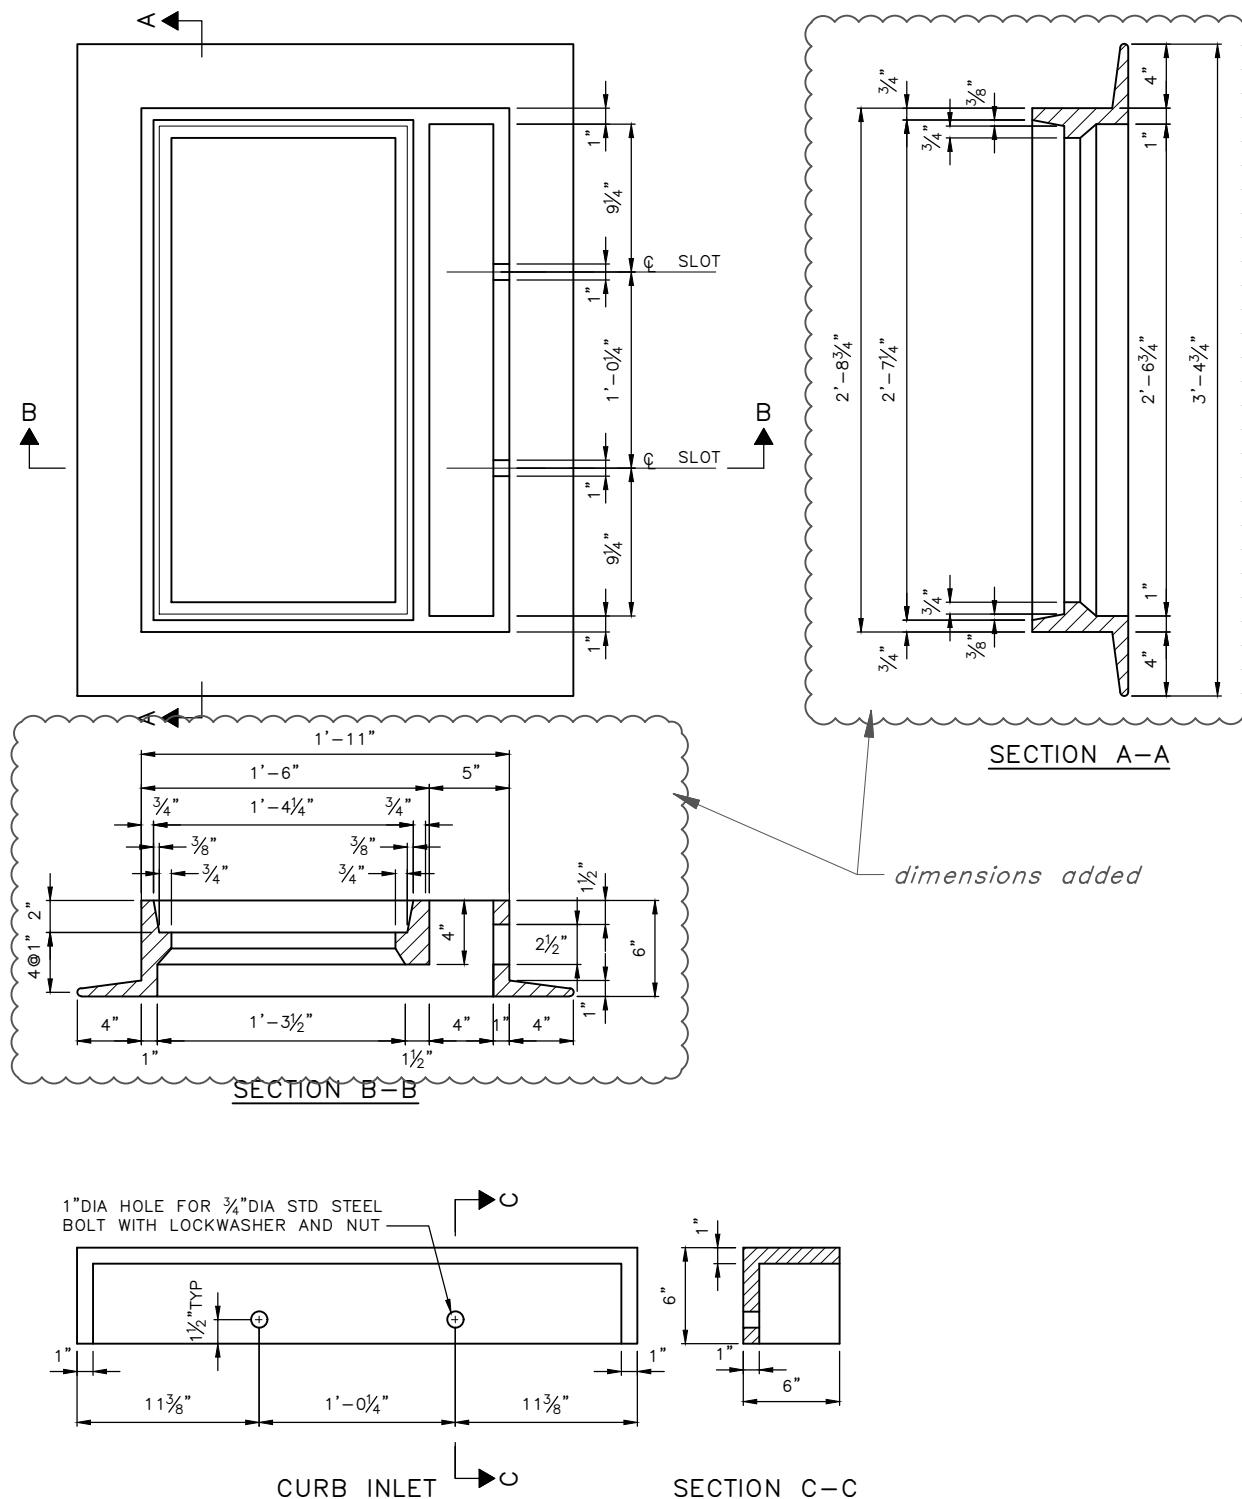


REF STD SPEC SEC 9-12



City of Seattle

NOT TO SCALE


TYPE 263 INLET FRAME
AND HOOD

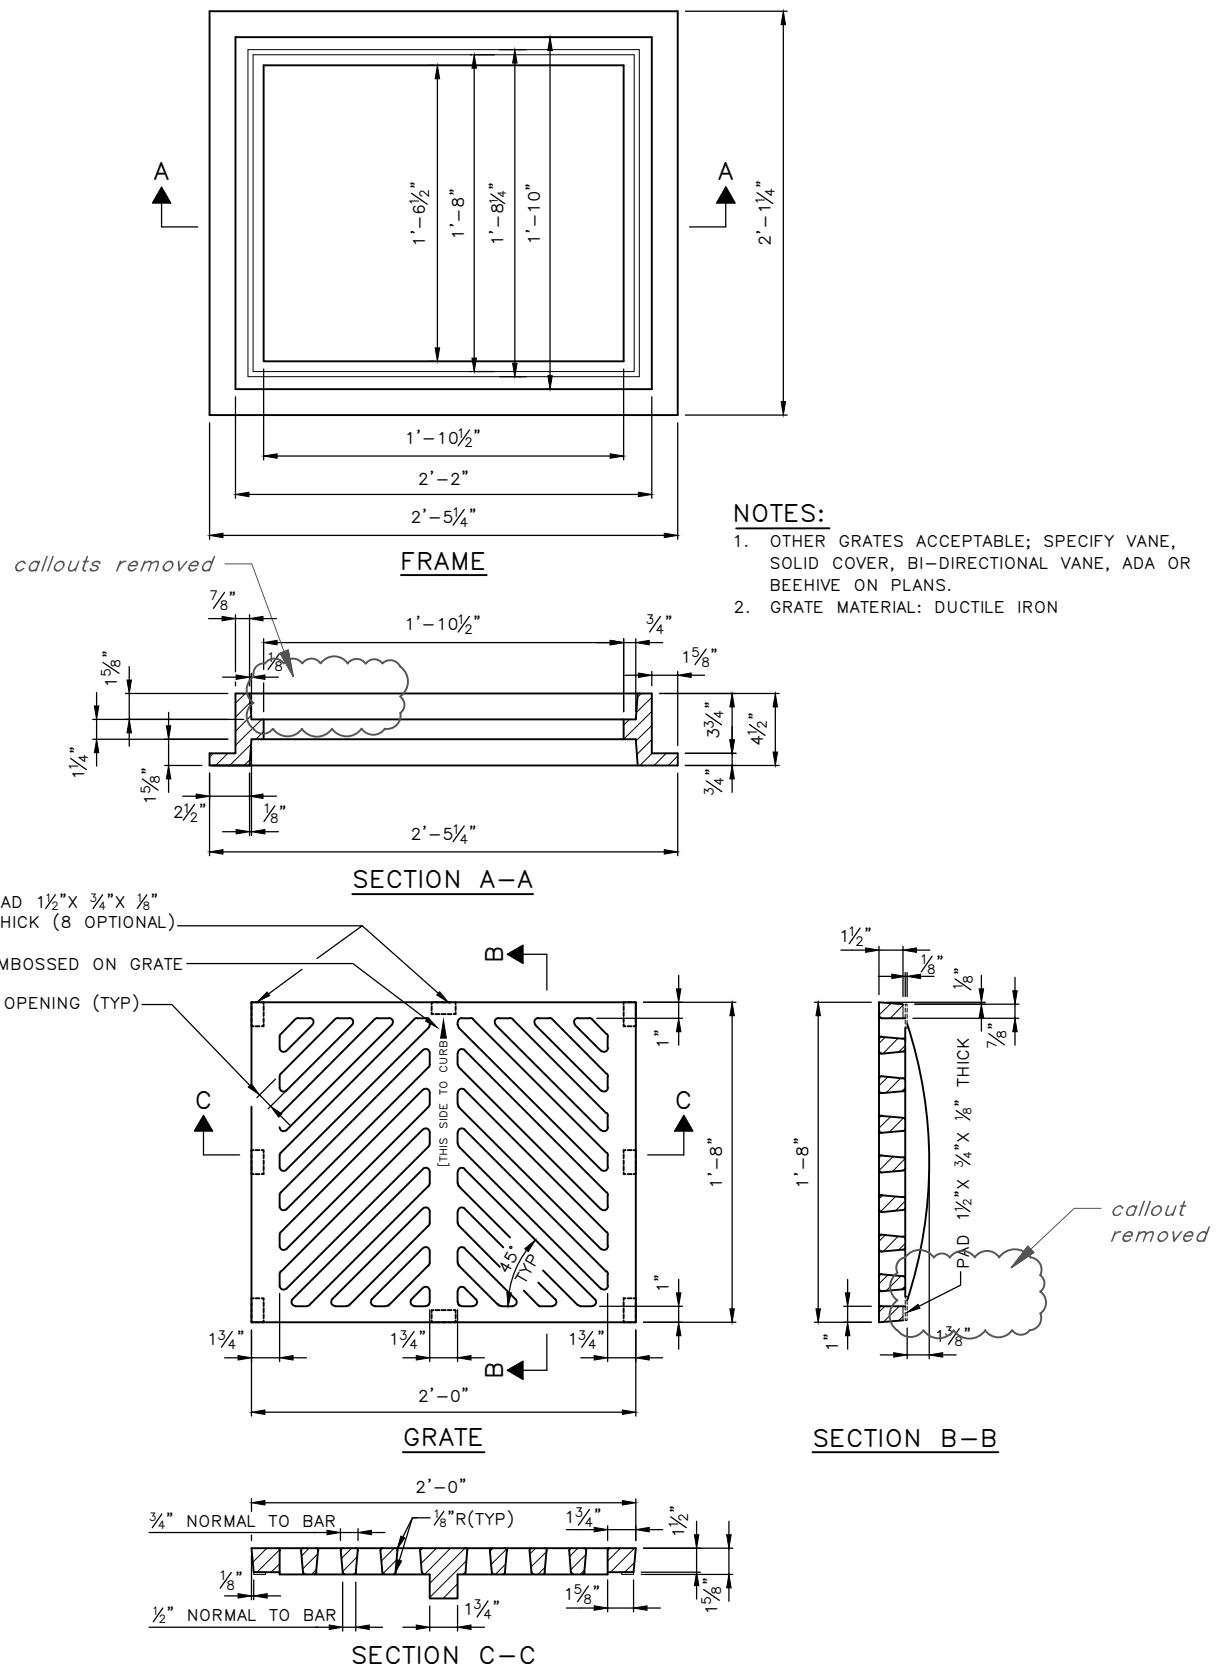

City of Seattle

NOT TO SCALE

INLET FRAME & GRATE

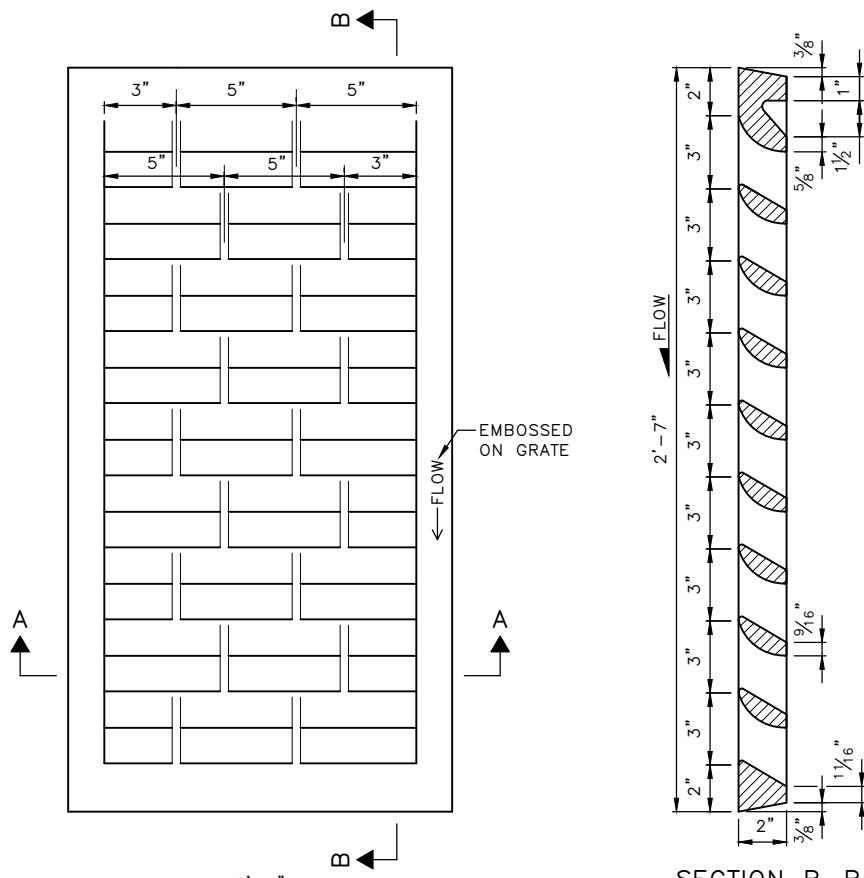


SECTION B-B


NOTES:

1. OTHER GRATES ACCEPTABLE; SPECIFY VANE, SOLID COVER, BI-DIRECTIONAL VANE, ADA OR BEEHIVE ON PLANS.
2. GRATE MATERIAL: DUCTILE IRON
3. FOR USE WITH TYPE 262 & 263 INLET FRAMES.

notes added

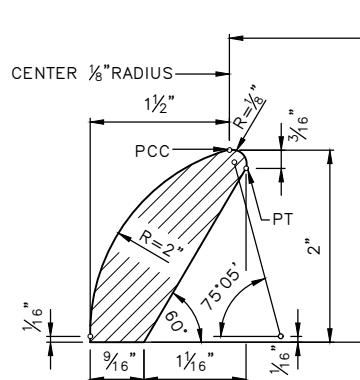

VANE DETAIL

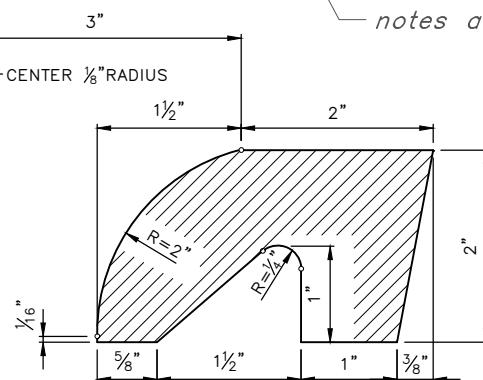

END DETAIL



REF STD SPEC SEC 7-05




City of Seattle

NOT TO SCALE

VANED GRATE

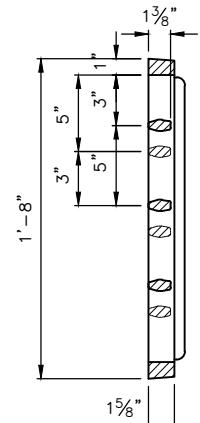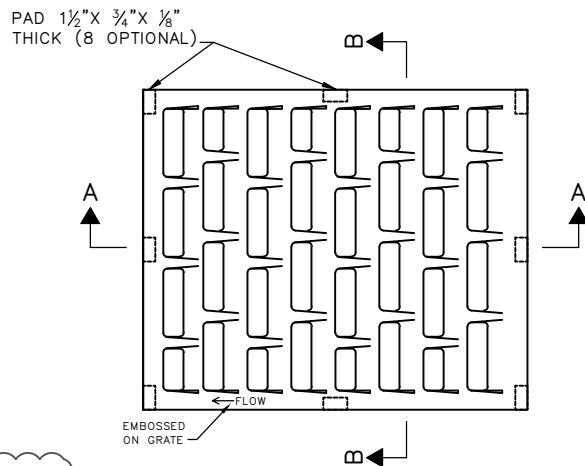



SECTION B-B

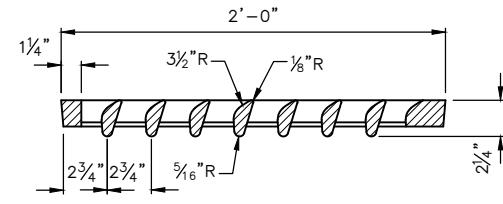


SECTION A-A

DIRECTIONAL VANCED GRATE

TO BE USED WITH FRAME 264

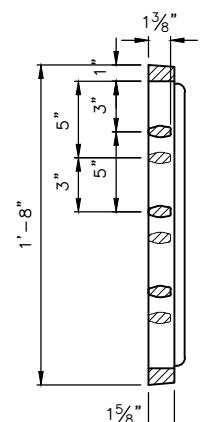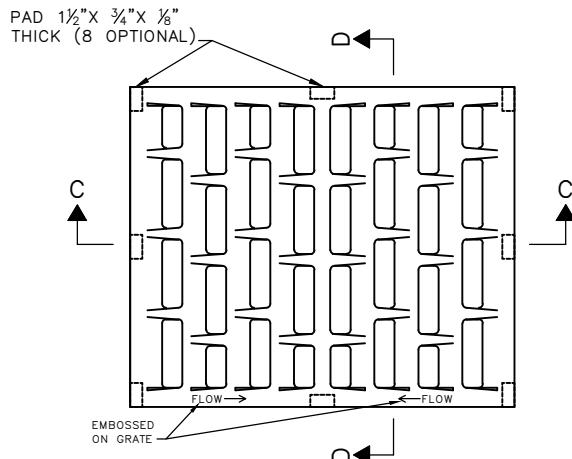

SECTION D-D

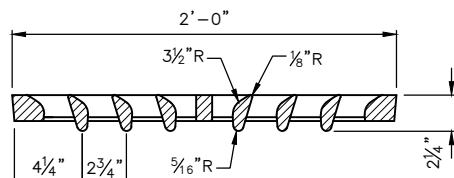

SECTION C-C

BI-DIRECTIONAL VANCED GRATE

TO BE USED WITH FRAME 264


REF STD SPEC SEC 7-05



City of Seattle

NOT TO SCALE

VANCED GRATES

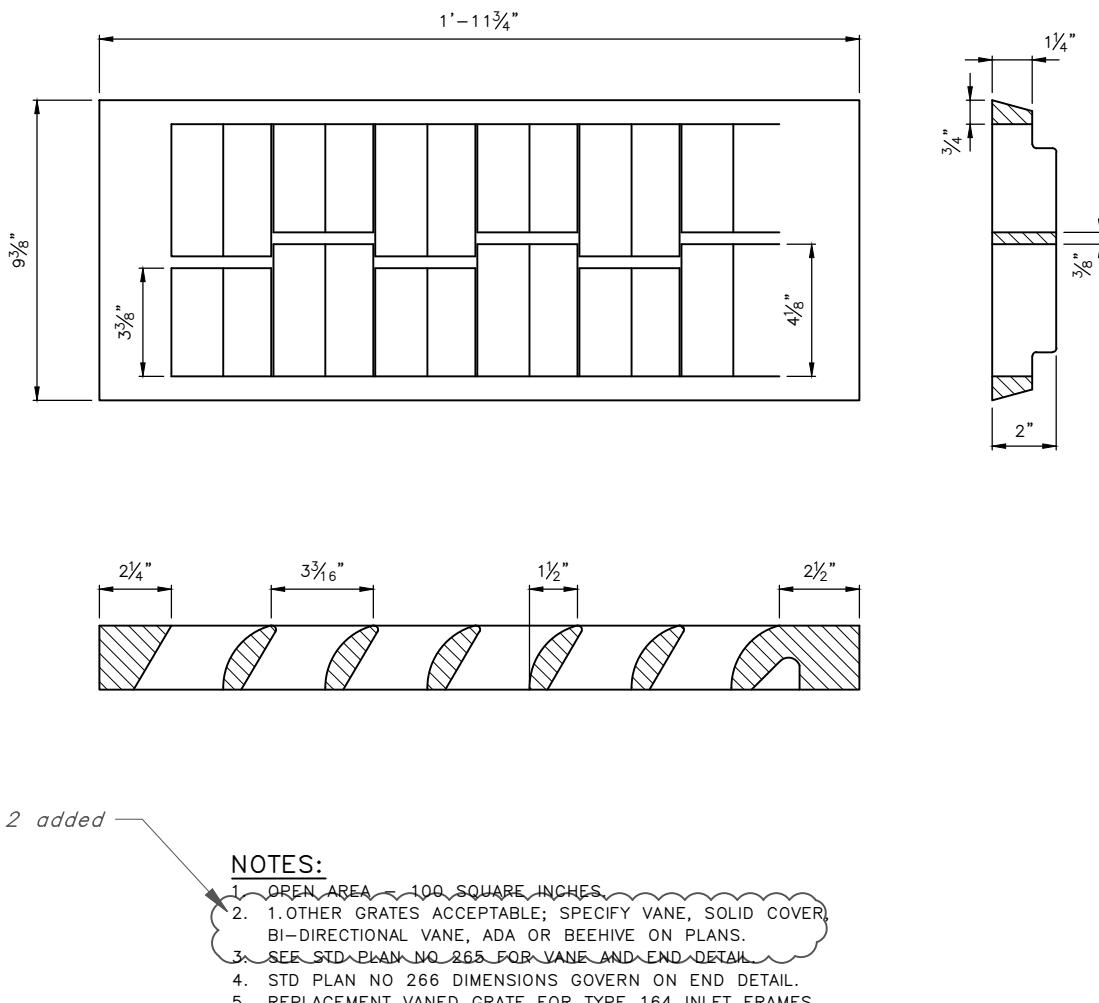



REF STD SPEC SEC 7-20.3(6), 9-12



City of Seattle

NOT TO SCALE

TYPE 266 REPLACEMENT
VANED GRATE

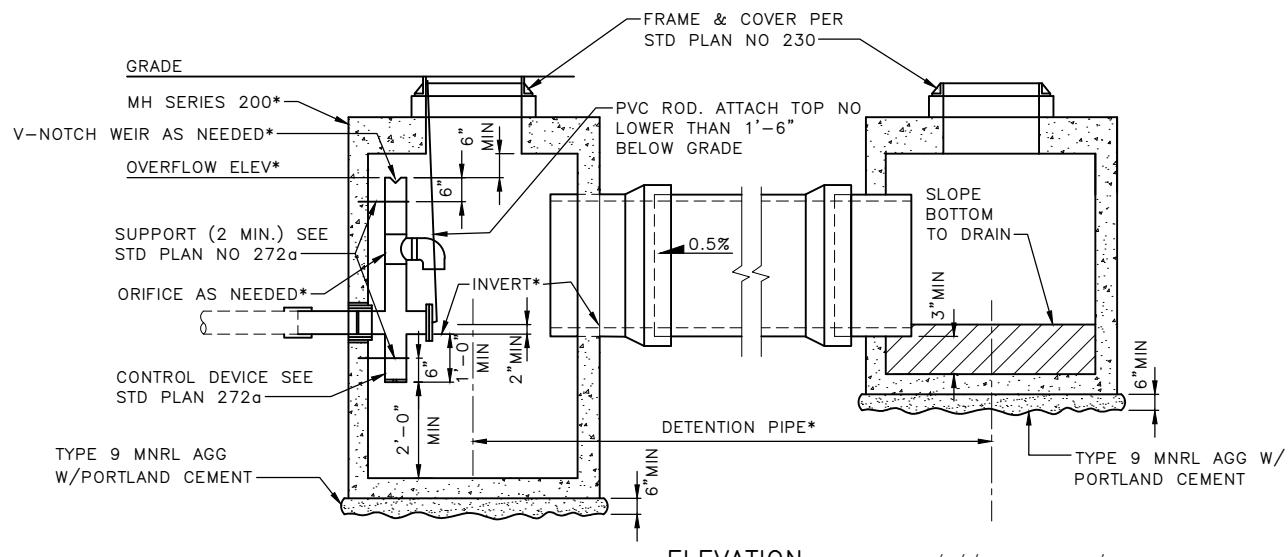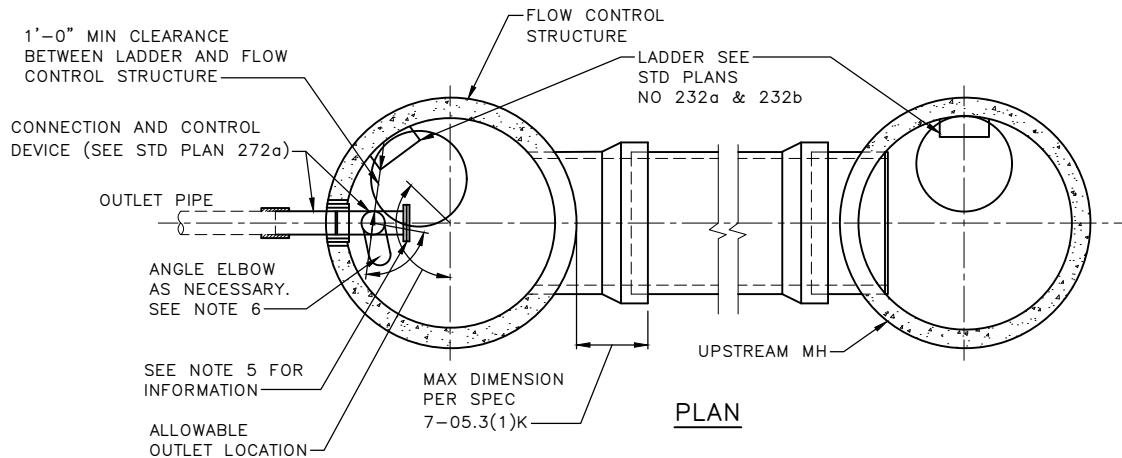

NOTES:

- DETENTION PIPE MATERIAL MUST BE AS SHOWN ON THE APPROVED CONSTRUCTION DRAWINGS. MATERIALS THAT MAY BE APPROVED FOR USE IN THE ROW INCLUDE:
 - DUCTILE IRON PIPE (DIP)
 - REINFORCED CONCRETE PIPE (RCP)
 - POLYPROPYLENE PIPE (PP DETENTION)
 - STEEL REINFORCED POLYETHYLENE PIPE (STL REINF PE DETENTION). ONLY MANUFACTURER SUPPLIED TEES MUST BE USED FOR CONNECTIONS.
- BEDDING FOR DETENTION PIPE MUST BE CLASS B. DIP AND RCP MUST BE BEDDED IN MINERAL AGGREGATE TYPE 9. FLEXIBLE PIPE MUST BE BEDDED IN MINERAL AGGREGATE TYPE 22.
- INTERMEDIATE MHS WILL BE REQUIRED FOR DETENTION PIPE LENGTHS GREATER THAN 350LF.
- OUTLET PIPE MUST CONNECT TO MH ON MAINLINE.
- STRUCTURE DESIGN MUST BE MODIFIED FOR PRIVATE SYSTEM WITH EXCLUSION OF SHEAR GATE
- ROTATE ELBOW RESTRICTOR CLEAR OF ACCESS OPENING.
- FRAME LADDER AND STEPS OFFSET:
 - CLEAN OUT IS VISIBLE FROM TOP
 - CLIMB DOWN SPACE IS CLEAR OF RISER AND CLEAN OUT GATE
 - MH OPENING MUST NOT BE PLACED DIRECTLY OVER THE TOP OF INLET PIPE
- THE MAINTENANCE HOLES MUST BE SIZED FOR THE OUTSIDE DIAMETER OF THE DETENTION PIPE, WHICH WILL VARY DEPENDING ON THE DETENTION PIPE MATERIAL.

note 8 added

** note moved to above, ** note converted to Note 8


REF STD SPEC SEC 7-16



City of Seattle

NOT TO SCALE

FLOW CONTROL STRUCTURE
WITH DETENTION PIPE

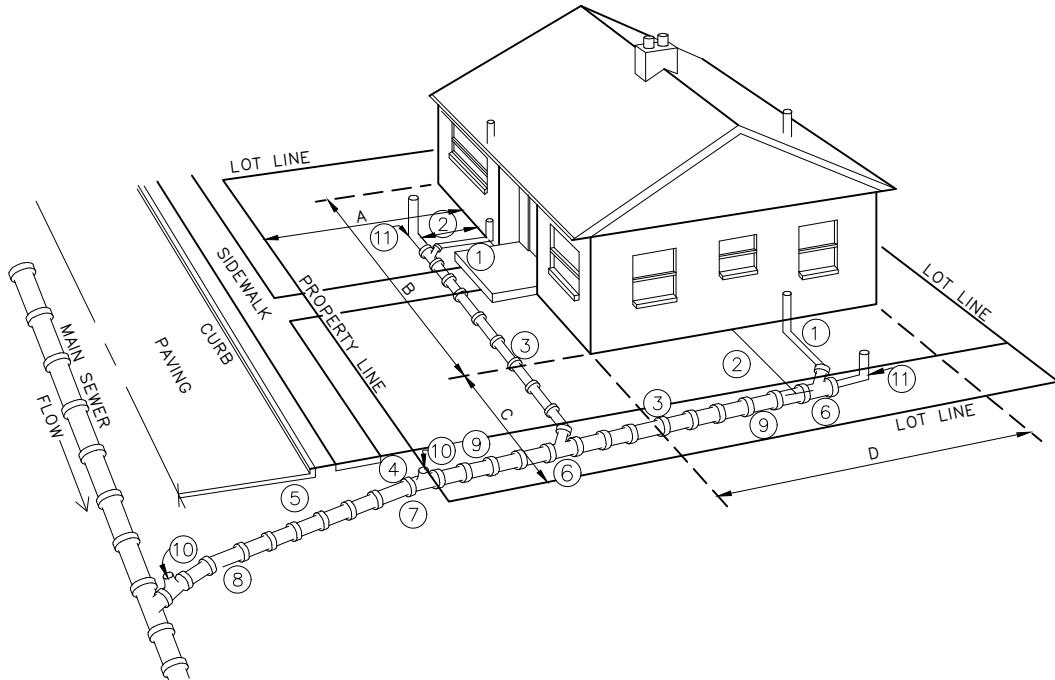**NOTES:**

1. ALL SANITARY PLUMBING OUTLETS MUST BE CONNECTED TO THE SANITARY SEWER OR COMBINED SEWER.
2. 2'-6"MIN DISTANCE FROM HOUSE, EXCEPT FOR SOIL PIPE CONNECTION.
3. 1'-6"MIN COVER OF PIPE.
4. 2'-6"MIN COVER AT PROPERTY LINE.
5. 5'-0"MIN COVER AT CURB LINE.
6. LAY PIPE IN STRAIGHT LINE BETWEEN BENDS. MAKE ALL CHANGES IN GRADE OR LINE WITH BENDS OR WYES.
7. STANDARD 4" TO 6" INCREASER.
8. 6" SEWER PIPE: MIN SIZE IN STREET, AND ELSEWHERE AS DIRECTED. 2% MIN GRADE, 100% MAX.
9. 4" SEWER PIPE: MIN SIZE ON PROPERTY. 2% MIN GRADE, 100% (45°) MAX.
10. TEST "T" WITH PLUG
11. CLEANOUT AT UPSTREAM END OF SIDE SEWER.

12. CONSTRUCTION IN STREET MUST BE DONE BY A REGISTERED SIDE SEWER CONTRACTOR.

13. ALL CONSTRUCTION MUST BE IN ACCORDANCE WITH THE CURRENT SIDE SEWER ORDINANCE.




DIMENSIONS:

A = FRONT YARD SETBACK
 B = LENGTH OF HOUSE
 C = SIDE YARD SETBACK
 D = WIDTH OF HOUSE

notes added

dimensions added



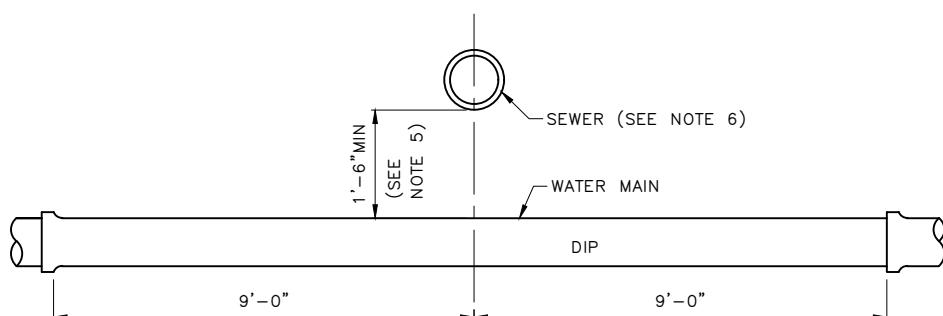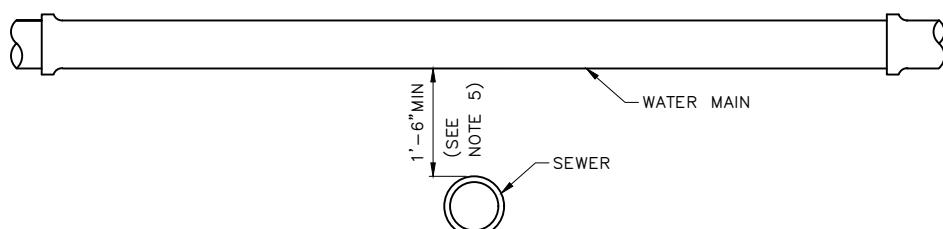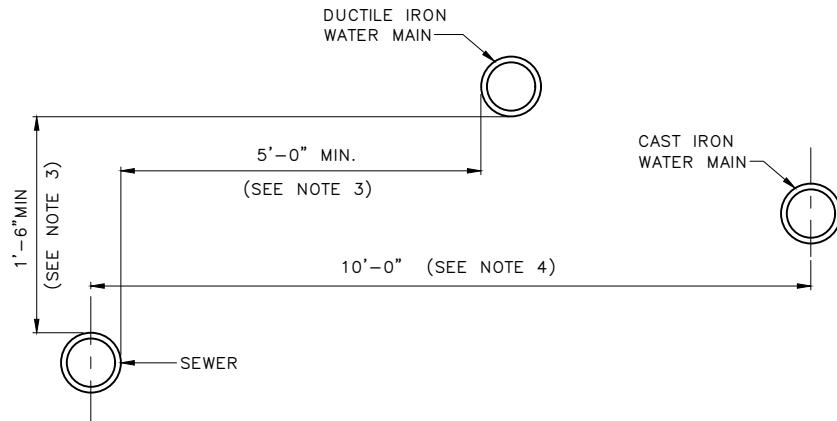

STANDARD SINGLE 18'-0" NOMINAL LENGTH DUCTILE IRON WATER MAIN SECTION CENTERED AT THE POINT OF CROSSING

NOTES:

1. EXCEPTIONS TO STD PLAN NO 286a & 286b MUST BE APPROVED BY SEATTLE PUBLIC UTILITIES.
2. "SEWER" INCLUDES SANITARY SEWER, COMBINED SEWER AND SIDE SEWER.
3. WHERE MINIMUM CLEARANCES CANNOT BE MET, SEWER MUST BE CONSTRUCTED OF MATERIALS AND WITH JOINTS THAT ARE EQUIVALENT TO WATER MAIN STANDARDS INCLUDING WATER MAIN PRESSURE TESTING REQUIREMENTS.
4. NO VERTICAL CLEARANCE REQUIRED.
5. IF MINIMUM VERTICAL SEPARATION CANNOT BE MET, WATER MAIN MUST BE A STANDARD SINGLE 18'-0" NOMINAL LENGTH DUCTILE IRON WATER MAIN SECTION CENTERED AT THE POINT OF CROSSING.
6. SEWER MUST HAVE ADEQUATE FOUNDATION SUPPORT TO PREVENT SETTLEMENT ON THE WATER MAIN AND TO PREVENT DEFLECTION OF WATER MAIN JOINTS.
7. CROSSINGS AT AN ANGLE BETWEEN 90° AND 45° MAY OCCUR BETWEEN 9'-0" AND 6'-0" OF WATER MAIN JOINT. FOR CROSSINGS LESS THAN 45°, SEE NOTE 1.

note revised


REF STD SPEC SEC 1-07.17, 7-11



City of Seattle

NOT TO SCALE


SEWER & WATER SPACING & CLEARANCES

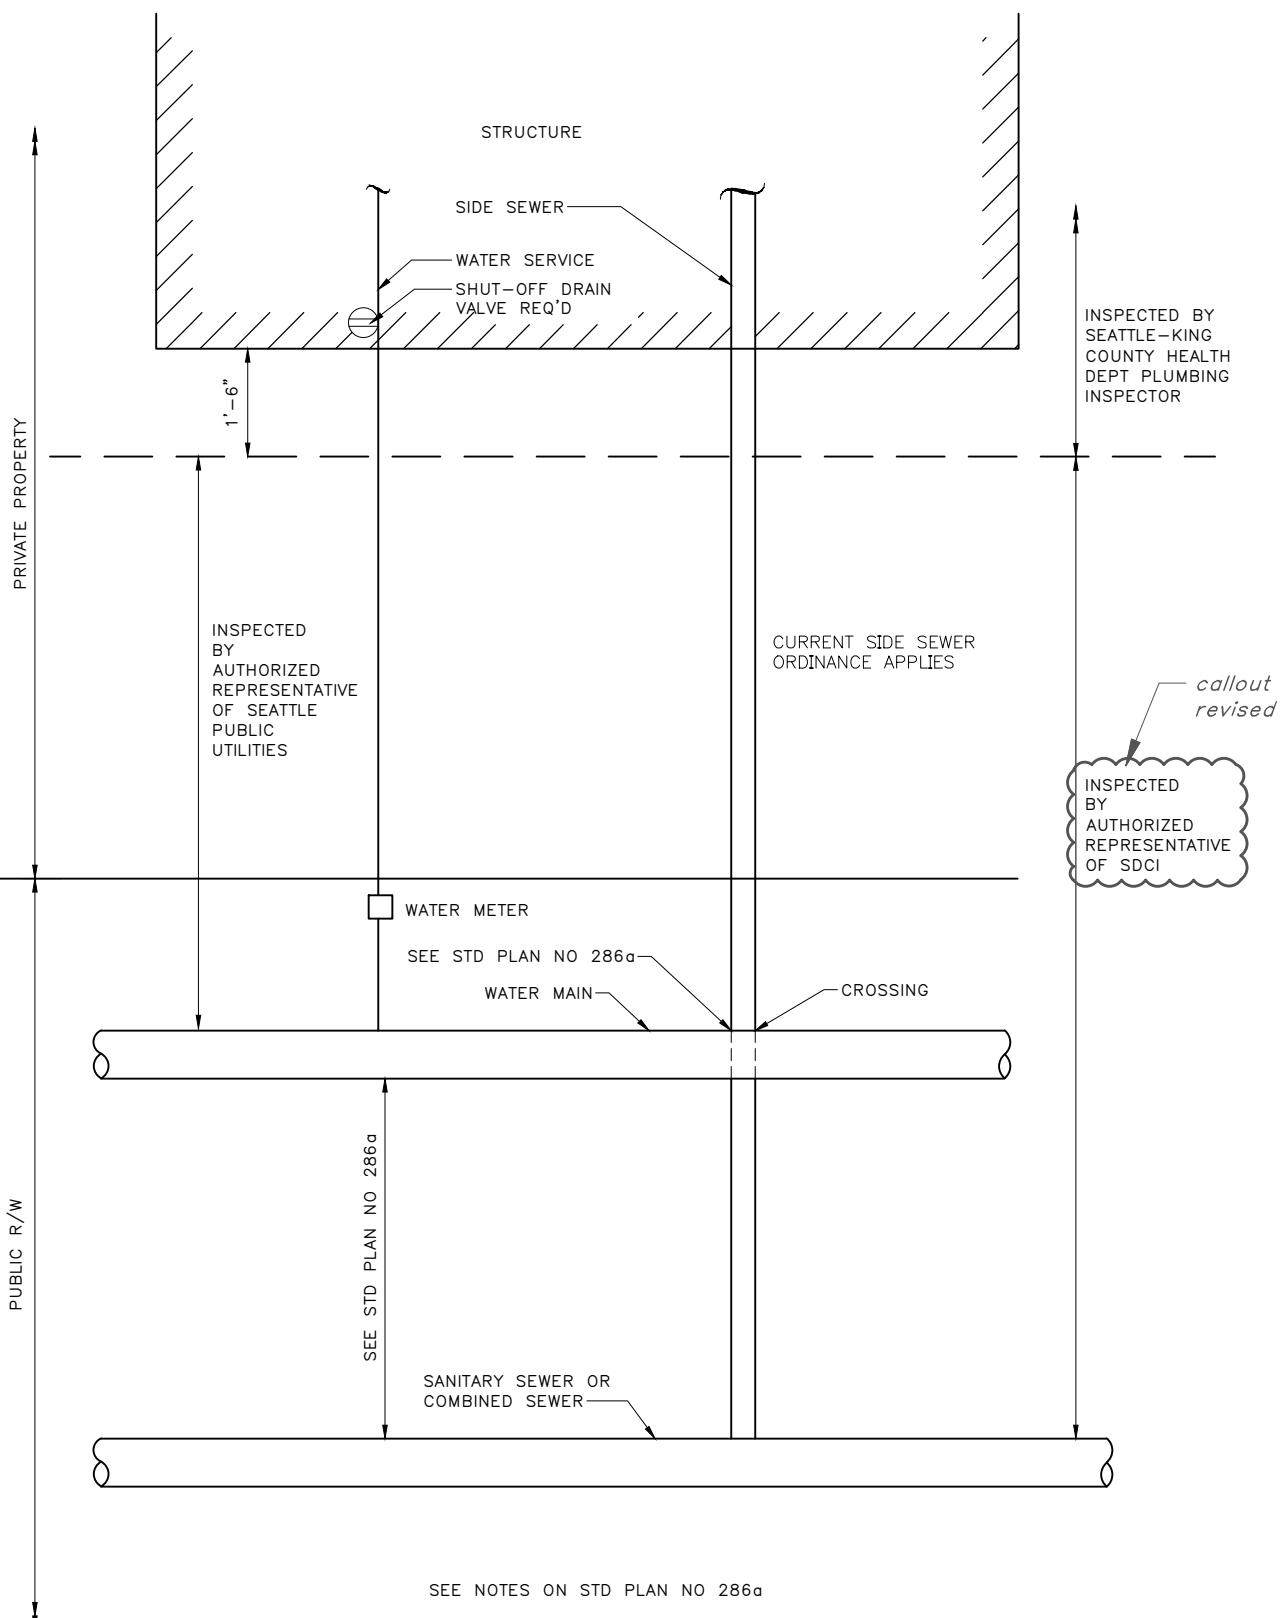

City of Seattle

NOT TO SCALE

SEWER & WATER SPACING & CLEARANCES

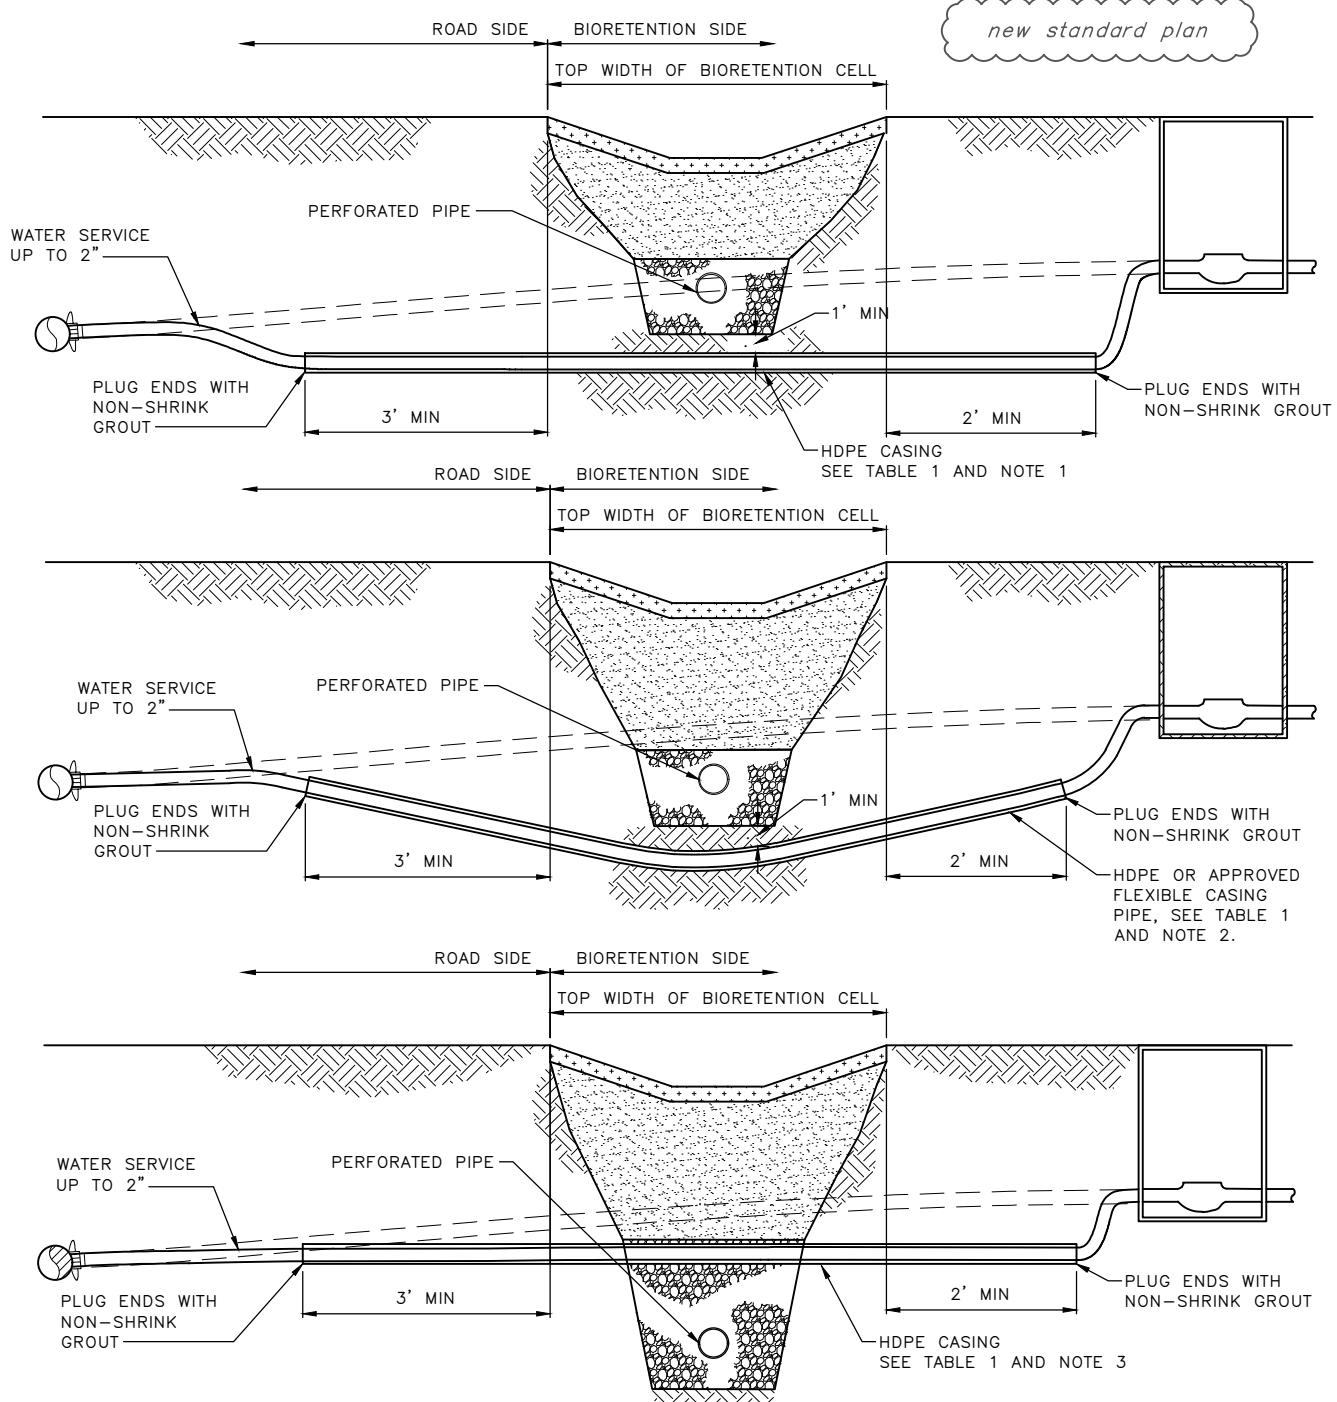

NOTES:

1. THIS CONFIGURATION APPLIES TO WATER SERVICE RELOCATION DEPTH 5' OR LESS.
2. THIS CONFIGURATION APPLIES TO WATER SERVICE RELOCATION DEPTH BETWEEN 5' AND 6'
3. THIS CONFIGURATION APPLIES TO WATER SERVICE RELOCATION DEPTH GREATER THAN 6'
4. FOR BIORETENTION CELLS WITH LINERS, ANY PENETRATION OF THE LINER MUST BE SEALED
5. THIS CONFIGURATION ALSO APPLIES TO OTHER UTILITIES UNLESS THE OTHER UTILITY HAS MORE STRINGENT CLEARANCE REQUIREMENTS.

TABLE 1
CASING SIZE

WATER SERVICE ϕ	CASING ϕ
$\frac{3}{4}$ "	2"
1.5"	2"
2"	3"


REF STD SPEC SEC 1-07.17




City of Seattle

NOT TO SCALE

WATER SERVICE RELOCATION
FOR UP TO 2" SERVICE PIPE
THROUGH BIORETENTION

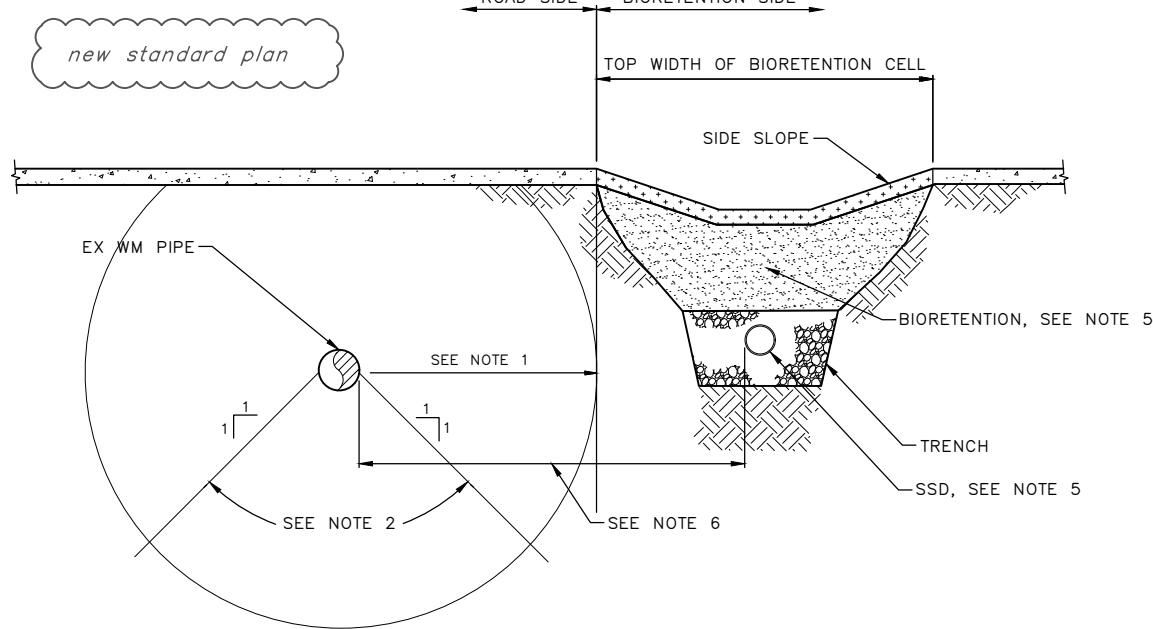

C STREET

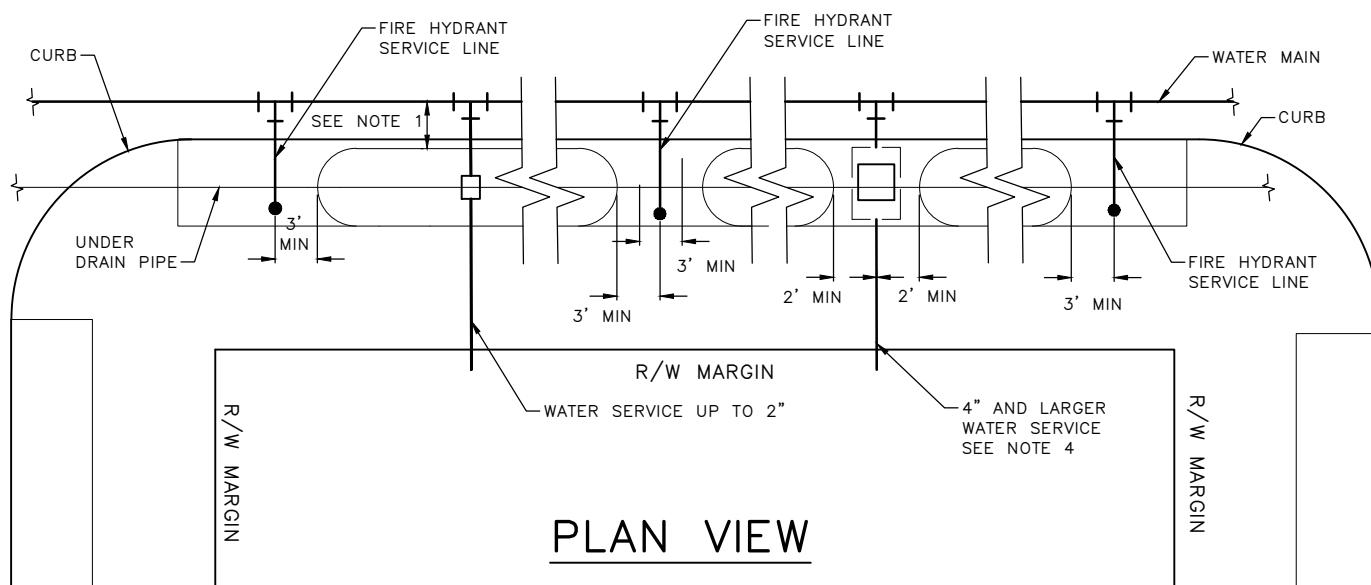**NOTES:**

1. HORIZONTAL SETBACK DISTANCE FROM THE EDGE OF THE PIPE TO THE EDGE OF ANY BIORETENTION CELL MUST BE MINIMUM 3.5 FEET FOR WATER MAIN UP TO AND INCLUDING 12"Ø WATER MAIN. WATER MAIN LARGER THAN 12"Ø MUST BE EVALUATED AND APPROVED ON A CASE BY CASE BASIS BY SEATTLE PUBLIC UTILITIES. IF SOIL WITHIN SETBACK IS DISTURBED A SUPPORT PLAN AND SOIL RE-COMPACTATION TO 95% MIN COMPACTION WILL BE REQUIRED. EXCEPTIONS TO THE MINIMUM 3.5' HORIZONTAL SETBACK MUST BE APPROVED BY SEATTLE PUBLIC UTILITIES PLAN REVIEW SECTION AND WATER QUALITY DIVISION.
2. SOIL WITHIN THE ZONE OF INFLUENCE MUST NOT BE DISTURBED IN ORDER TO MAINTAIN STRUCTURAL SUPPORT TO THE WATER MAIN.
3. BIORETENTION CELL MUST MAINTAIN 3' MIN CLEARANCE FROM THE EDGE OF ANY EXISTING FIRE HYDRANT SERVICE LINE TO THE EDGE OF THE BIORETENTION. FOR THE FIRE HYDRANT OPERATION THERE MUST BE A 4' MIN CLEARANCE AROUND THE FIRE HYDRANT WHERE NOTHING CAN BE AS TALL AS THE FIRE HYDRANT OPENING NUT.
4. BIORETENTION CELL MUST MAINTAIN 2' MIN CLEARANCE FROM THE EDGE OF THE BIORETENTION TO THE EDGE OF THE EXISTING 4" OR LARGER WATER SERVICE LINE OR SERVICE VAULT.
5. SEE STANDARD PLAN NO 292, 293A AND 293B FOR BIORETENTION REQUIREMENTS.
6. HORIZONTAL SETBACK DISTANCE BETWEEN EXISTING WATER MAIN AND THE BIORETENTION SSD PIPE MUST COMPLY WITH STD PLAN NO 286A. EXCEPTION TO STD PLAN NO 286A PARALLEL INSTALLATION APPLIES IF THE UNDER DRAIN PIPE ONLY RECEIVES TREATED RUNOFF PER STORMWATER CODE REQUIREMENTS FOR WATER QUALITY TREATMENT.


REF STD SPEC SEC 1-07.17



City of Seattle

NOT TO SCALE

WATERMAIN SETBACK
REQUIREMENT FOR C.I. LEAD
JOINT AND D.I. SLIP JOINT PIPE

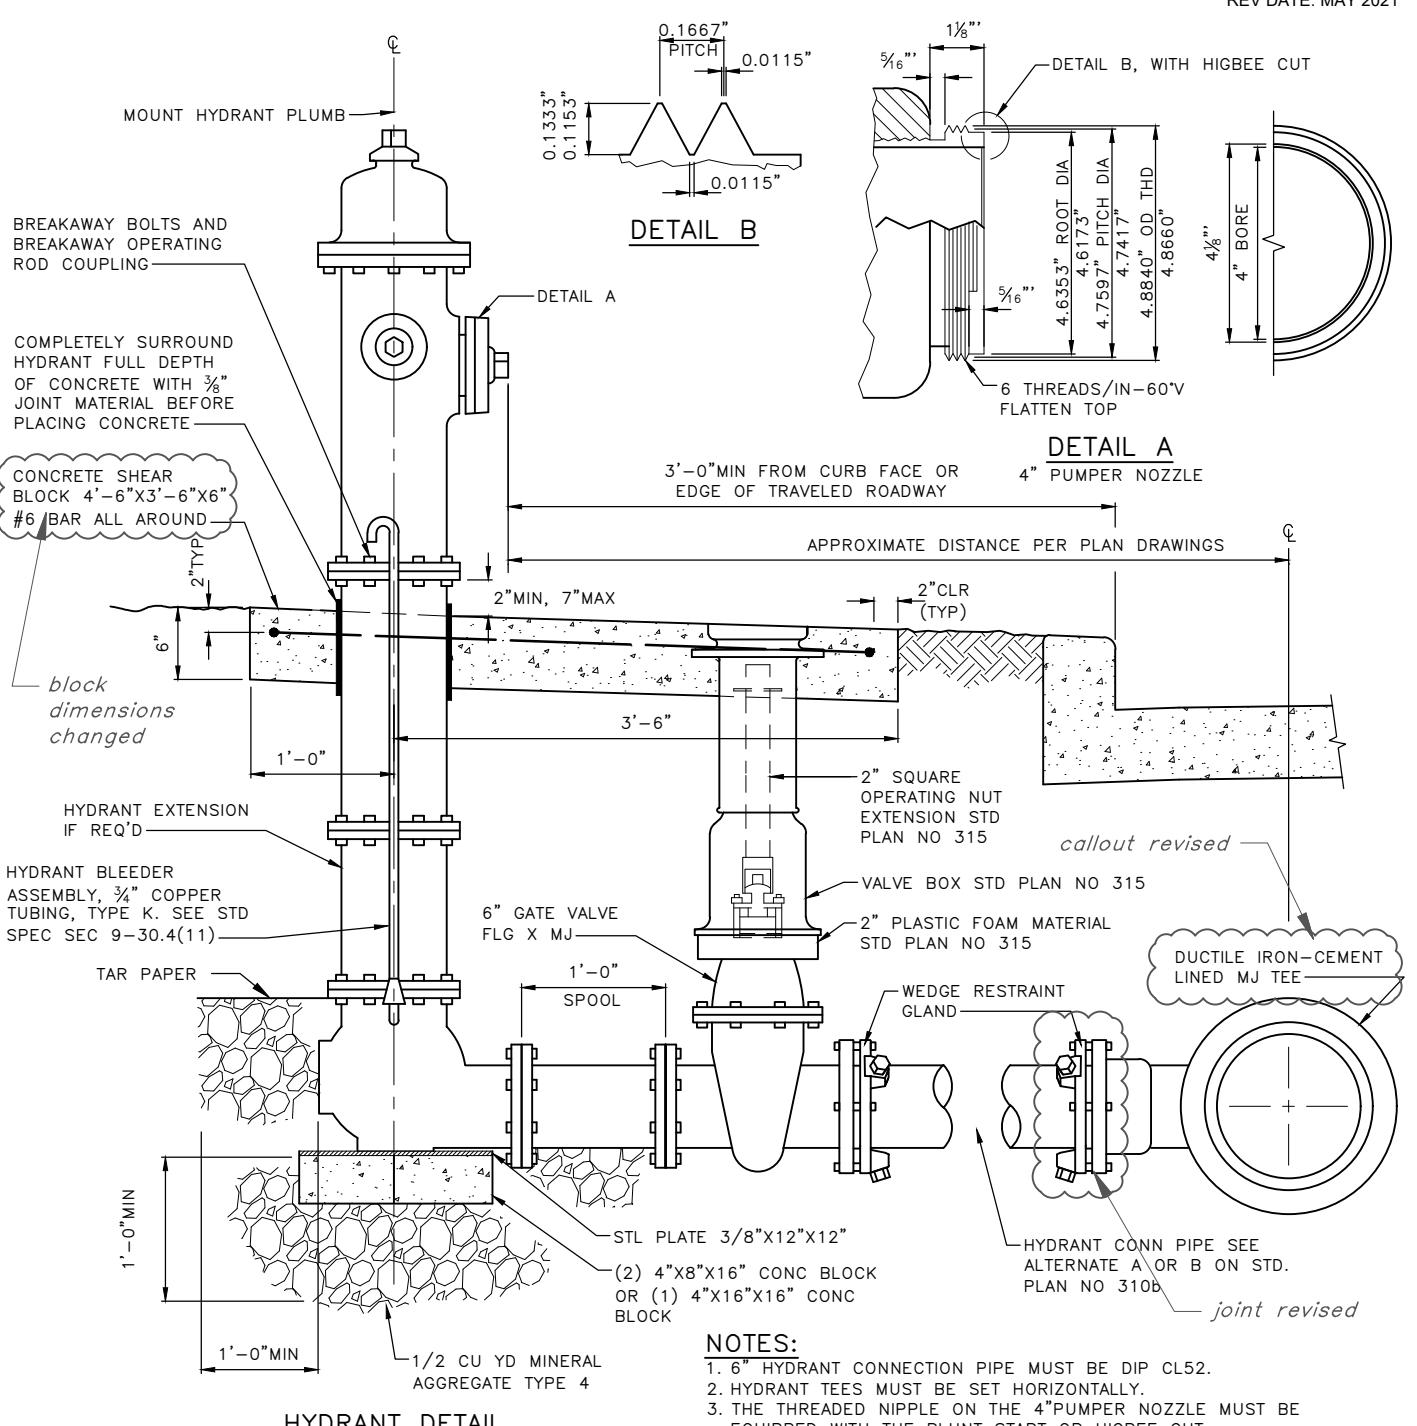

REF STD SPEC SEC 7-14




City of Seattle

NOT TO SCALE

TYPE 310 HYDRANT SETTING
DETAIL

REV DATE: MAR 2023

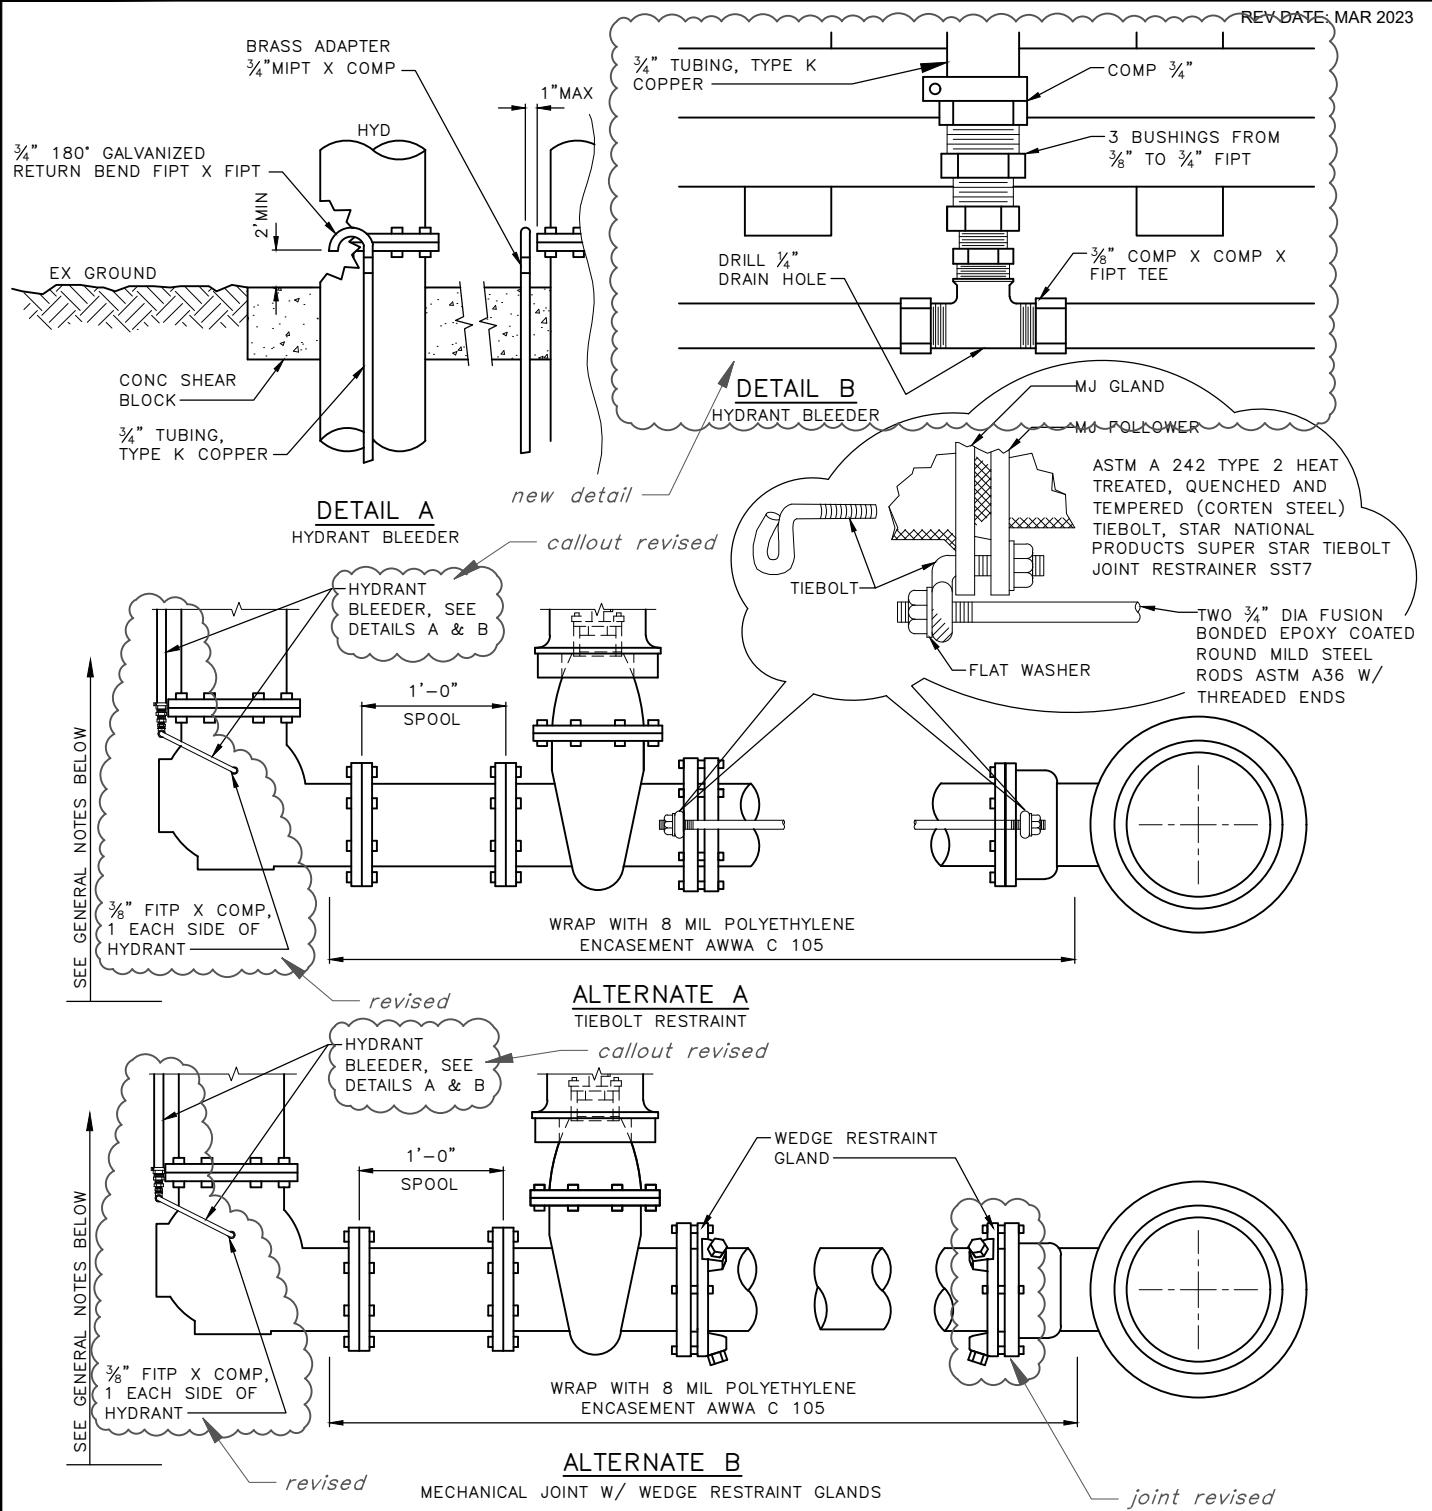**NOTES:**

1. WHERE WATERMAINS ARE INSTALLED WITH POLYETHYLENE ENCASEMENT OR TAPE COATINGS, THE HYDRANT BARREL AND VALVE MUST BE SIMILARLY ENCASED, COATED AND/OR JOINTS BONDED. WHERE WATERMAIN IS THERMOPLASTIC COATED, THE HYDRANT BARREL MUST BE TAPE COATED
2. WHERE 6" GATE VALVE IS TO BE LOCATED WITHIN A PARKING-PERMITTED AREA, A SECOND 6" GATE VALVE MUST BE INSTALLED AT THE HYDRANT ASSEMBLY PER STD PLAN NO 310a


REF STD SPEC SEC 7-14





City of Seattle

NOT TO SCALE

TYPE 310 HYDRANT SETTING
DETAIL

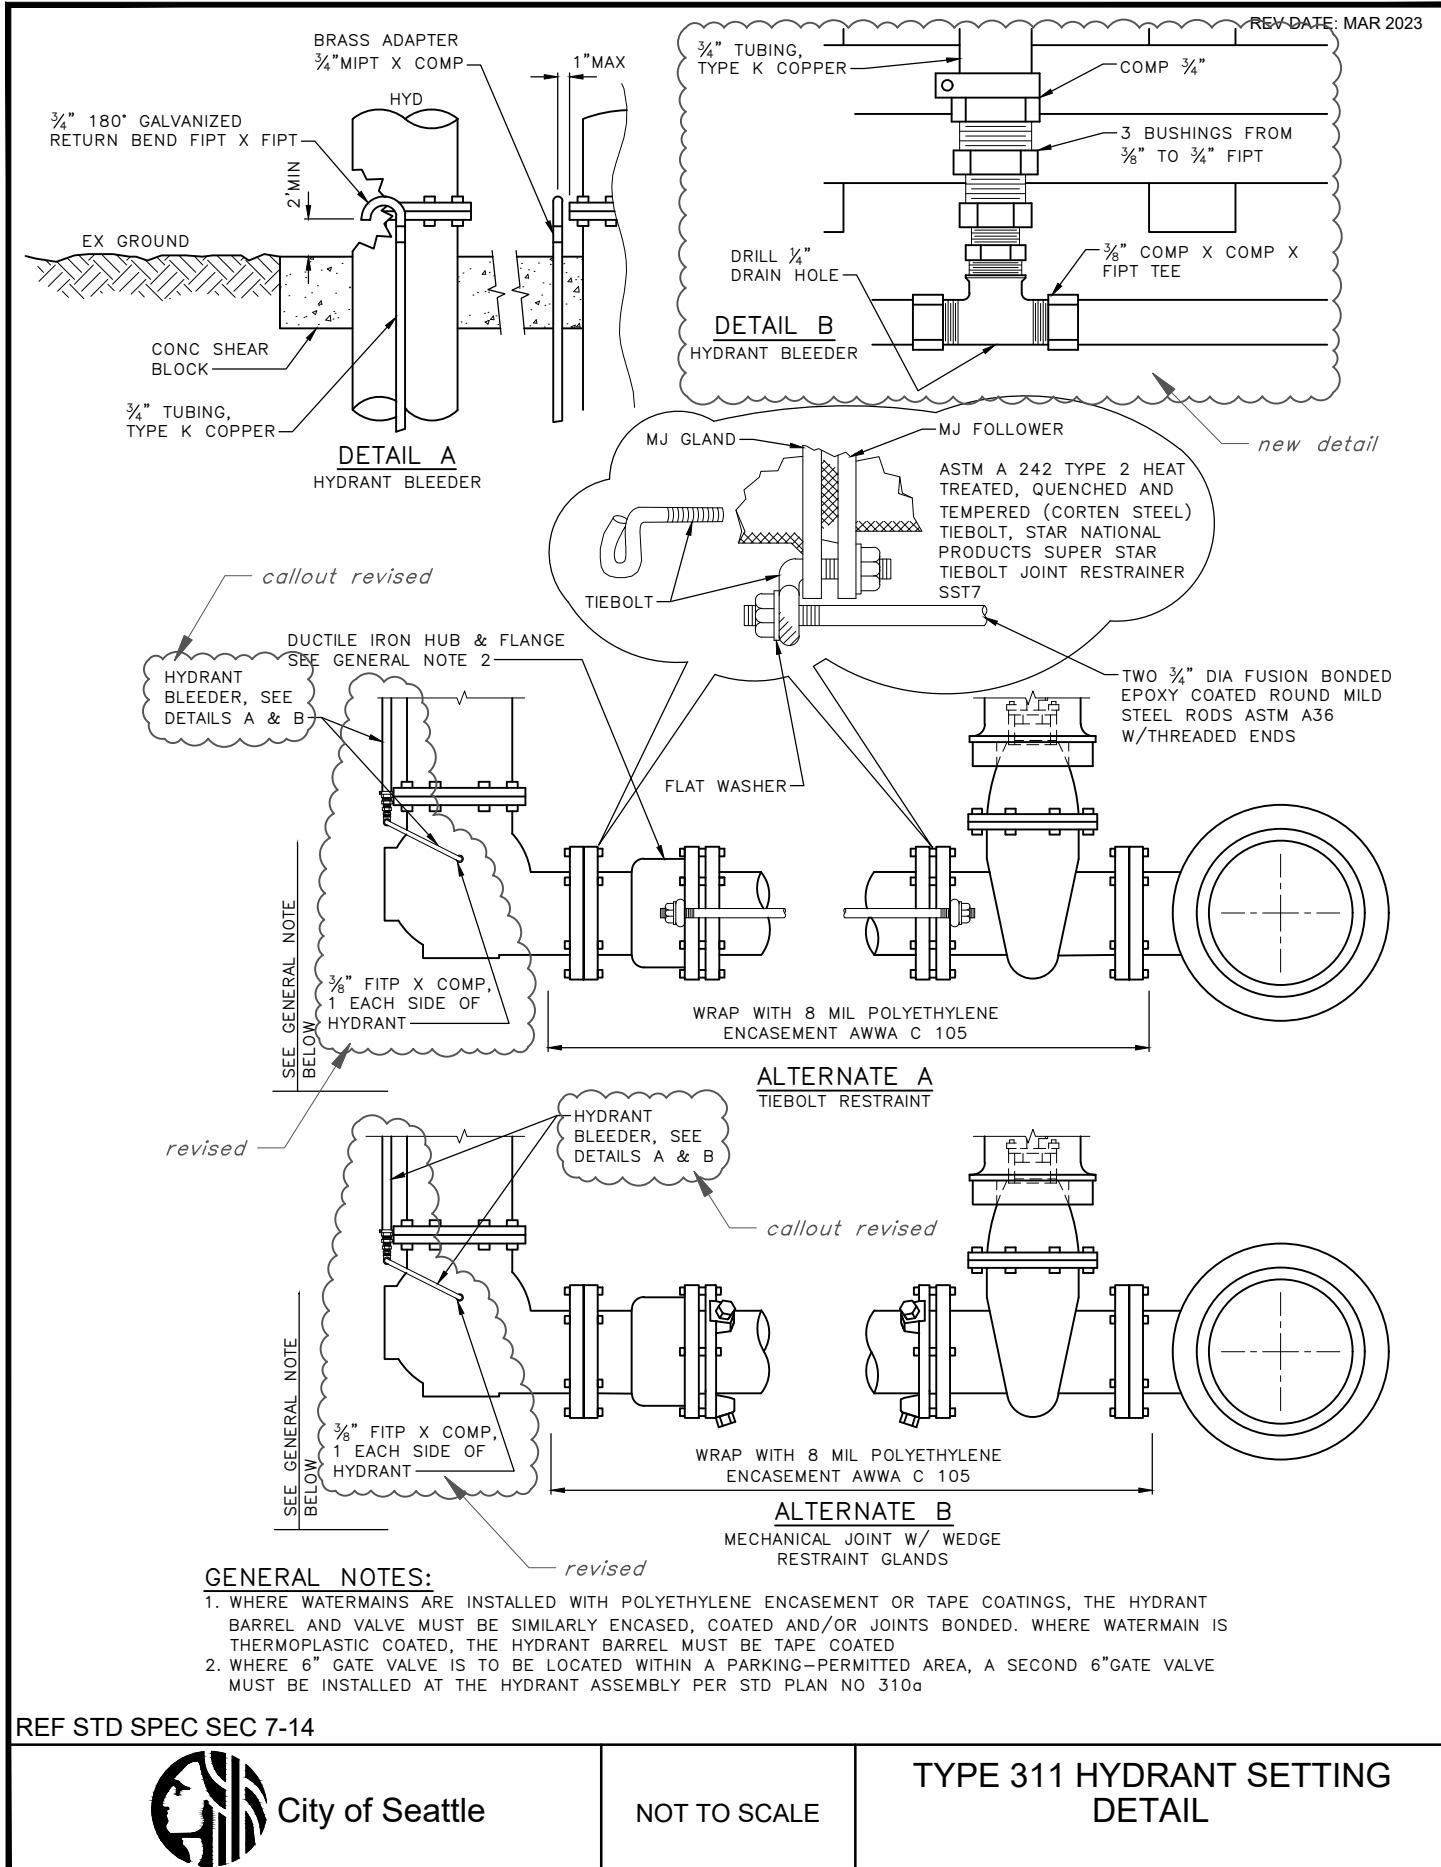


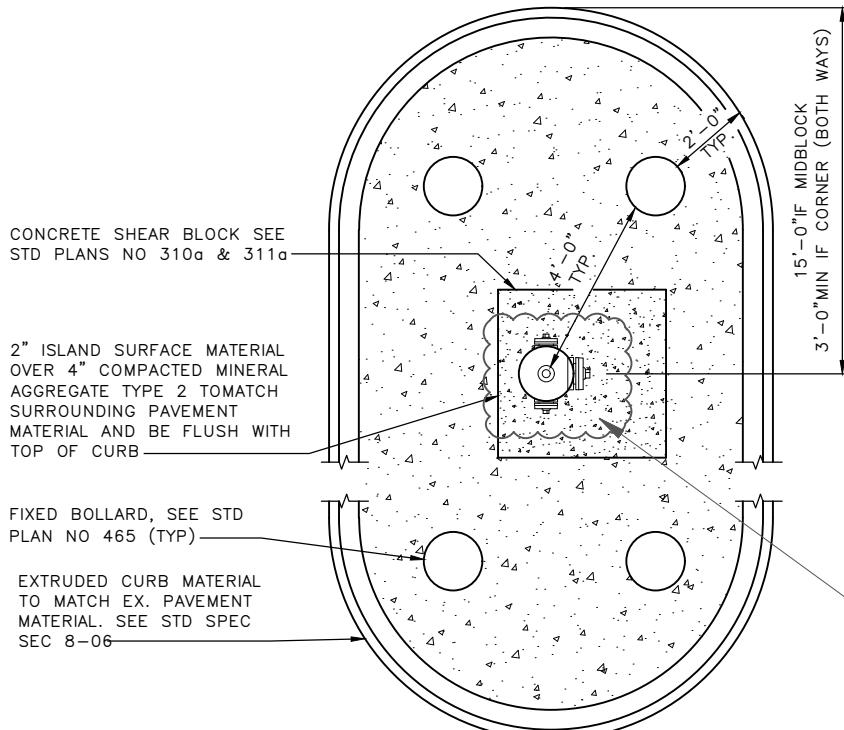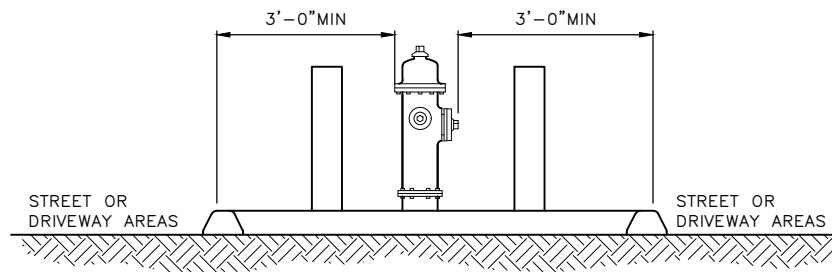

TRAFFIC ISLAND MARKER POST LAYOUT FOR FIRE HYDRANTS IN PARKING AREAS

NOTE:
LAYOUT OF MARKER POST MUST BE VERIFIED FIRST WITH SPU AND SDOT

nut moved to center of hydrant

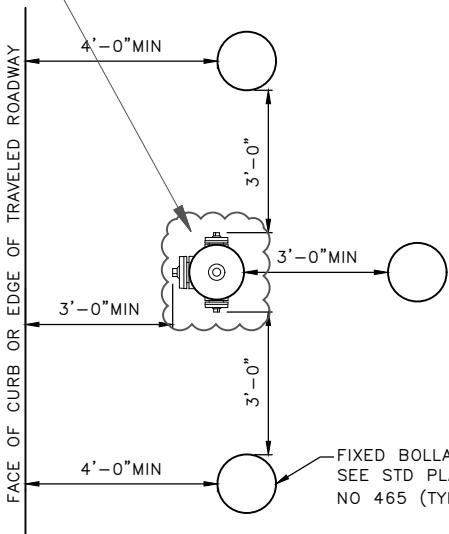

MARKER POST LAYOUT FOR FIRE HYDRANTS IN PARKING AREAS


REF STD SPEC SEC 7-14



City of Seattle

NOT TO SCALE

FIRE HYDRANT MARKER LAYOUT

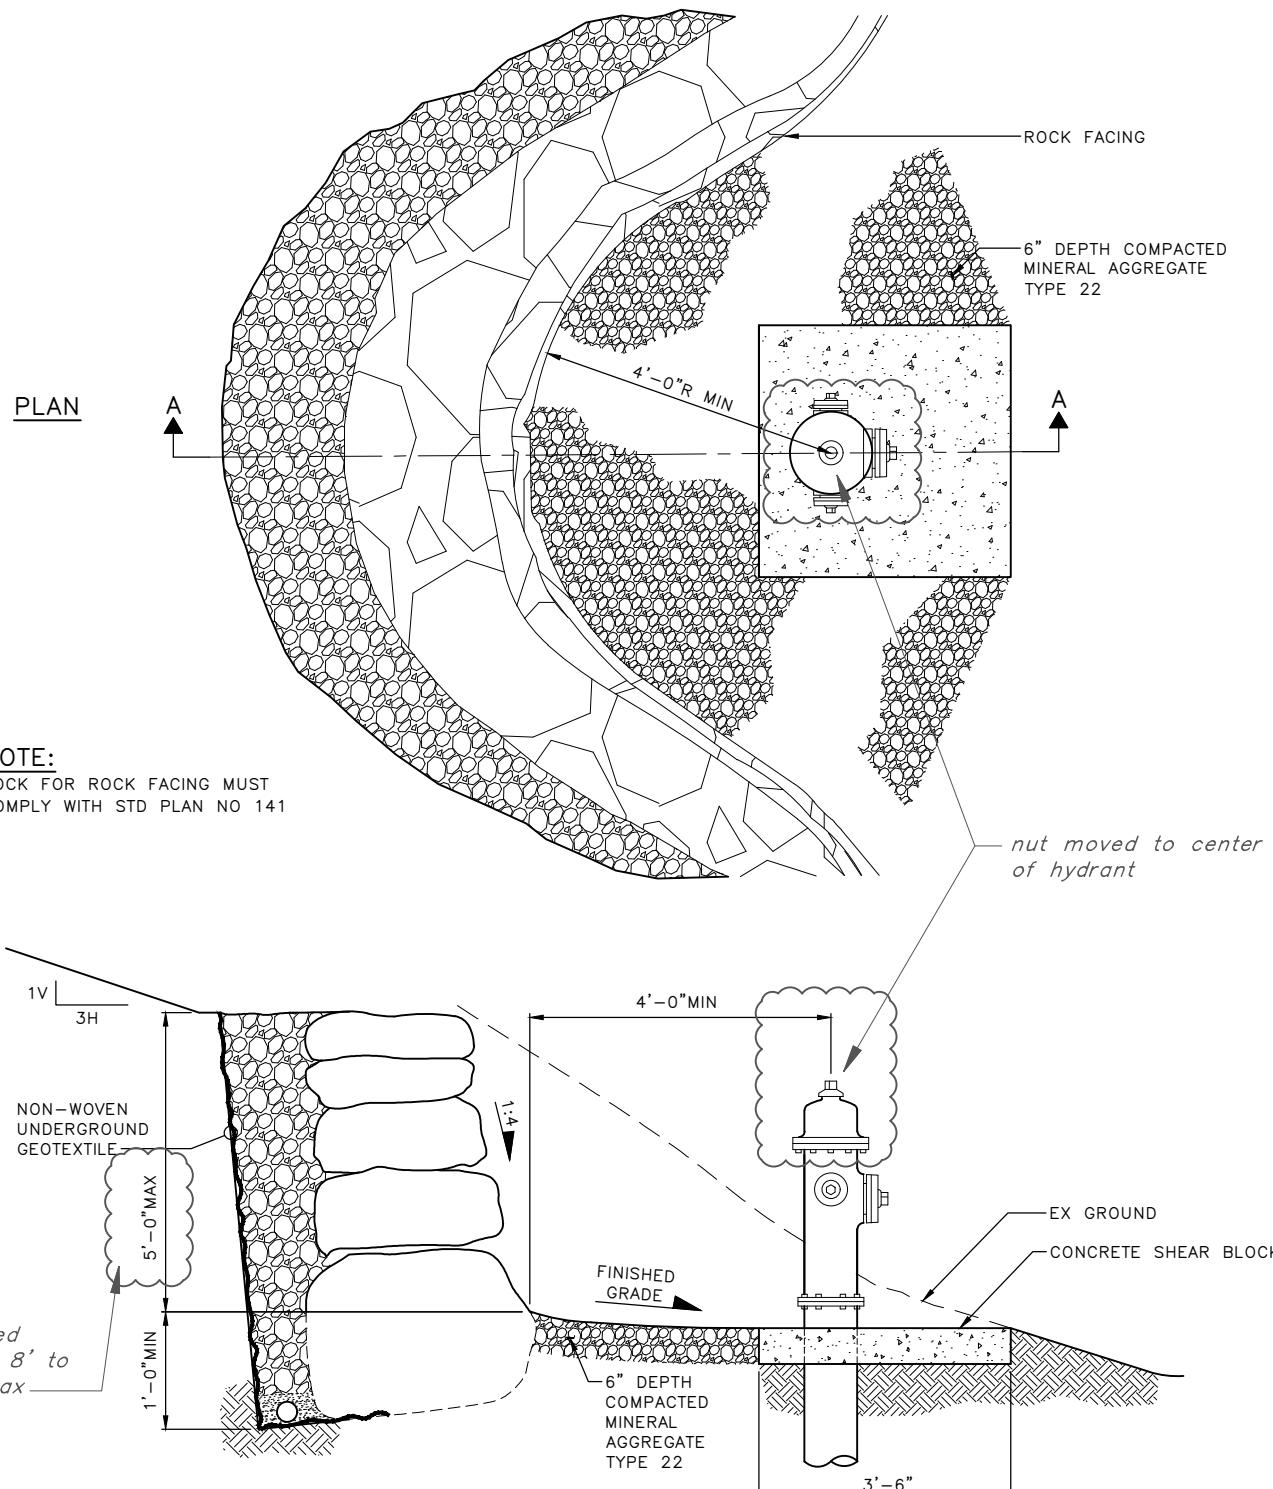

REF STD SPEC SEC 2-13



City of Seattle

NOT TO SCALE

WALL REQUIREMENTS
FOR HYDRANTS

REV DATE: OCT 2022

NOTES:

1. NO PARKING ZONE WITHIN 15'-0" RADIUS OF FIRE HYDRANT
2. MIN DISTANCE FROM CENTER OF HYDRANT TO FIXED OBJECT 4'.
3. MIN DISTANCE FROM HYDRANT PUMPER PORT TO CURB FACE/ROADWAY 3'
4. MIN DISTANCE FROM HYDRANT TO ANY PART OF CURB RAMP MUST BE 2'
5. BLUE LANE MARKER MUST BE 6" OFFSET FROM CENTER OF ROADWAY IF CENTERLINE IS NOT STRIPED, OR 6" OFF STRIPED CENTERLINE. WHERE MEDIAN OR TWO-WAY LEFT TURN LANES EXIST, MARKER MUST BE INSTALLED WITH 6" OFFSET FROM THE LANE LINE CLOSEST TO THE HYDRANT

notes added/revised

CORNER

INSTALL BLUE TYPE 2A LANE
MARKER ADJACENT TO FIRE
HYDRANTS. SEE NOTE 5 (TYP)

detail revised

FACE OF CURB

3'-0" MIN

HYDRANT SHEAR BLOCK
SEE STD PLAN NO 310a
& 311a FOR SHEAR
BLOCK INFORMATION


dims revised

MID-BLOCK

SHEAR BLOCK FULL
DEPTH JOINT, ALL SIDESDETAIL A
HYDRANT NEAR CURB RAMP

CORNER


REF STD SPEC SEC 7-14, 8-08

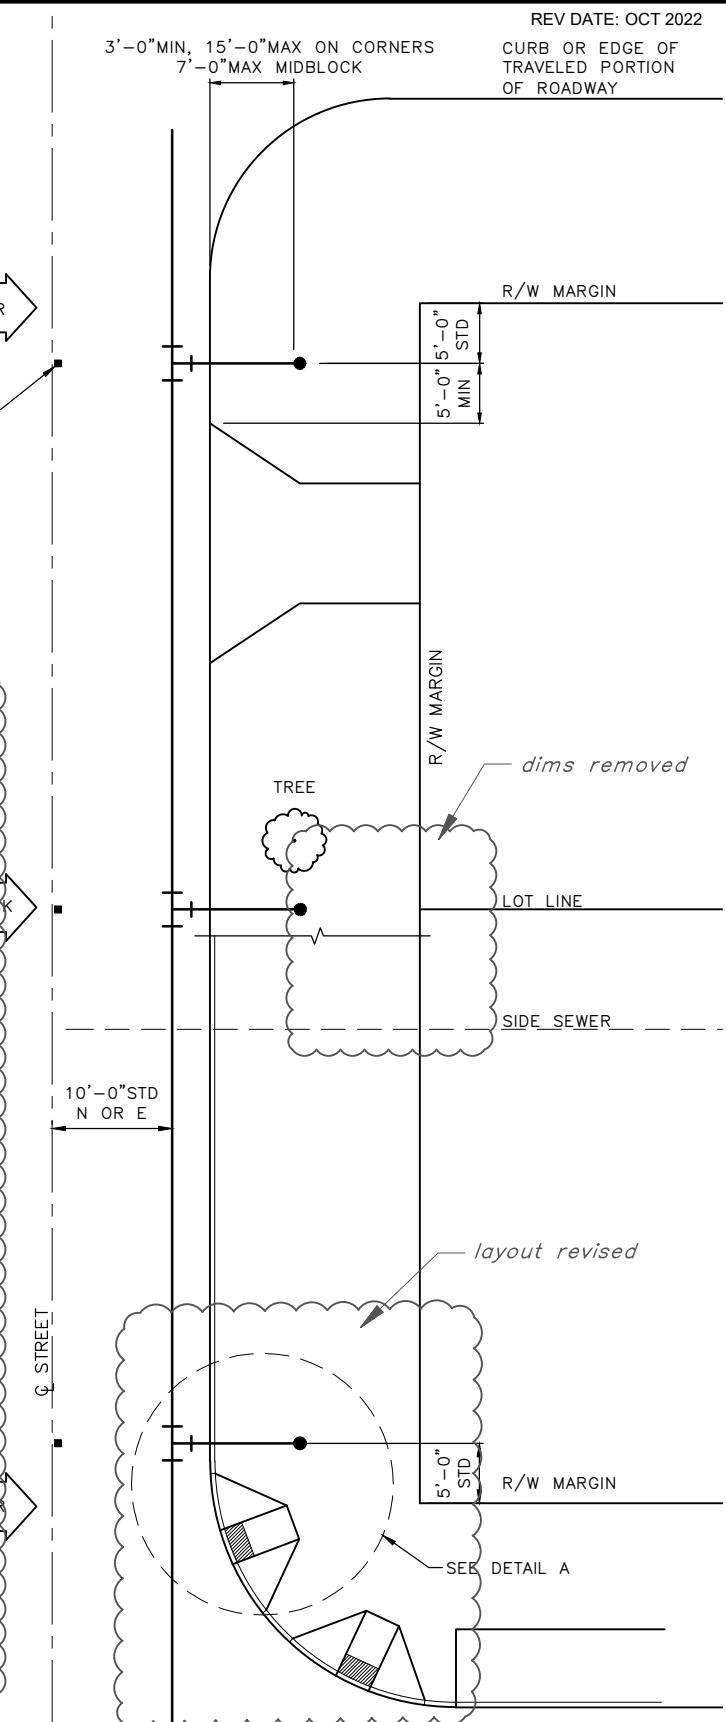3'-0" MIN, 15'-0" MAX ON CORNERS
7'-0" MAX MIDBLOCKCURB OR EDGE OF
TRAVELED PORTION
OF ROADWAY

City of Seattle

NOT TO SCALE


FIRE HYDRANT
LOCATIONS & CLEARANCES

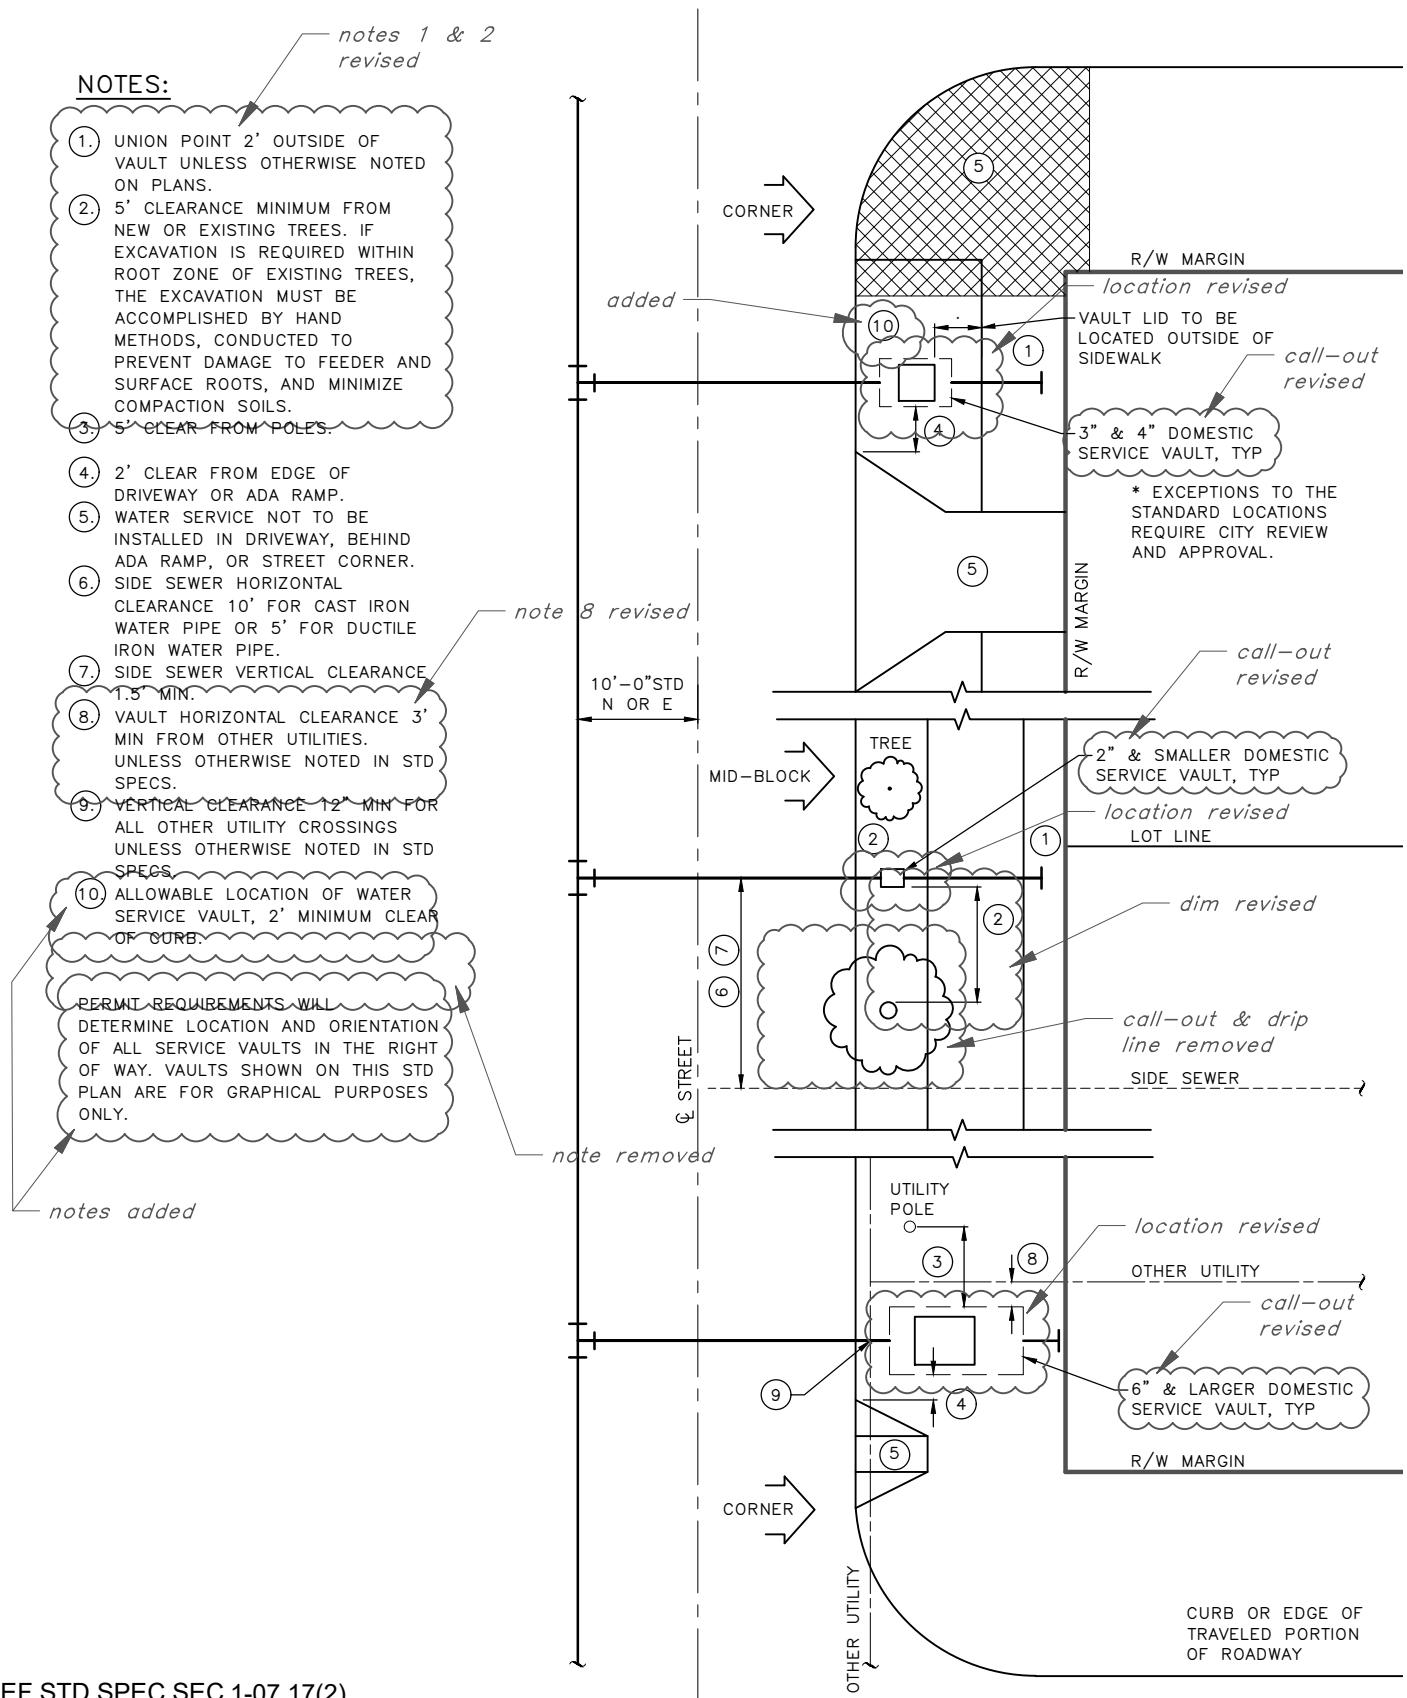

City of Seattle

NOT TO SCALE

CLEARANCES FOR TYPICAL WATER SERVICE VAULTS

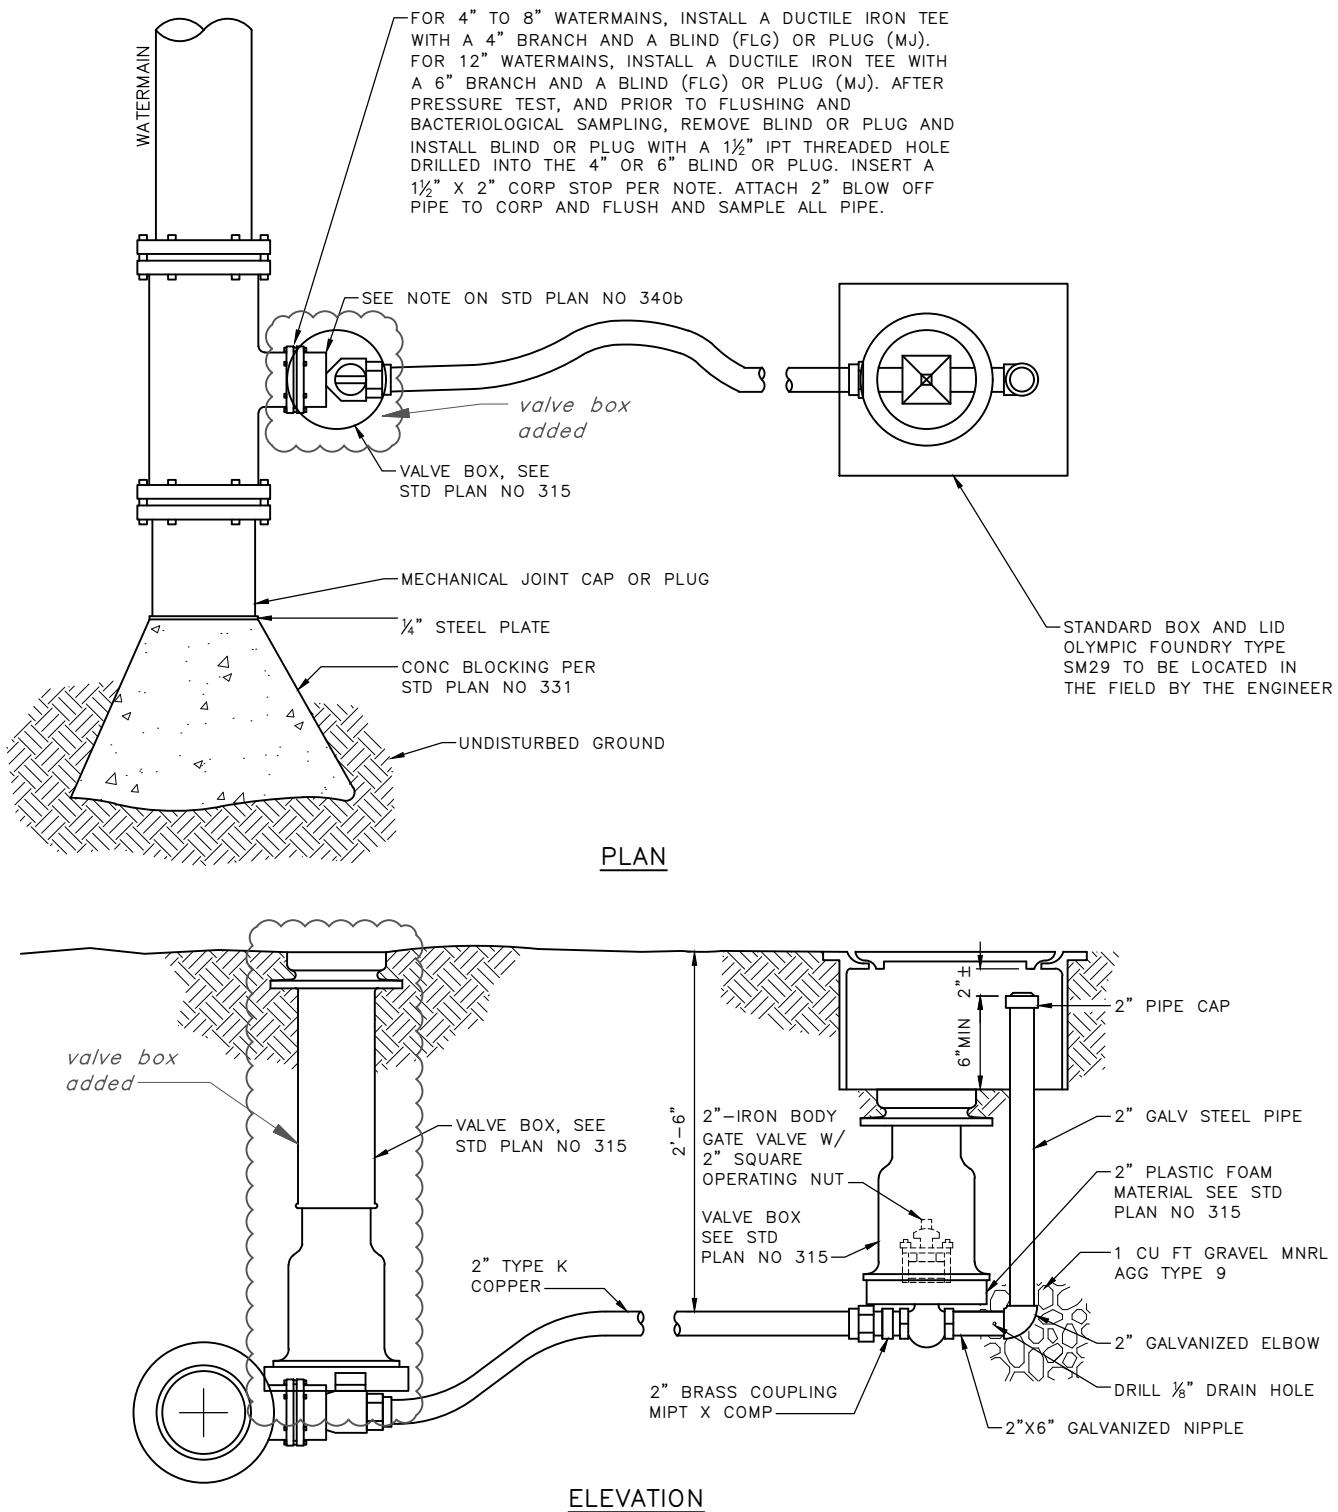


REF STD SPEC SEC 7-11



City of Seattle

NOT TO SCALE

2" BLOW OFF TYPE A
NON TRAFFIC INSTALLATION

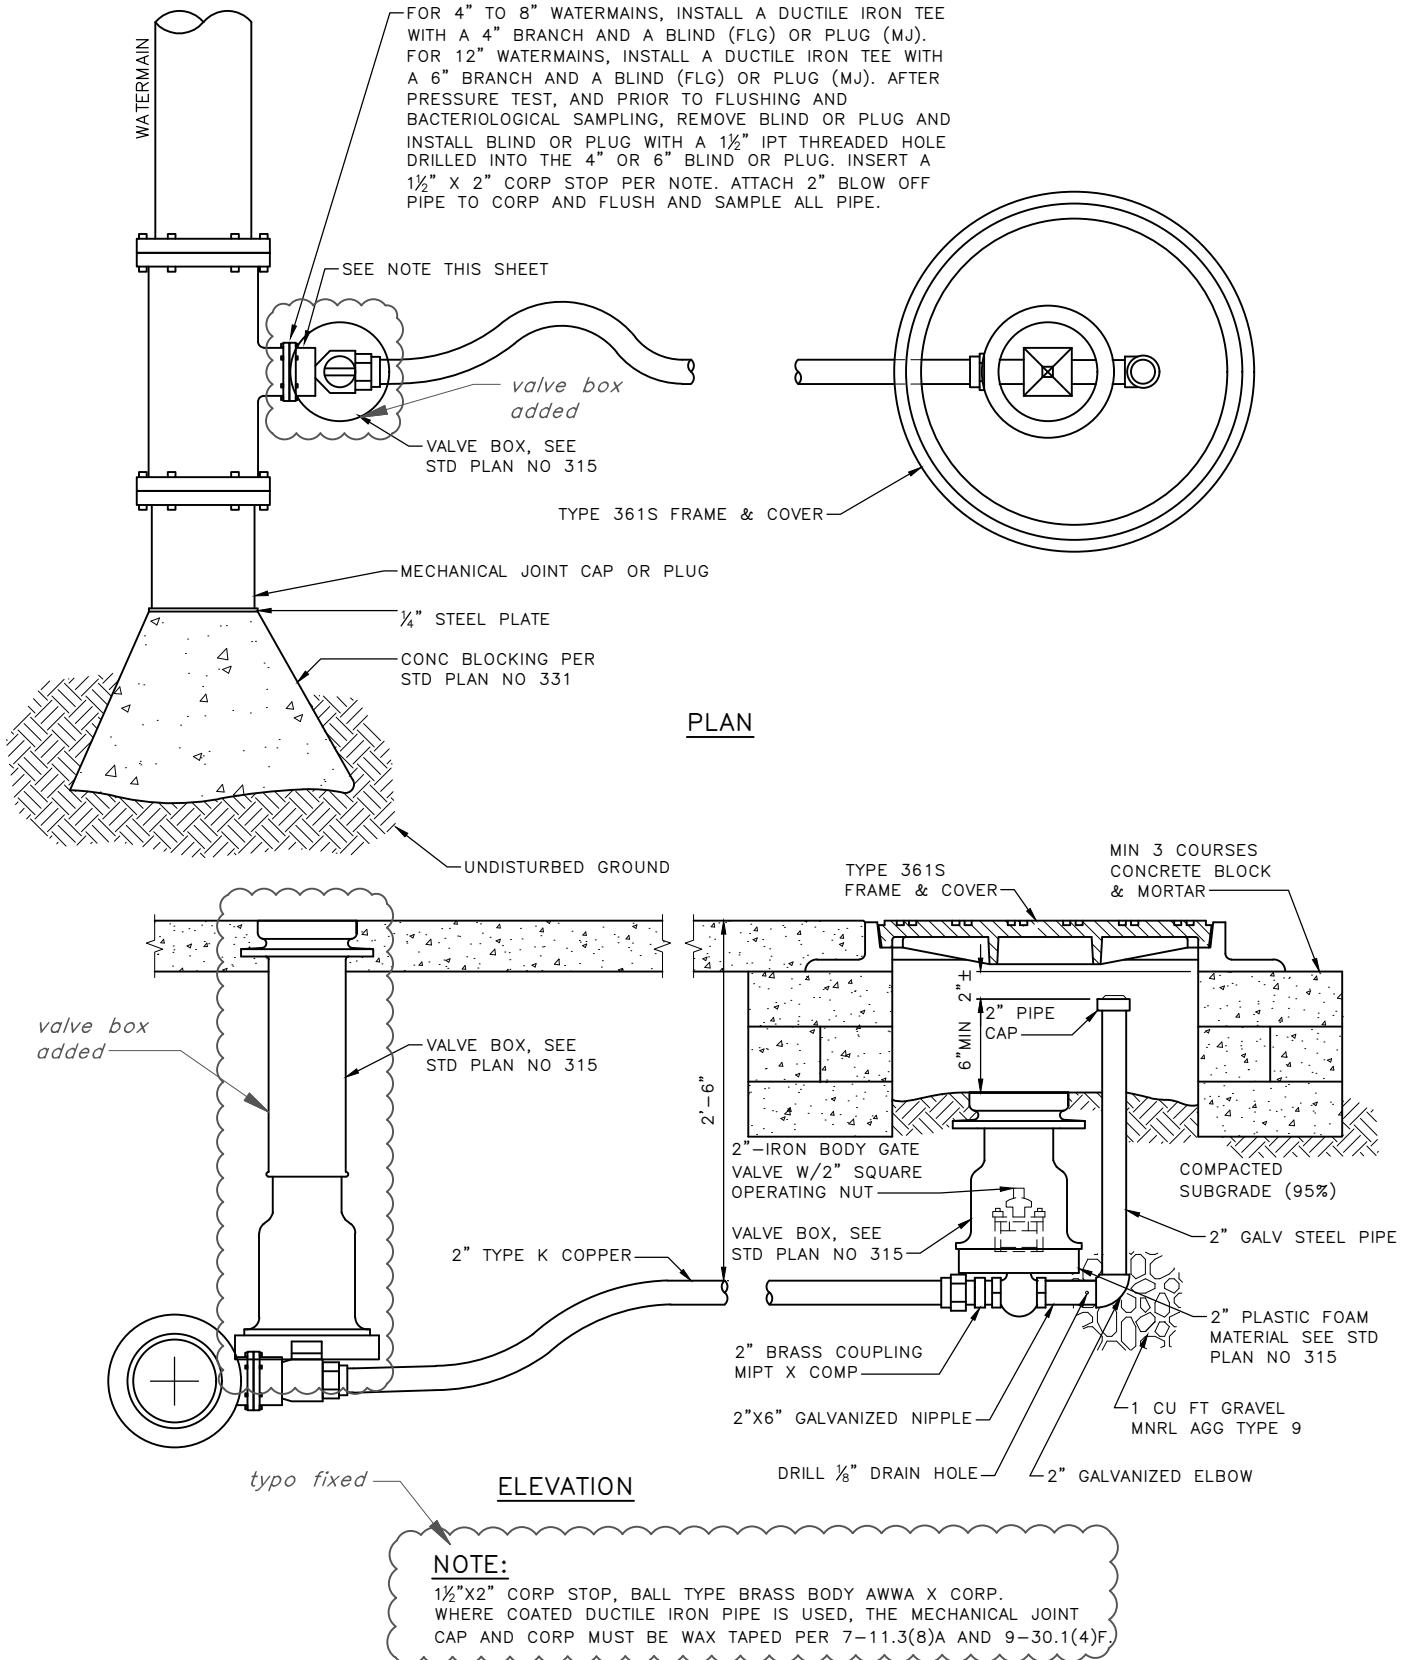


REF STD SPEC SEC 7-11




City of Seattle

NOT TO SCALE

2" BLOW OFF DETAIL TYPE B TRAFFIC INSTALLATION

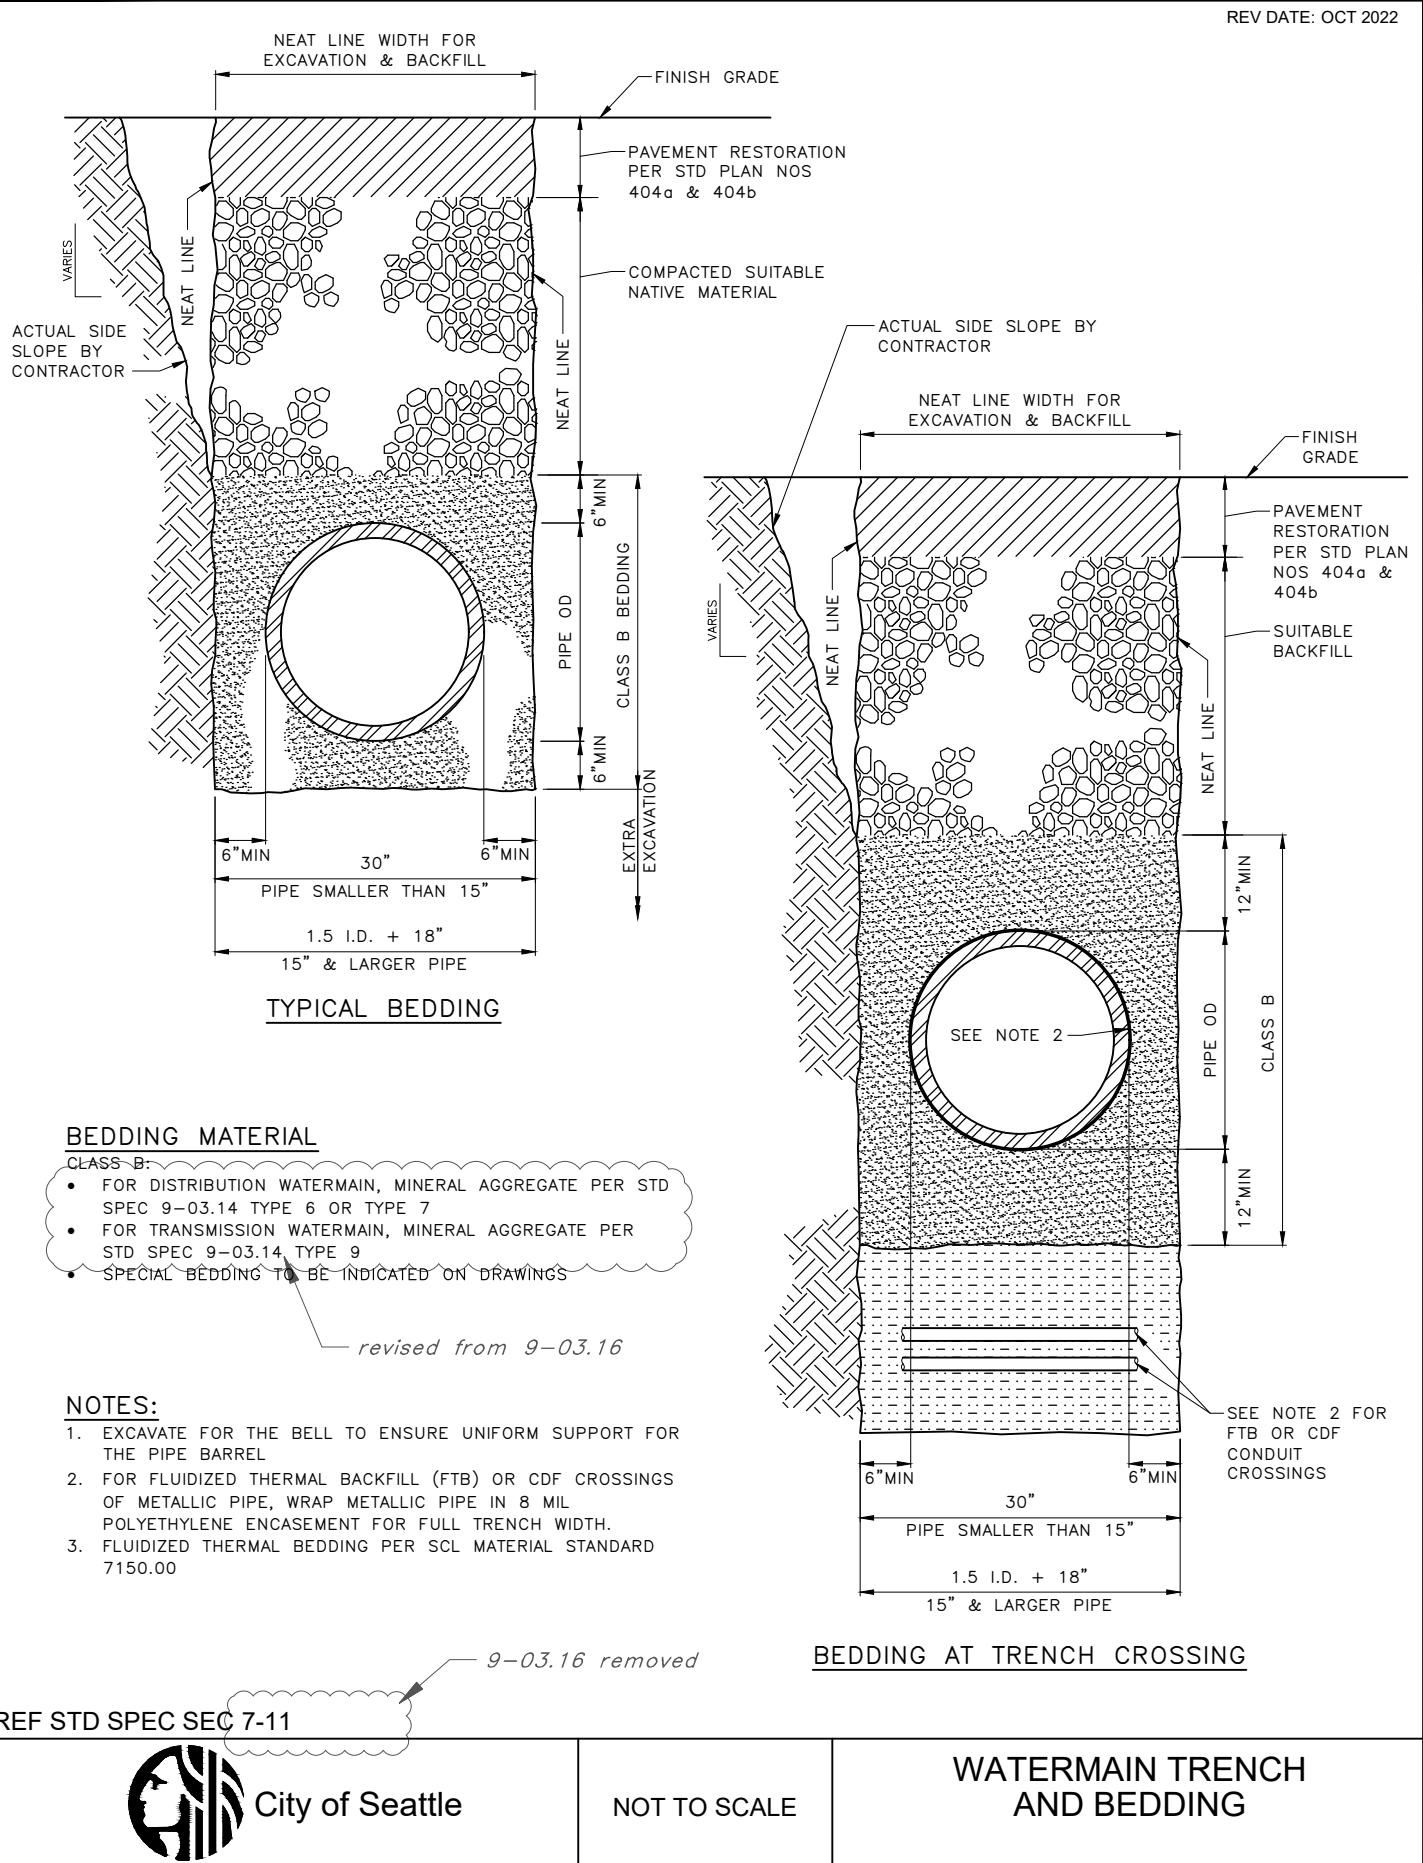

new standard plan

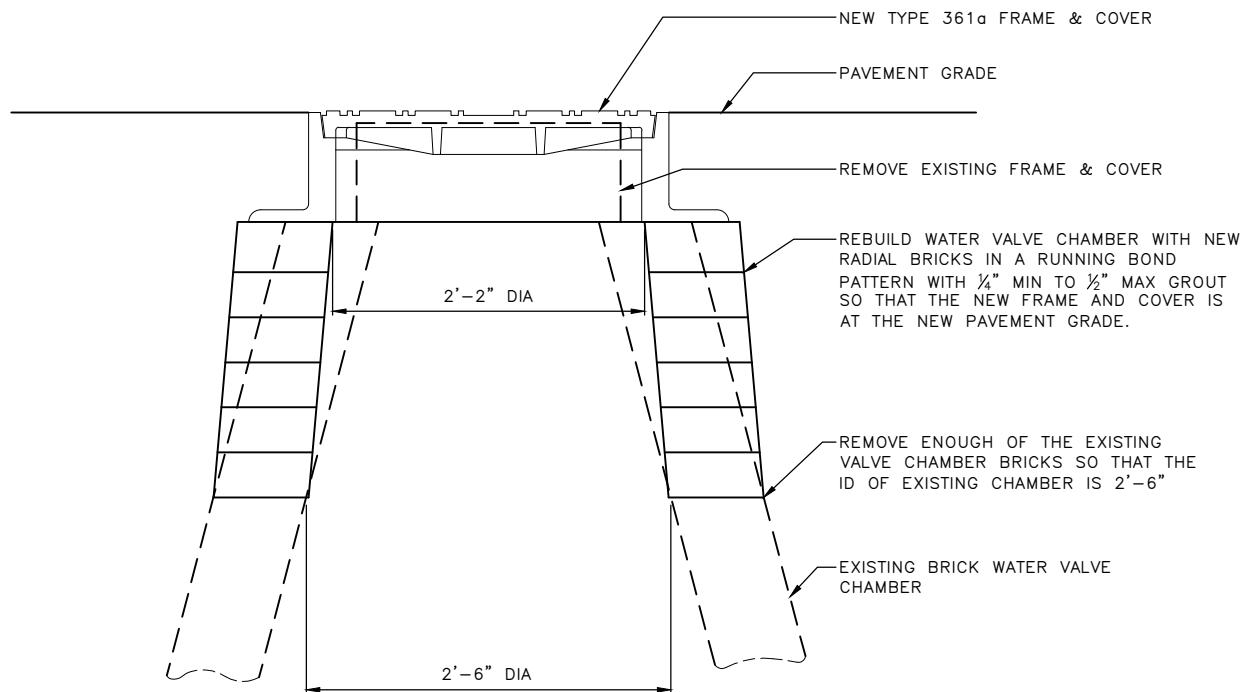


REF STD SPEC SEC 7-20



City of Seattle

NOT TO SCALE

REBUILD EXISTING
BRICK WATER VALVE CHAMBER

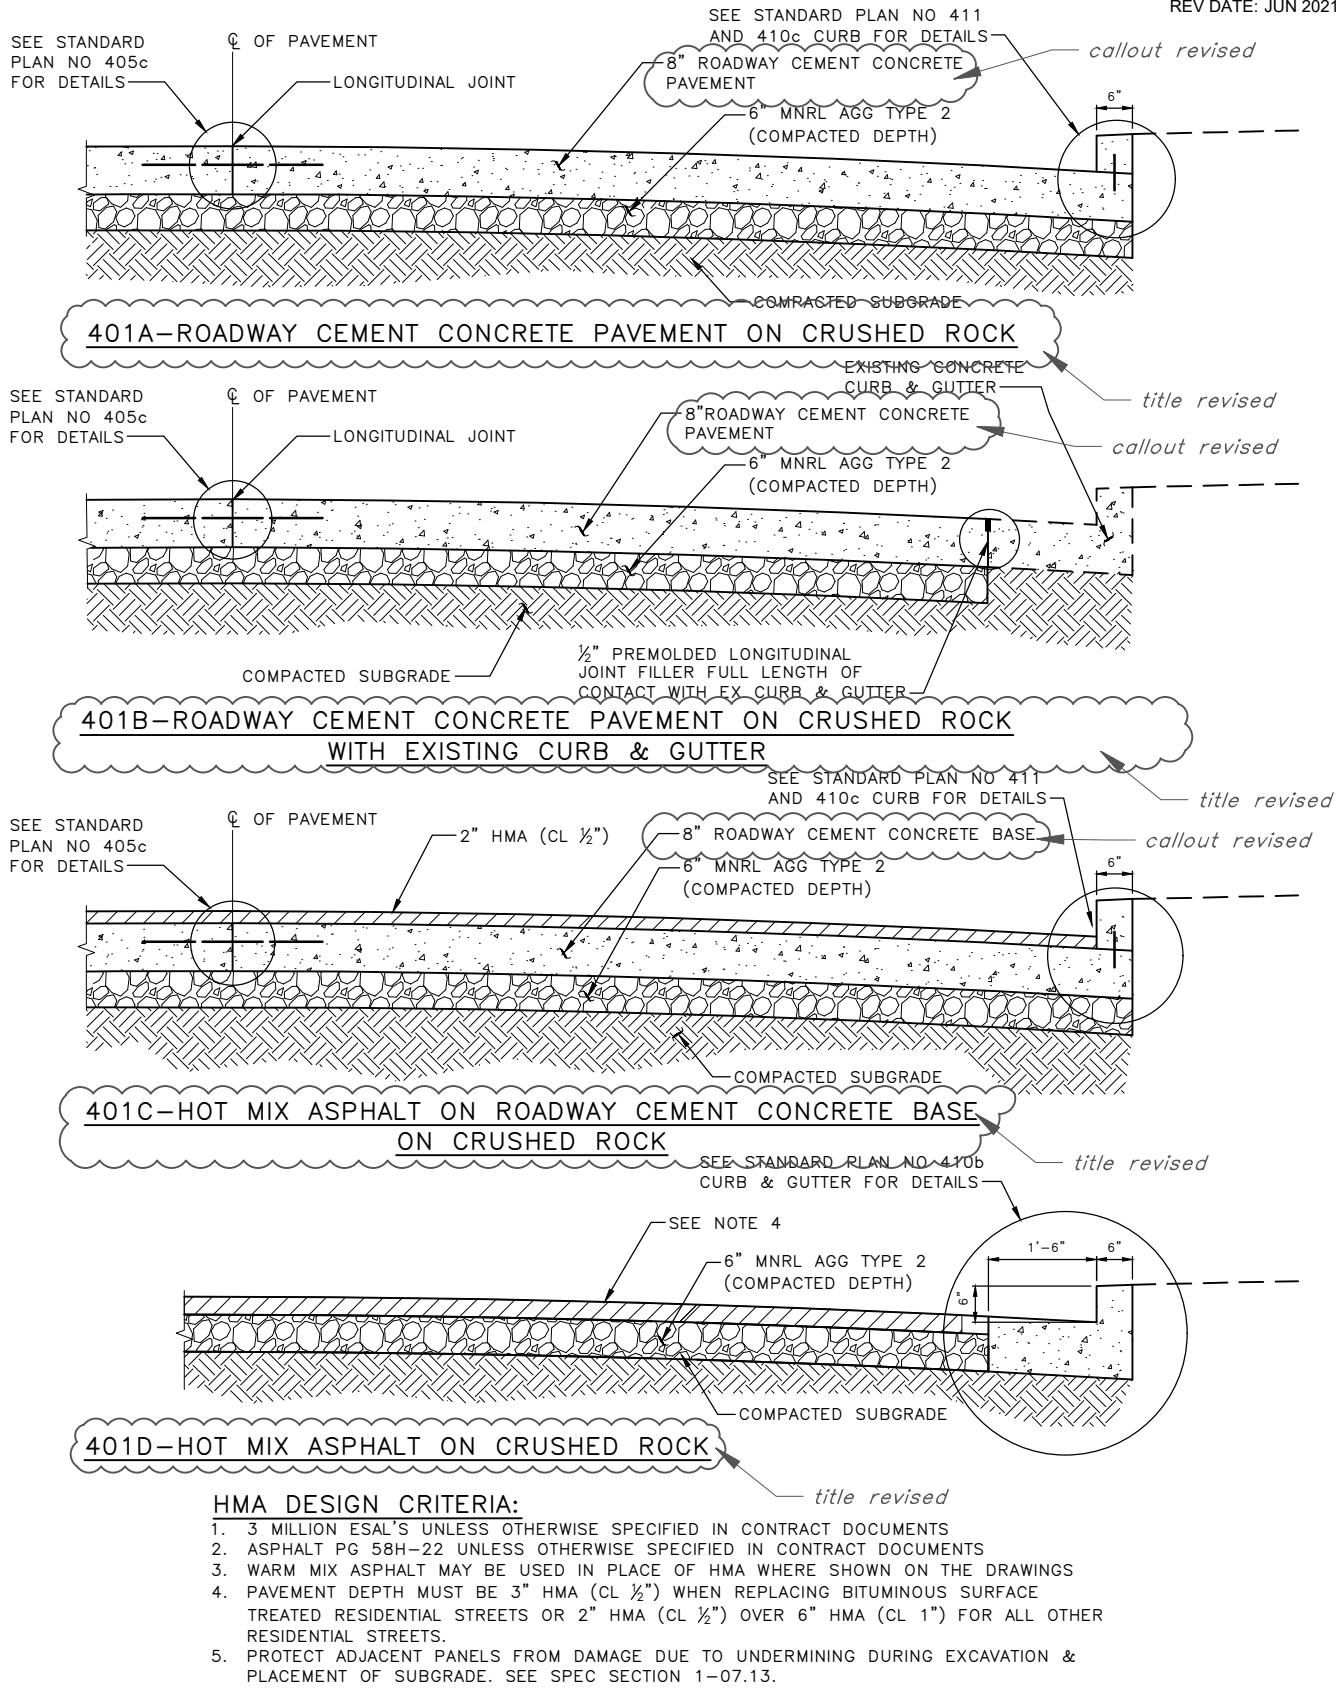


REF STD SPEC SEC 4-04, 5-04, 5-05, 8-04



City of Seattle

NOT TO SCALE


RESIDENTIAL PAVEMENT SECTIONS

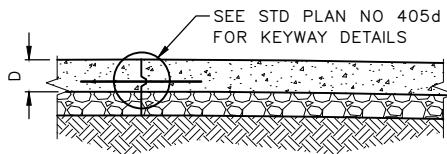


OPTIONAL KEYWAY
FOR LONGITUDINAL JOINT

NOTES:


IF CONC THICKNESS IS 9 INCH OR GREATER
OPTIONAL KEYWAY MAY BE USED SEE STD PLANS
NO 405c & 405d FOR DETAILS

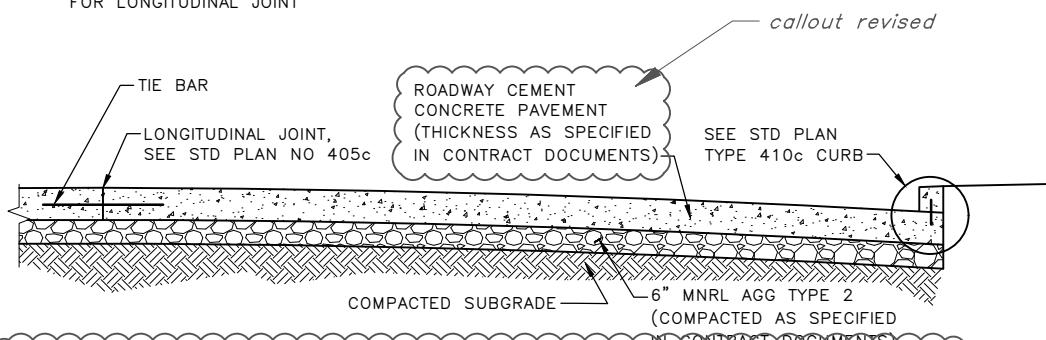

402A-ROADWAY CEMENT CONCRETE PAVEMENT ON CRUSHED ROCK

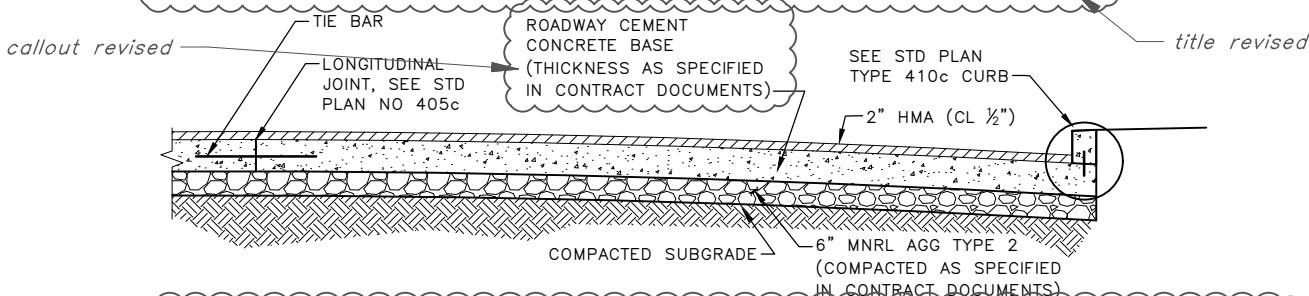

**402B-HOT MIX ASPHALT ON ROADWAY CEMENT CONCRETE BASE
ON CRUSHED ROCK**

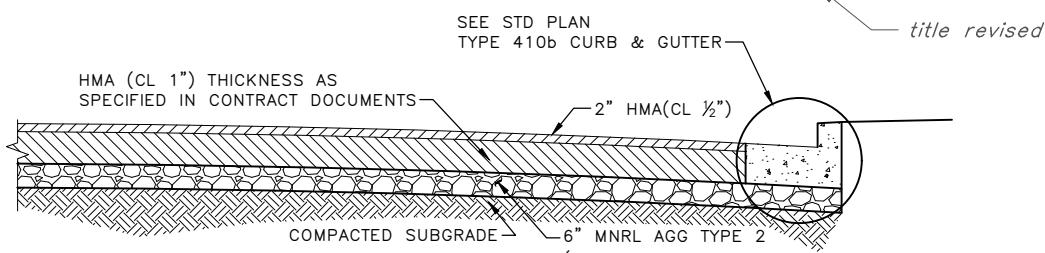

402C-HOT MIX ASPHALT ON CRUSHED ROCK

HMA DESIGN CRITERIA:

1. 10 MILLION ESAL'S UNLESS OTHERWISE SPECIFIED IN CONTRACT DOCUMENTS.
2. ASPHALT PG 58H-22 UNLESS OTHERWISE SPECIFIED IN CONTRACT DOCUMENTS.
3. WARM MIX ASPHALT MAY BE USED IN PLACE OF HMA WHERE SHOWN ON THE DRAWINGS.
4. PROTECT ADJACENT PANELS FROM DAMAGE DUE TO UNDERMINING DURING EXCAVATION & PLACEMENT OF SUBGRADE. SEE SPEC SECTION 1-07.13.


REF STD SPEC SEC 4-04, 5-04, 5-05, 8-04



City of Seattle


NOT TO SCALE

COMMERCIAL AND
ARTERIAL PAVEMENT
SECTIONS

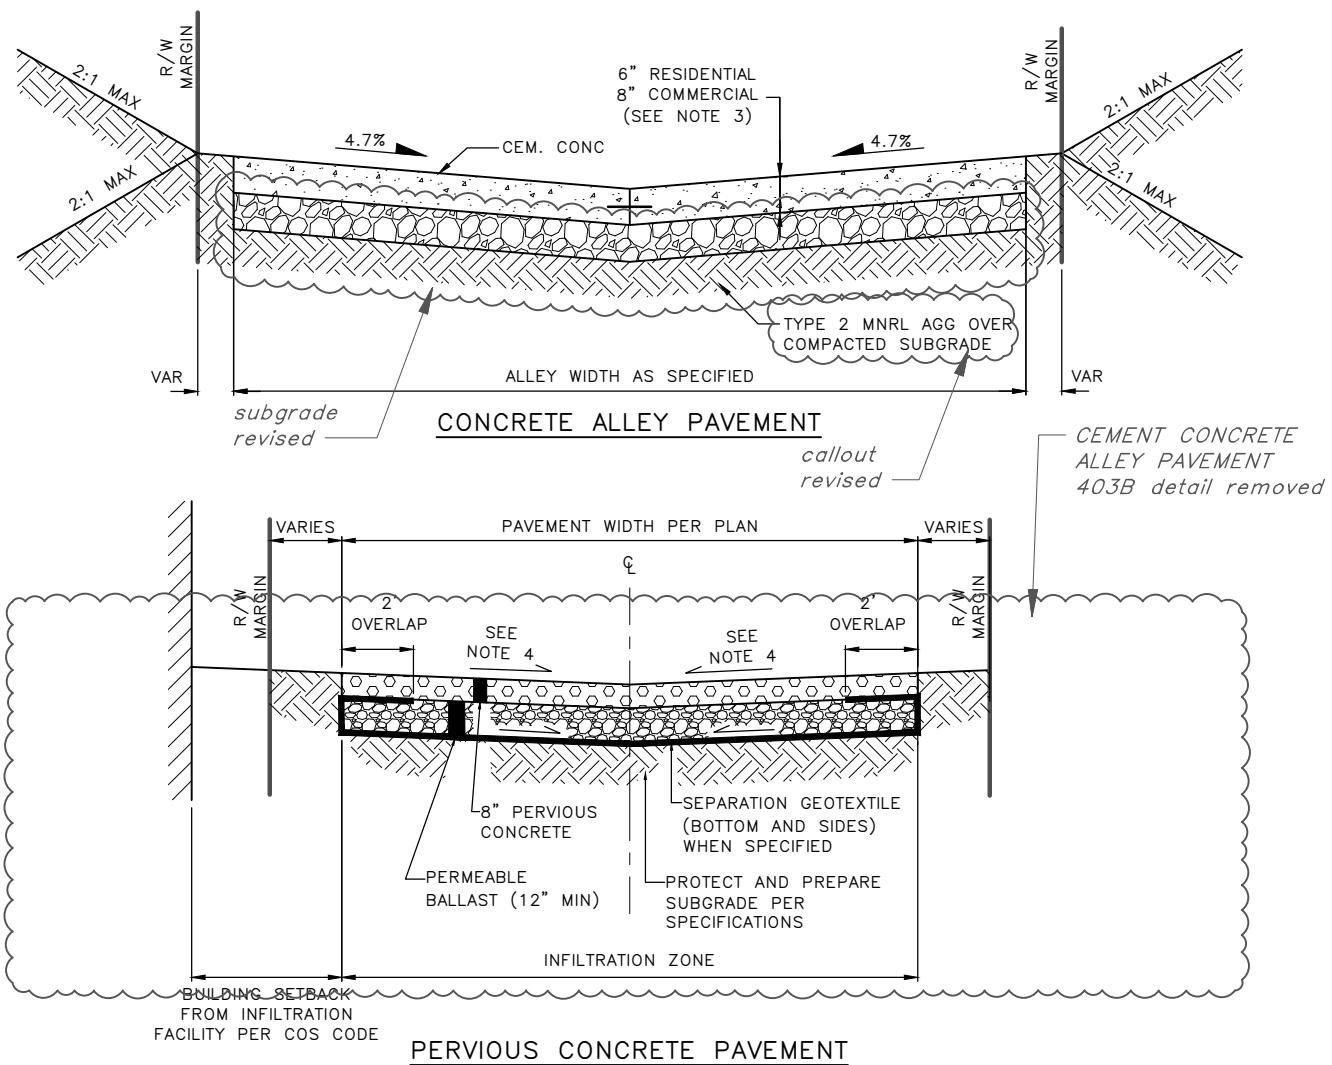
**NOTES:**

1. WHEN ALLEY PAVEMENT IS 16'-0" OR WIDER PLACE CONSTRUCTION JOINT WITH TIE BAR PER STD PLAN NO 405 ALONG CENTERLINE OF ALLEY.
2. FOR ADA ACCESSIBLE ACCESS TO ENTRY IN ALLEY CONSIDER ALTERNATIVE DESIGN; SUBJECT TO APPROVAL BY THE ENGINEER.
3. 8" OR AS SHOWN IN CONTRACT OR APPROVAL BY THE ENGINEER.
4. MIN CROSS SLOPE IS 1%. MAX CROSS SLOPE IS 2%.
5. PERMEABLE BALLAST MUST BE MINERAL AGGREGATE TYPE 13, COS STD SPEC 9.03-13, UNLESS DETERMINED OTHERWISE BY ENGINEER.
6. FOR PERVERSUS CONCRETE ALLEYS, CONTRACTION JOINTS MUST NOT EXCEED 12 FT. FOR PAVEMENT THICKNESS OF 9 IN. OR LESS. FOR THICKER PAVEMENT, CONTRACTION JOINTS MAY BE 15 FT.




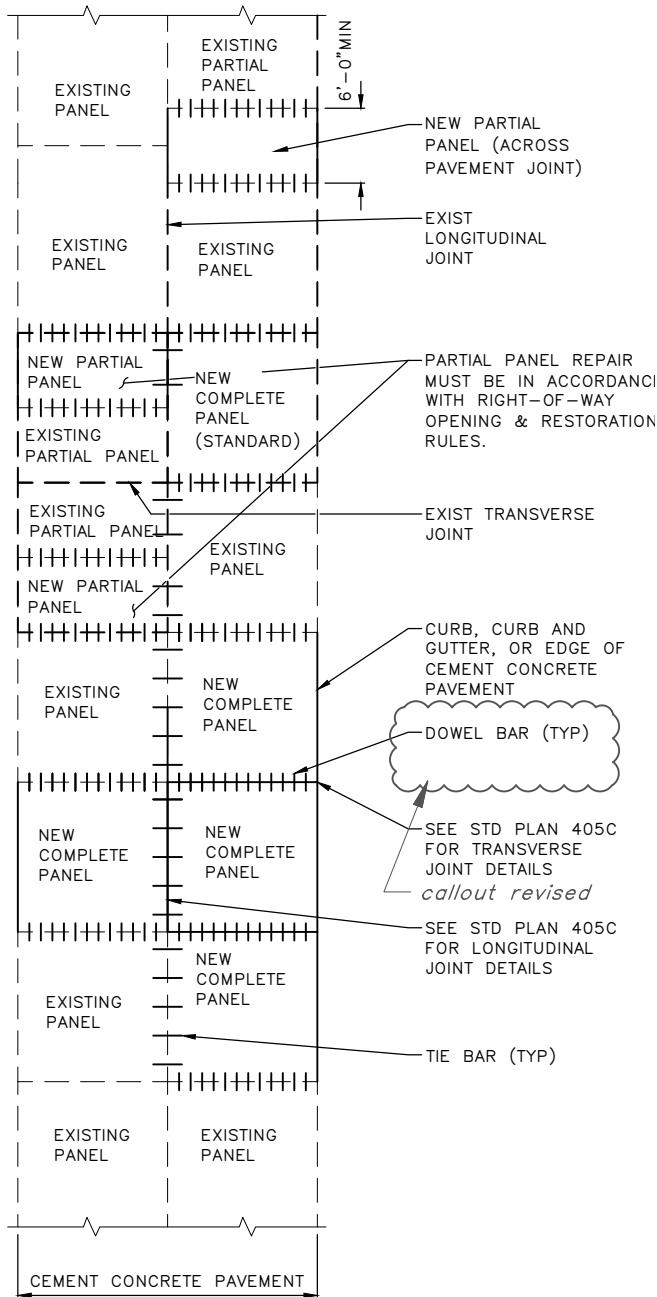

PLAN VIEW
PANEL REPLACEMENT

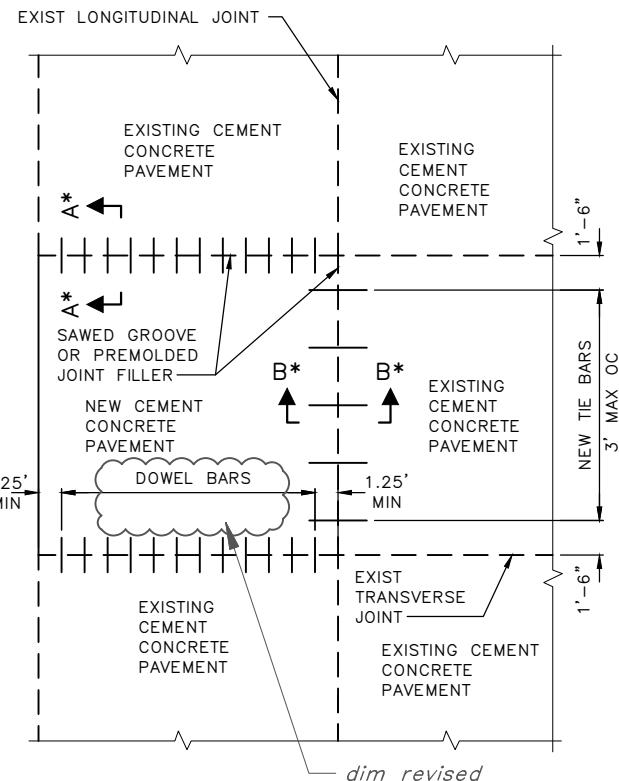

PLAN VIEW
COMPLETE PANEL REPLACEMENT

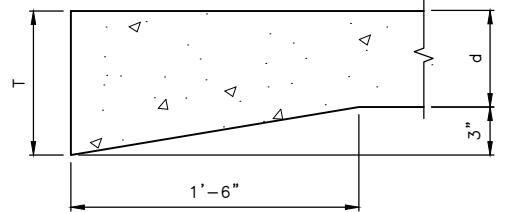

THICKENED EDGE DETAIL
(REQUIRED ONLY WHERE SHOWN ON THE DRAWINGS)

NOTES

1. INSTALL TIE BARS ALONG LONGITUDINAL JOINT BETWEEN FULL PANEL REPLACEMENT AND EXIST CEMENT CONC PAVEMENT. TIE BARS ARE NOT INSTALLED BETWEEN CEMENT CONC PAVEMENT AND HOT MIX ASPHALT SHOULDER.
2. TIE BARS AND DOWELS ARE NOT REQUIRED:
 - 2.1. WHEN INDICATED ON THE DRAWINGS BY "NO TIE BARS" OR "NO DOWEL BARS".
 - 2.2. WHEN EXISTING PAVEMENT IS 8" OR LESS OR WHEN THE ENGINEER DETERMINES THE EXISTING CONC NOT TO BE COMPETENT.
3. DO NOT PLACE LONGITUDINAL JOINTS OR SKEWED JOINTS WITHIN BIKE LANES.
4. WHEN PAVING ADJACENT TO EXISTING PANELS, THE NEW TRANSVERSE JOINTS MUST BE PLACED TO MATCH JOINT LOCATIONS OF THE EXISTING ADJACENT PAVEMENT UNLESS OTHERWISE DIRECTED BY THE ENGINEER. SEE STD PLAN NO 405C FOR MAXIMUM TRANSVERSE JOINT SPACING.

A* SEE SECTION A-A STANDARD PLAN 405b

B* SEE SECTION B-B STANDARD PLAN 405b


REF STD SPEC SEC 5-05



City of Seattle

NOT TO SCALE


ROADWAY CONCRETE
PAVEMENT REPAIR

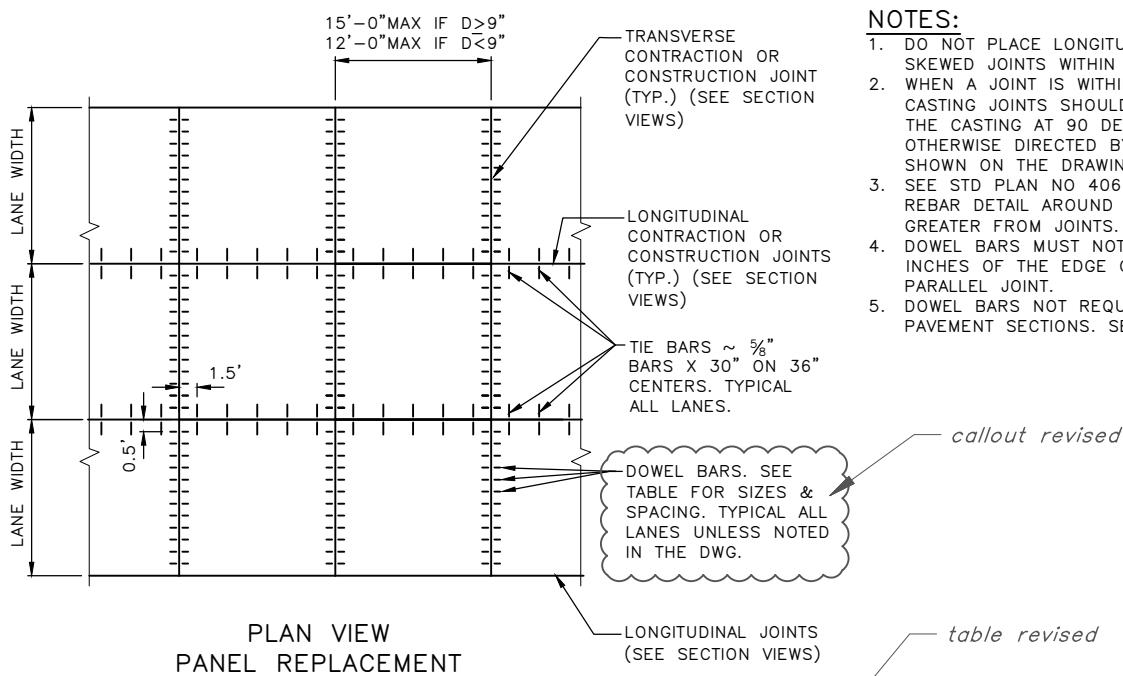


NOTES:

1. DO NOT PLACE LONGITUDINAL JOINTS OR SKEWED JOINTS WITHIN BIKE LANES.
2. WHEN A JOINT IS WITHIN 18 INCHES OF A CASTING JOINTS SHOULD BE SKEWED TO MEET THE CASTING AT 90 DEGREES UNLESS OTHERWISE DIRECTED BY THE ENGINEER OR SHOWN ON THE DRAWINGS.
3. SEE STD PLAN NO 406 OR DRAWINGS FOR REBAR DETAIL AROUND CASTING 18 INCHES OR GREATER FROM JOINTS.
4. DOWEL BARS MUST NOT BE PLACED WITHIN 15 INCHES OF THE EDGE OF PAVEMENT OR A PARALLEL JOINT.
5. DOWEL BARS NOT REQUIRED FOR RESIDENTIAL PAVEMENT SECTIONS. SEE STD PLAN NO 401.


DEPTH (D) OF RDWY CEM. CONC	SOLID STEEL DOWEL BAR SIZE OUTSIDE DIAMETER (OD) X LENGTH (L) @ ON CENTER (OC)	TUBULAR DOWEL BAR SIZE OUTSIDE DIAMETER (OD), WALL THICKNESS X LENGTH (L) @ ON CENTER (OC)
6" ≤ D < 9"	1.00" OD X 18" L @ 12" OC	1.375" OD, 0.120: MIN X 18" L @ 12" OC
9" ≤ D < 11"	1.25" OD X 18" L @ 12" OC	1.375" OD, 0.120: MIN X 18" L @ 12" OC
11" ≤ D	1.50" OD X 18" L @ 12" OC	1.625" OD, 0.120: MIN X 18" L @ 12" OC

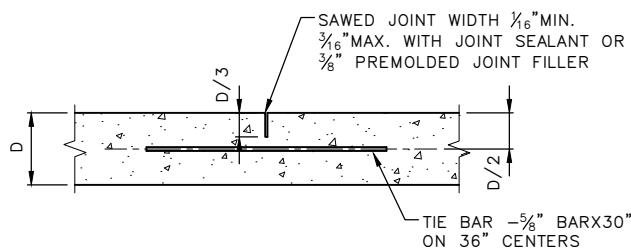


SECTION VIEW
LONGITUDINAL CONTRACTION JOINT

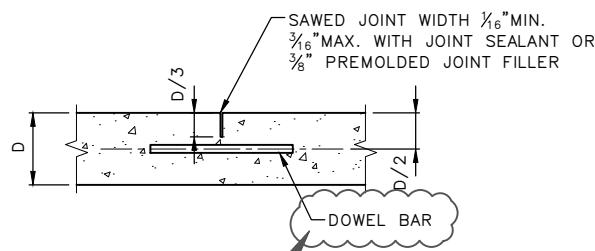

SECTION VIEW
TRANSVERSE CONTRACTION JOINT

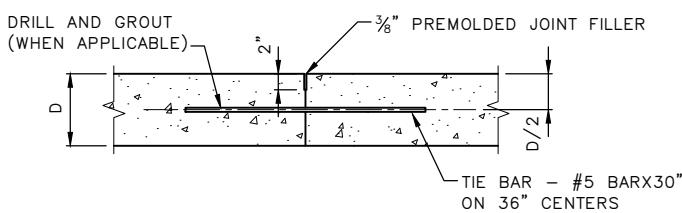


SECTION VIEW
LONGITUDINAL CONSTRUCTION JOINT

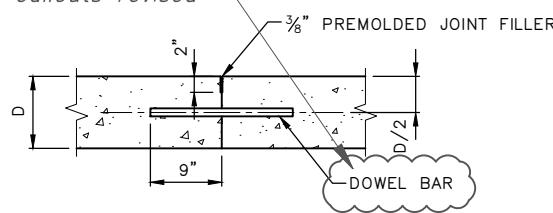


SECTION VIEW
TRANSVERSE CONSTRUCTION JOINT

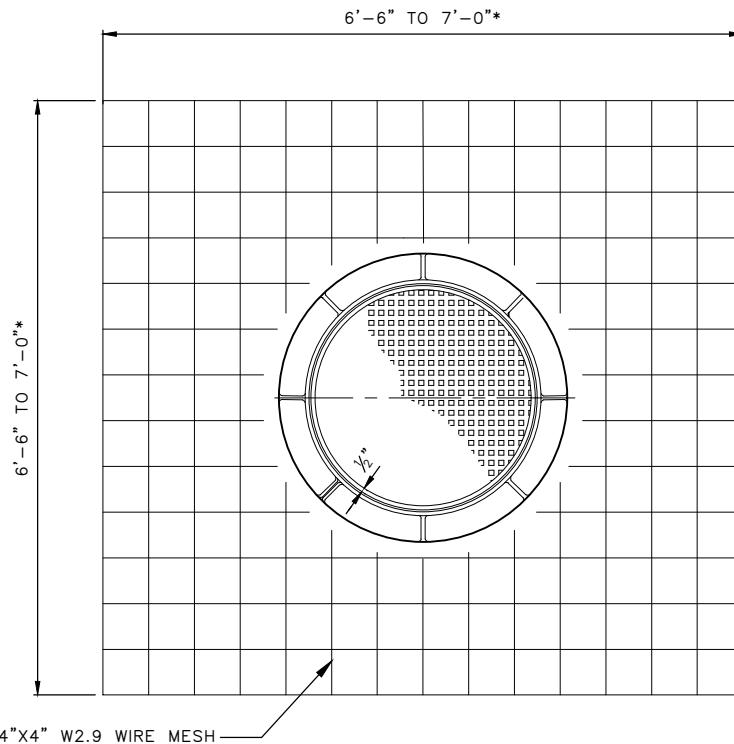

**NOTES:**




1. PLACE WIRE MESH AT $\frac{1}{2}$ DEPTH OF CEMENT CONCRETE.
2. *THE DIMENSIONS OF THE MESH MUST BE ADJUSTED WHERE PAVEMENT JOINTS ARE ENCOUNTERED.
3. NO REINFORCING STEEL MUST BE WITHIN $2\frac{1}{2}$ INCHES (3 INCHES DESIRED) OF ANY CEMENT CONCRETE SURFACE OR JOINT.

note 3 revised

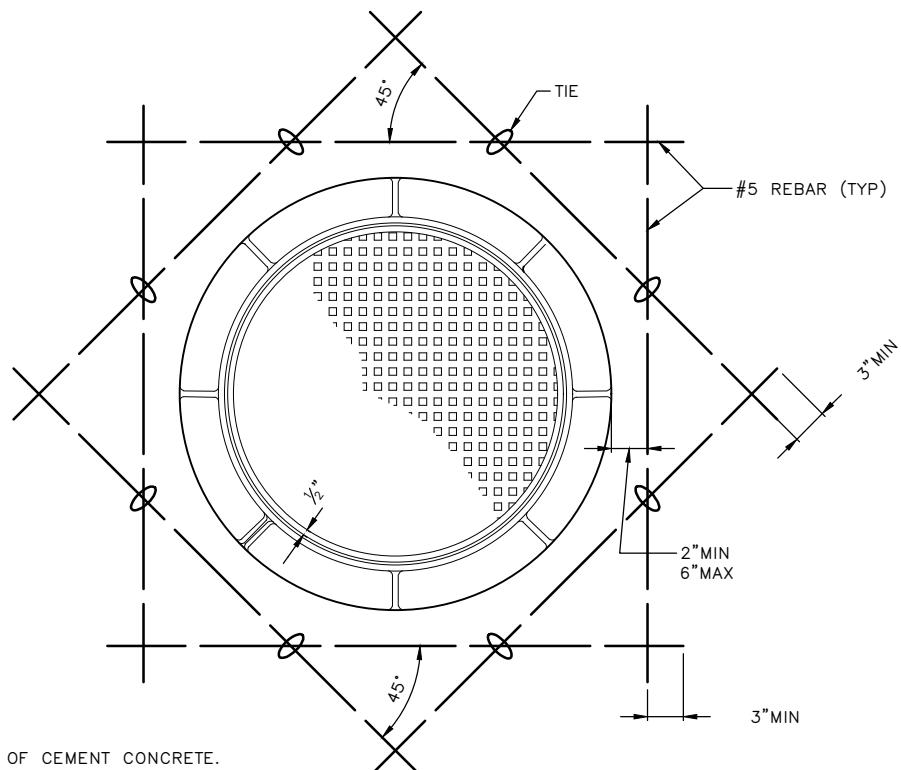**NOTES:**

1. PLACE REBAR AT $\frac{1}{2}$ DEPTH OF CEMENT CONCRETE.
2. NO REINFORCING STEEL MUST BE WITHIN $2\frac{1}{2}$ INCHES (3 INCHES DESIRED) OF ANY CEMENT CONCRETE SURFACE OR JOINT.

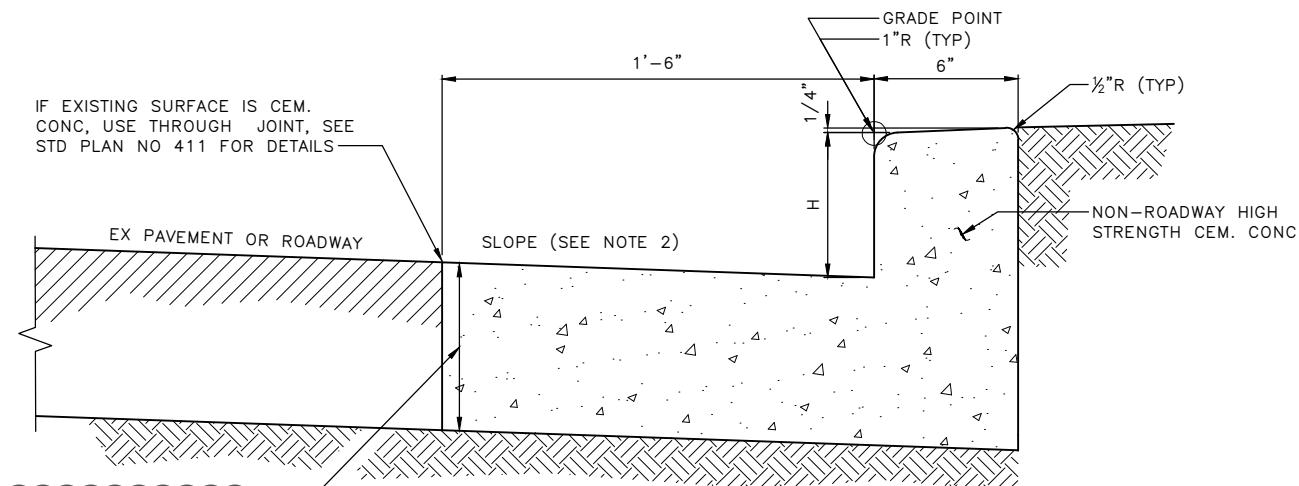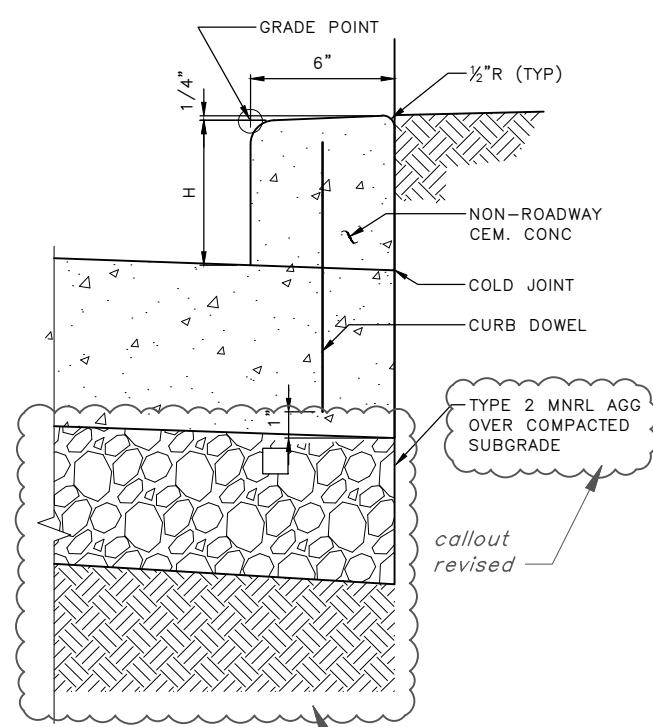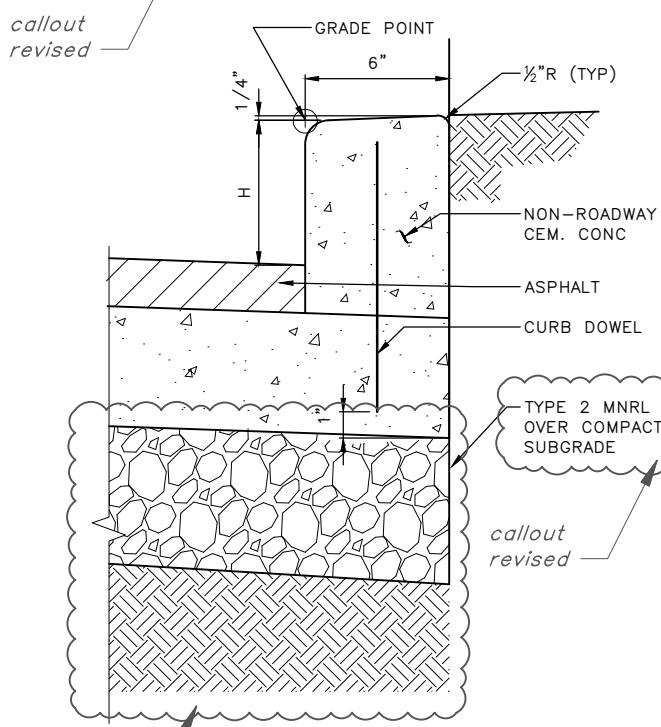

410B CURB & GUTTER410C CURB**NOTES:**

1. "H" MUST BE 6" FROM FINISHED ROADWAY GRADE UNLESS OTHERWISE SHOWN ON DRAWINGS
2. GUTTER MUST BE SLOPED THE SAME AS ADJACENT PAVEMENT OR 2% MIN, WHICHEVER IS GREATER.
3. SEE STD PLAN NO 411 FOR CURB DOWELS


REF STD SPEC SEC 8-04



City of Seattle


NOT TO SCALE

TYPE 410 CURB

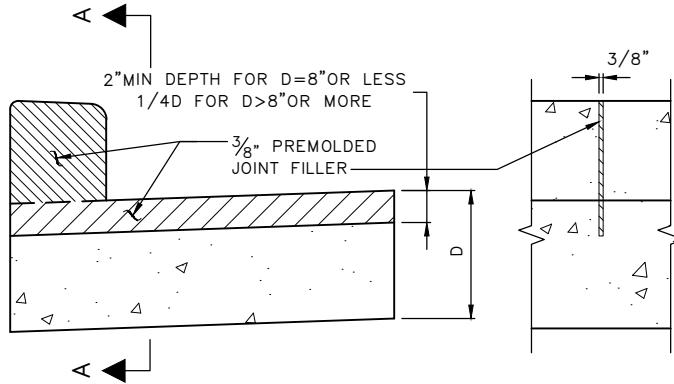


CONTRACTION JOINT FOR CURB OR CURB & GUTTER

SECTION A-A

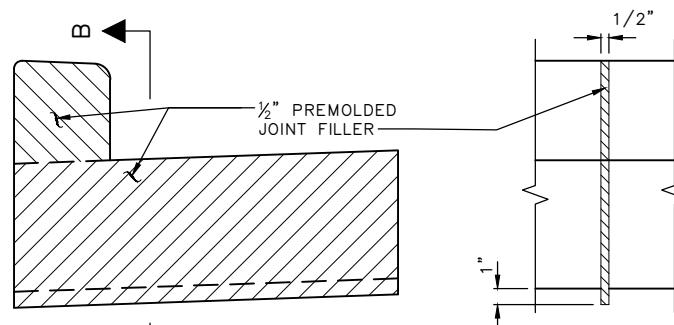

THROUGH JOINT FOR CURB OR CURB & GUTTER

SECTION B-B

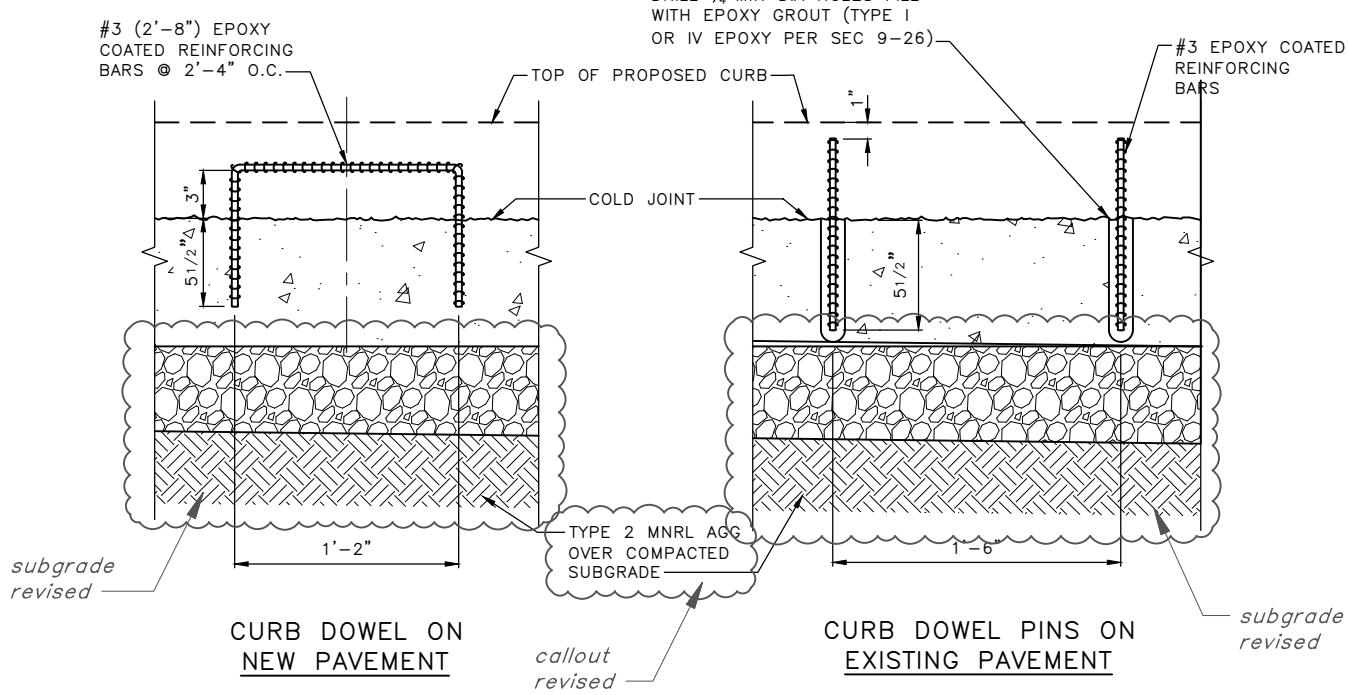

DOWELS FOR DOWELLED CURB CONSTRUCTION

REF STD SPEC SEC 8-04



City of Seattle

NOT TO SCALE

CURB JOINTS & DOWELS

400 STREET PAVING & APPURTENANCES

STANDARD PLAN NO 422a



REV DATE: MAR 2023

NOTES:



note 2 & 4 revised,
note 3 added

1. RAMP CENTERLINE MUST BE RADIAL/PERPENDICULAR TO THE ALIGNMENT OF THE FACE OF CURB.
2. THE SLOPE ON THE LANDING MUST BE A MINIMUM OF 0.5% IN ANY ONE DIRECTION AND MUST NOT EXCEED 2% IN THE APPLICABLE DIRECTION OF TRAVEL. UPPER LANDING AT THE TOP OF THE CURB RAMP MUST MATCH THE FULL WIDTH OF THE RAMP AND MUST HAVE A MINIMUM DEPTH OF 4'-0".
3. IF THE LANDING IS LIMITED AT THE BACK-OF-SIDEWALK BY A PERMANENT VERTICAL BARRIER, THE DEPTH OF THE TURNING SPACE MUST BE 5'-0" MINIMUM.
4. WINGS MUST HAVE A MAXIMUM SLOPE OF 10%. WINGS MUST HAVE A BRUSHED FINISH PARALLEL TO THE CURB. THE CONCRETE WALK THICKENED EDGE ALONG THE CURB MUST CONTINUE THROUGH EACH WING. WINGS MUST BE MONOLITHIC WITH THE CURB RAMP RUN.
5. RAMP SURFACE MUST HAVE A HEAVY BROOM BRUSHED SURFACE PARALLEL TO THE CURB.
6. REFER TO DETAILS 422K AND 422L FOR GENERAL NOTES AND TYPICAL SECTIONS.
7. RAMP WIDTH MUST BE 5'-0" MINIMUM WHEN SIDE CURB IS USED ON BOTH SIDES INSTEAD OF WINGS.


 = MAX SLOPE IN EITHER DIRECTION

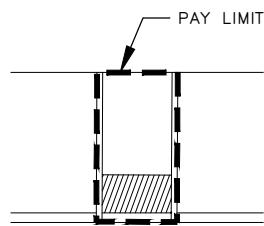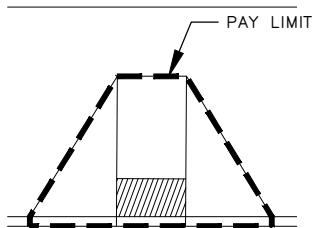

PAY LIMITS

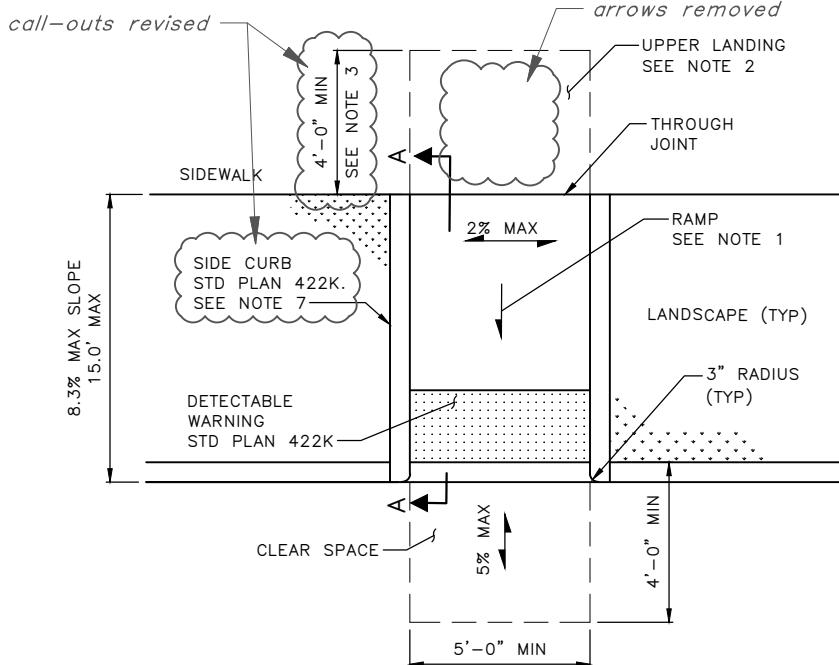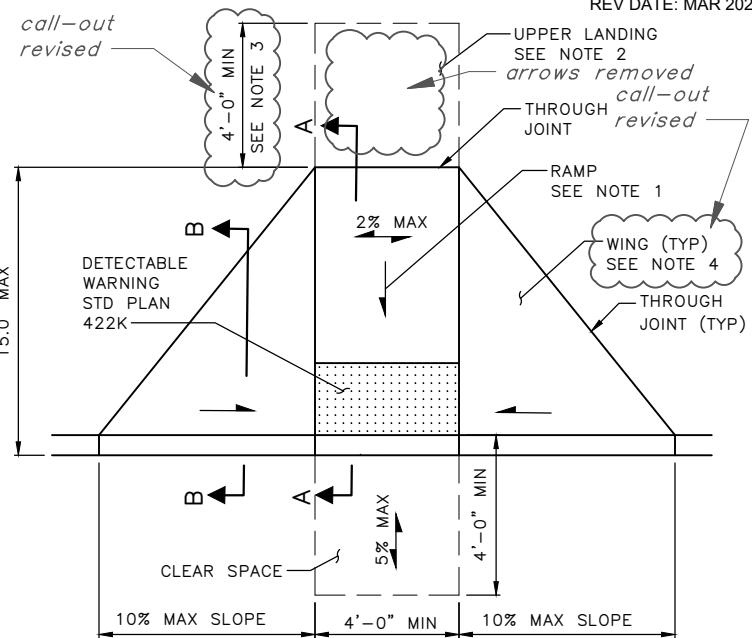

PERPENDICULAR CURB RAMPS (TYPE 422A)

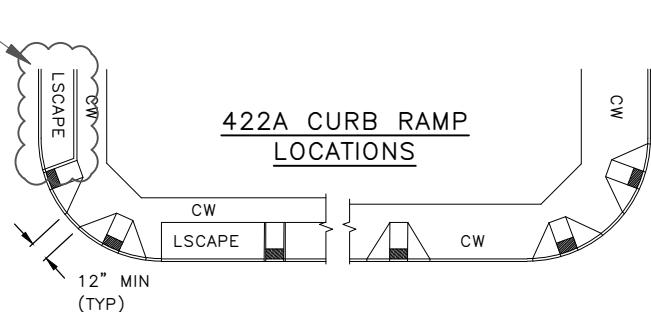


REF STD SPEC SEC 8-14



City of Seattle

NOT TO SCALE


CURB RAMP DETAILS

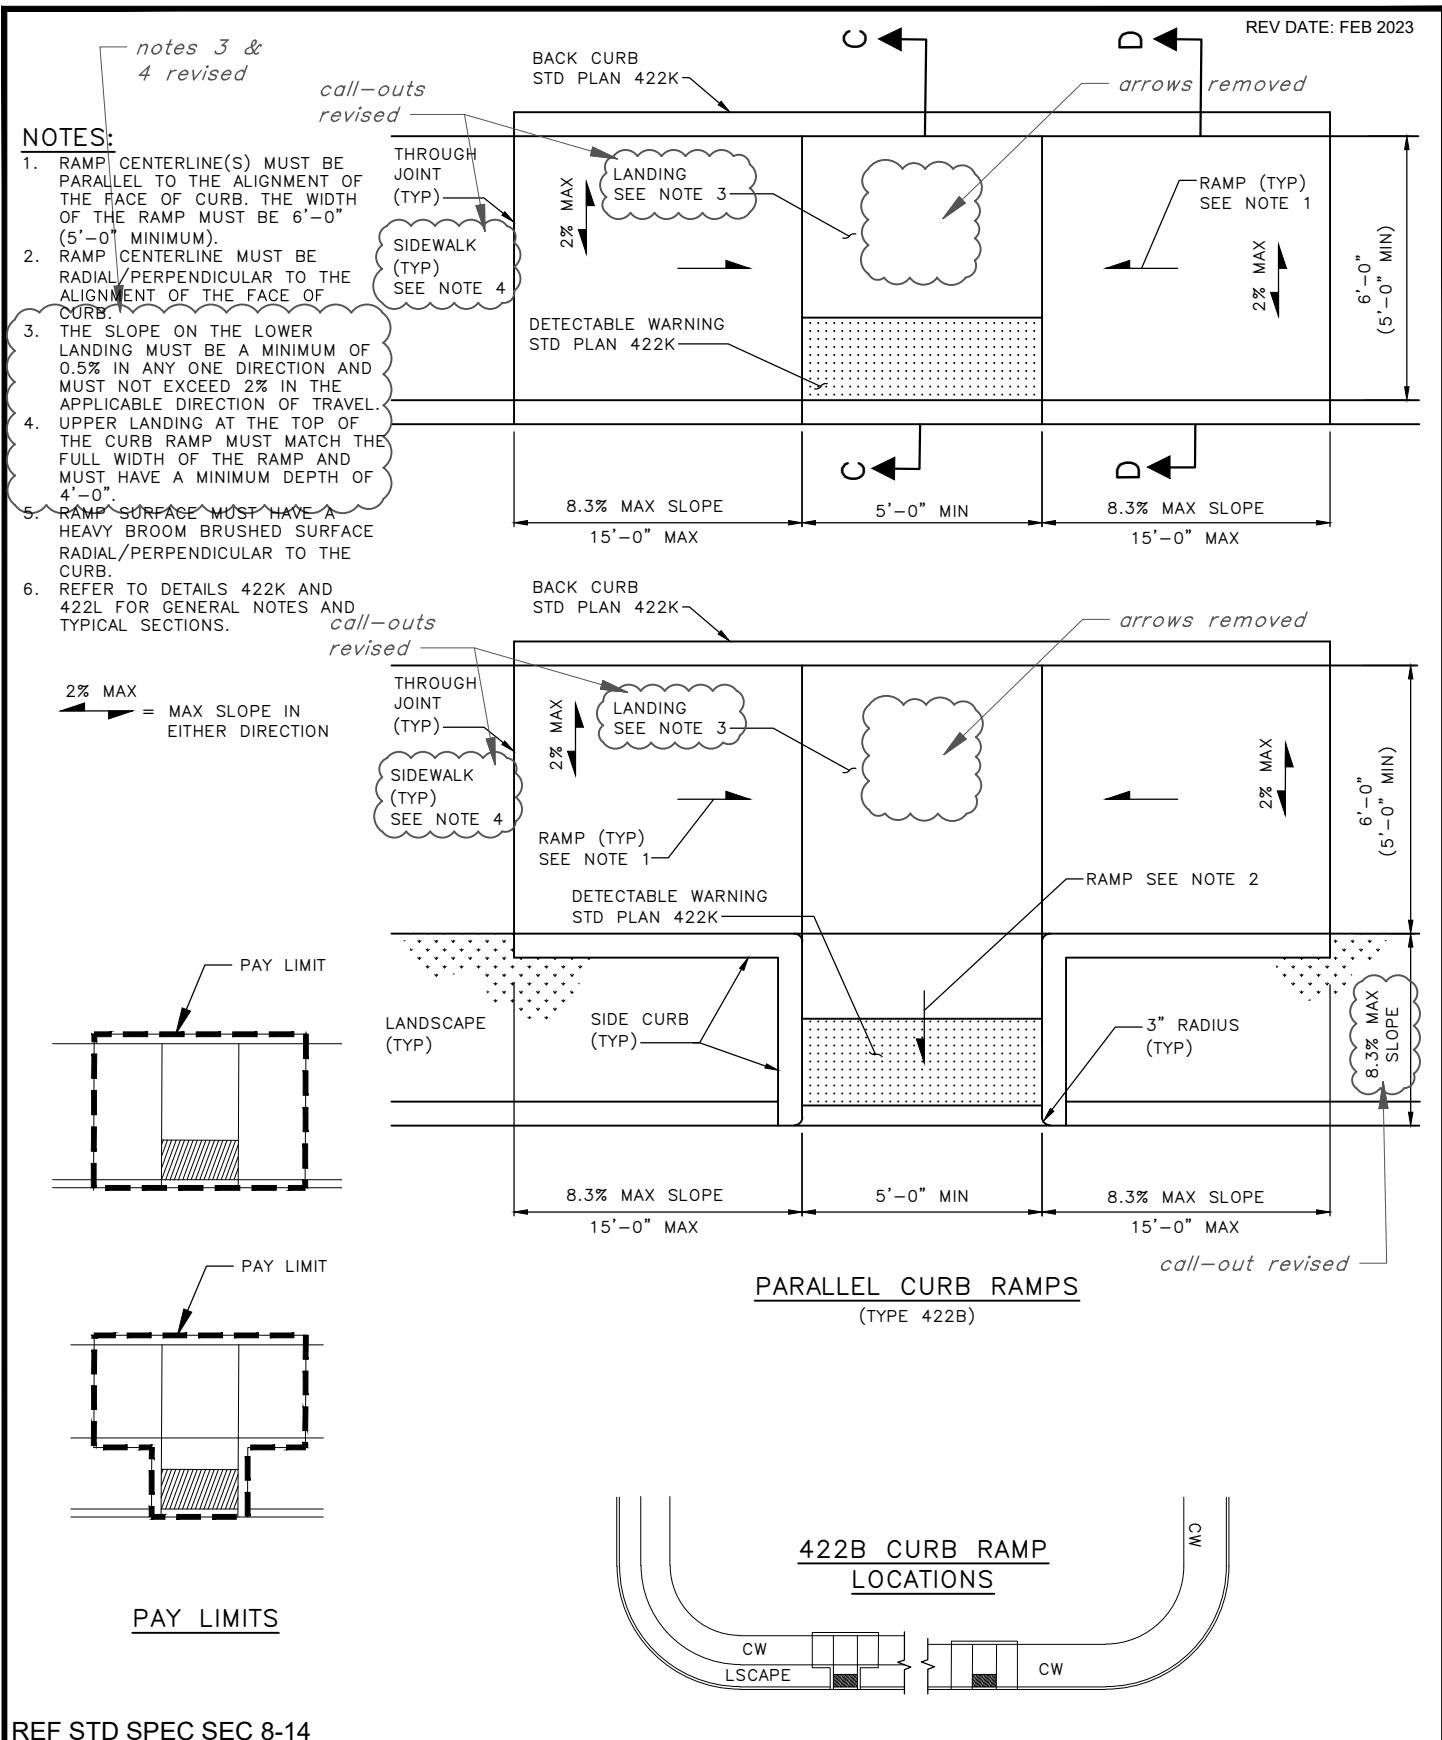

NOTES:

1. RAMP CENTERLINE MUST BE PARALLEL TO CROSSWALK AND/OR THE SIDEWALK.
2. THE SLOPE ON THE LANDING MUST BE A MINIMUM OF 0.5% IN ANY ONE DIRECTION AND MUST NOT EXCEED 2% IN THE APPLICABLE DIRECTION OF TRAVEL. UPPER LANDING AT THE TOP OF THE CURB RAMP MUST MATCH THE FULL WIDTH OF THE RAMP AND MUST HAVE A MINIMUM DEPTH OF 4'-0".
3. IF THE LANDING IS LIMITED AT THE BACK-OF-SIDEWALK BY A PERMANENT VERTICAL BARRIER, THE DEPTH OF THE TURNING SPACE MUST BE 5'-0" MINIMUM, MEASURED PARALLEL TO THE RUN OF THE CURB RAMP.
4. WINGS MUST HAVE A MAXIMUM SLOPE OF 10%. WINGS MUST HAVE A BRUSHED FINISH PARALLEL TO THE CURB. THE CONCRETE WALK THICKENED EDGE ALONG THE CURB MUST CONTINUE THROUGH EACH WING. WINGS MUST BE MONOLITHIC WITH THE CURB RAMP RUN.
5. WING ON THE OPEN SIDE OF THE CURB RAMP MUST HAVE A MINIMUM SLOPE OF 5% TO ASSIST PEDESTRIANS WITH VISUAL IMPAIRMENTS WHERE THE DETECTABLE WARNING SURFACE IS OFFSET FROM THE CURB LINE.
6. RAMP SURFACE MUST HAVE A HEAVY BROOM BRUSHED FINISH PERPENDICULAR TO THE PATH OF TRAVEL.
7. REFER TO DETAILS 422k AND 422i FOR GENERAL NOTES AND TYPICAL SECTIONS.

2% MAX
 = MAX SLOPE IN
EITHER DIRECTION

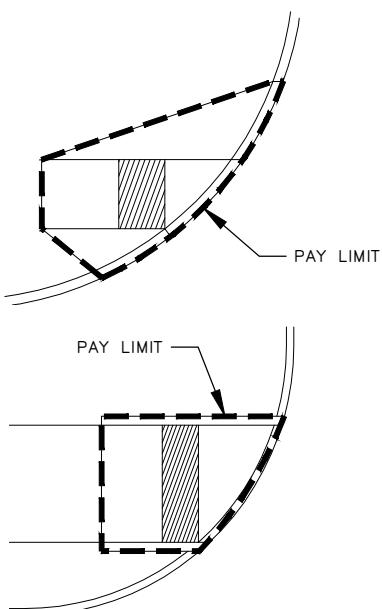

PAY LIMITS

REF STD SPEC SEC 8-14



City of Seattle

NOT TO SCALE

CURB RAMP DETAILS

2023 Edition City of Seattle Standard Plans for Municipal Construction




notes 2, 3 & 4 revised

NOTES:


1. RAMP CENTERLINE MUST BE PARALLEL TO CROSSWALK AND/OR THE SIDEWALK.
2. THE SLOPE ON THE LANDING MUST BE A MINIMUM OF 0.5% IN ANY ONE DIRECTION AND MUST NOT EXCEED 2% IN THE APPLICABLE DIRECTION OF TRAVEL. UPPER LANDING AT THE TOP OF THE CURB RAMP MUST MATCH THE FULL WIDTH OF THE RAMP AND MUST HAVE A MINIMUM DEPTH OF 4'-0".
3. IF THE LANDING IS LIMITED AT THE BACK-OF-SIDEWALK BY A PERMANENT VERTICAL BARRIER, THE DEPTH OF THE TURNING SPACE MUST BE 5'-0" MINIMUM, MEASURED PARALLEL TO THE RUN OF THE CURB RAMP.
4. WINGS MUST HAVE A MAXIMUM SLOPE OF 10%. WINGS MUST HAVE A BRUSHED FINISH PARALLEL TO THE CURB. THE CONCRETE WALK THICKENED EDGE ALONG THE CURB MUST CONTINUE THROUGH EACH WING. WINGS MUST BE MONOLITHIC WITH THE CURB RAMP RUN.
5. WHERE THE SETBACK FROM THE BOTTOM OF THE CURB RAMP TO THE BACK OF CURB LINE EXCEEDS 5'-0", THE DETECTABLE WARNING SURFACE MUST BE INSTALLED AT THE BACK OF CURB (NOT AT THE BOTTOM OF RAMP). RADIAL TILE MUST BE USED. CUTTING OR ALTERING DETECTABLE WARNING SURFACE MUST BE FIRST APPROVED BY THE ENGINEER.
6. DIRECTIONAL CURB RAMPS WITH LARGE SETBACK FROM BACK OF CURB TO BOTTOM OF THE CURB RAMP ARE NOT PREFERRED DESIGNS BUT MAY BE USED IF NECESSARY DUE TO EXISTING SITE CONSTRAINTS.
7. RAMP SURFACE MUST HAVE A HEAVY BROOM BRUSHED FINISH PERPENDICULAR TO THE PATH OF TRAVEL.
8. REFER TO DETAILS 422K AND 422L FOR GENERAL NOTES AND TYPICAL SECTIONS.

2% MAX = MAX SLOPE IN EITHER DIRECTION

previous note 6 removed

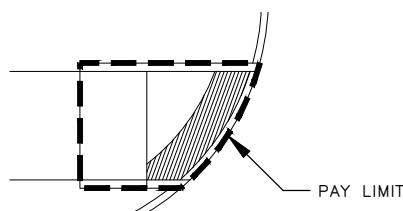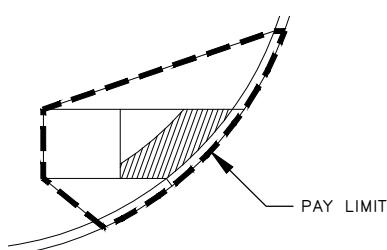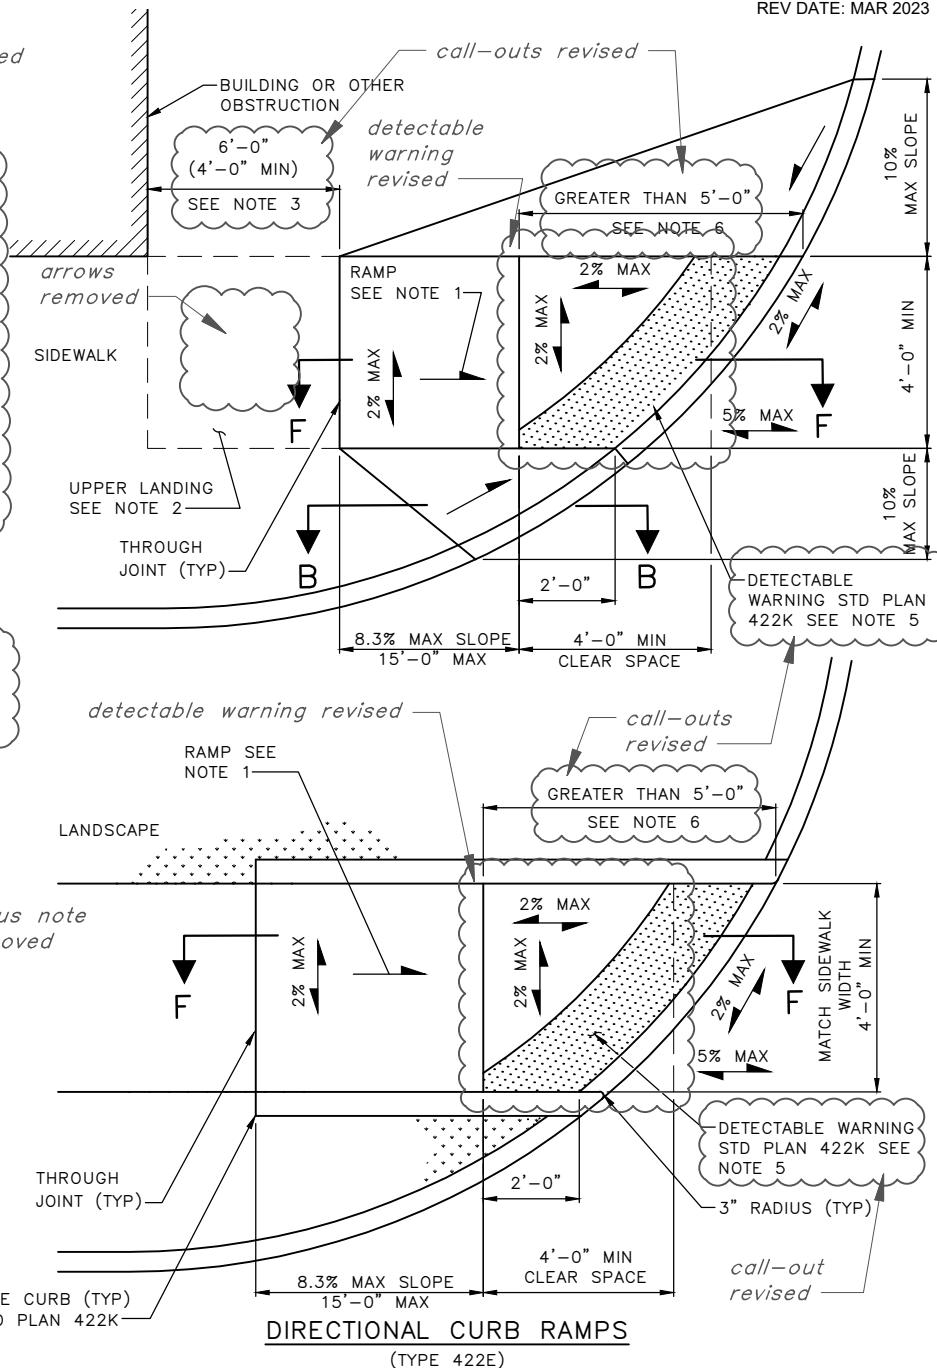

PAY LIMITS

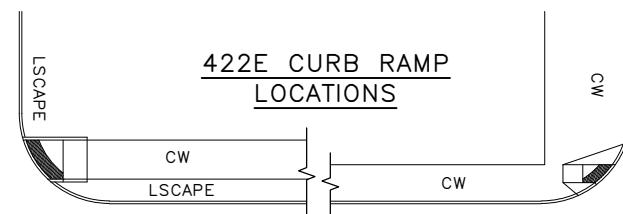

REF STD SPEC SEC 8-14



City of Seattle

NOT TO SCALE


CURB RAMP DETAILS

notes 2 & 3 revised



NOTES:

- RAMP CENTERLINE MUST BE RADIAL/PERPENDICULAR TO THE ALIGNMENT OF THE FACE OF CURB.
- THE SLOPE ON THE LANDING MUST BE A MINIMUM OF 0.5% IN ANY ONE DIRECTION AND MUST NOT EXCEED 2% IN THE APPLICABLE DIRECTION OF TRAVEL. UPPER LANDING AT THE TOP OF THE CURB RAMP MUST MATCH THE FULL WIDTH OF THE RAMP AND MUST HAVE A MINIMUM DEPTH OF 4'-0".
- IF THE LANDING IS LIMITED AT THE BACK-OF-SIDEWALK BY A PERMANENT VERTICAL BARRIER, THE DEPTH OF THE TURNING SPACE MUST BE 5'-0" MINIMUM, MEASURED PARALLEL TO THE RUN OF THE CURB RAMP.
- CLEAR SPACE AT THE BOTTOM OF THE RAMP MUST BE 5'-0" MINIMUM IN WIDTH AND MUST EXTEND A MINIMUM OF 4'-0" BEYOND THE RAMP LOWER GRADE BREAK. THE CLEAR SPACE MUST FALL WHOLLY WITHIN THE LEGAL CROSSWALK, MARKED OR UNMARKED. THE CLEAR SPACE MUST FIT BEHIND LINES EXTENDING FROM THE FACE OF CURB RUNNING PARALLEL TO EACH ROADWAY. THERE IS NO ALLOWABLE EXEMPTION FOR MINIMUM CLEAR SPACE REQUIREMENTS AT SHARED DIAGONAL PERPENDICULAR CURB RAMPS.
- DETECTABLE WARNING SURFACE MUST BE 8" MAXIMUM FROM FACE OF CURB.
- WINGS MUST HAVE A MAXIMUM SLOPE OF 10%. WINGS MUST HAVE A BRUSHED FINISH PARALLEL TO THE CURB. THE CONCRETE WALK THICKENED EDGE ALONG THE CURB MUST CONTINUE THROUGH EACH WING. WINGS MUST BE MONOLITHIC WITH THE CURB RAMP RUN.
- RAMP SURFACE MUST HAVE A HEAVY BROOM BRUSHED SURFACE PARALLEL TO THE CURB.
- REFER TO DETAILS 422K AND 422L FOR GENERAL NOTES AND TYPICAL SECTIONS.

 = MAX SLOPE IN EITHER DIRECTION

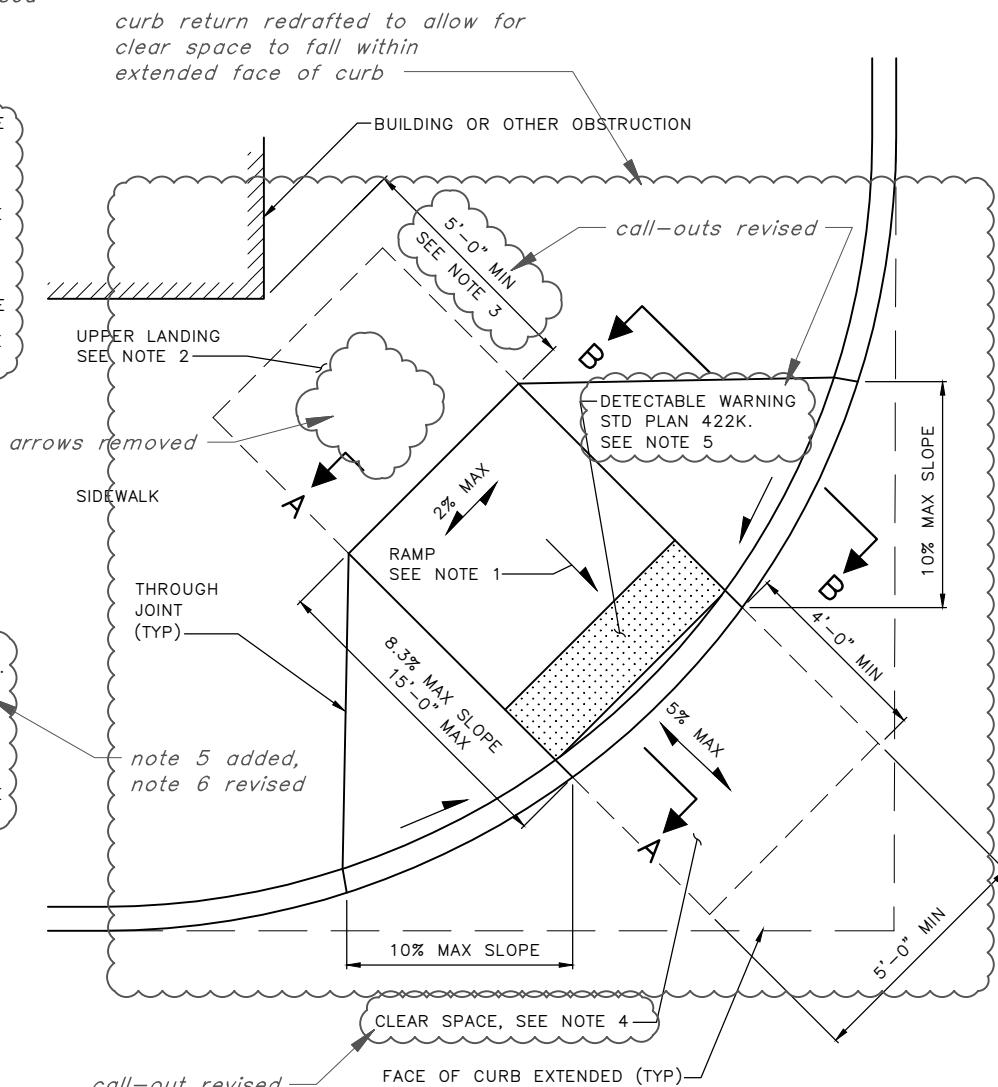

SHARED DIAGONAL PERPENDICULAR CURB RAMP
(TYPE 422f)

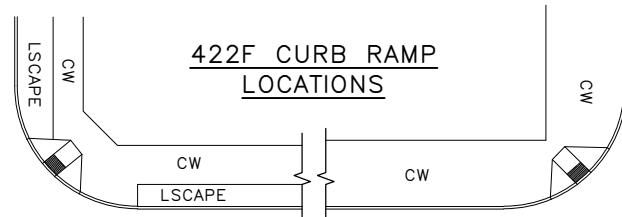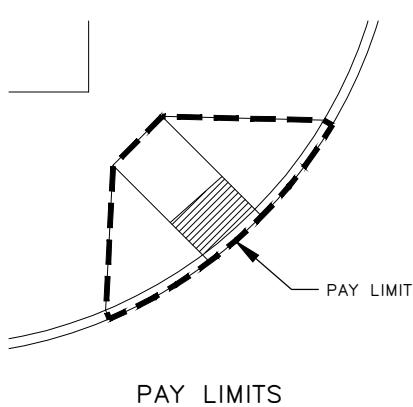

REF STD SPEC SEC 8-14



City of Seattle




NOT TO SCALE

CURB RAMP DETAILS


NOTES:

1. THE SIDEWALK MUST TRANSITION DOWN TO THE ROADWAY WITH A MAXIMUM RUNNING SLOPE OF 5%. THE CROSS SLOPE ON THE TRANSITION MUST NOT EXCEED 2% AT ANY POINT.
2. A BYPASS ROUTE MUST BE PROVIDED AT THE TOP OF THE BLENDED TRANSITION WITH A MINIMUM WIDTH OF 6'-0" (4'-0" MIN). THE CROSS SLOPE OF THE BYPASS ROUTE MUST BE A MINIMUM OF 0.5% IN ANY DIRECTION AND MUST NOT EXCEED 2% IN THE APPLICABLE DIRECTION OF TRAVEL.
3. RADIAL TILE MUST BE USED, CUTTING OR ALTERING DETECTABLE WARNING SURFACES MUST BE FIRST APPROVED BY THE ENGINEER.
4. WINGS MUST HAVE A MAXIMUM SLOPE OF 10%. WINGS MUST HAVE A BRUSHED FINISH PARALLEL TO THE CURB. THE CONCRETE WALK THICKENED EDGE ALONG THE CURB MUST CONTINUE THROUGH EACH WING. WINGS MUST BE MONOLITHIC WITH THE CURB RAMP RUN.
5. BLENDED TRANSITION SURFACE MUST HAVE A HEAVY BROOM BRUSHED SURFACE RADIAL/PERPENDICULAR TO THE CURB.
6. REFER TO DETAILS 422K AND 422L FOR GENERAL NOTES AND TYPICAL SECTION B.


2% MAX = MAX SLOPE IN EITHER DIRECTION

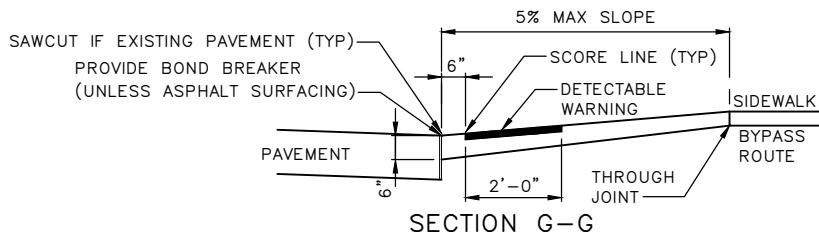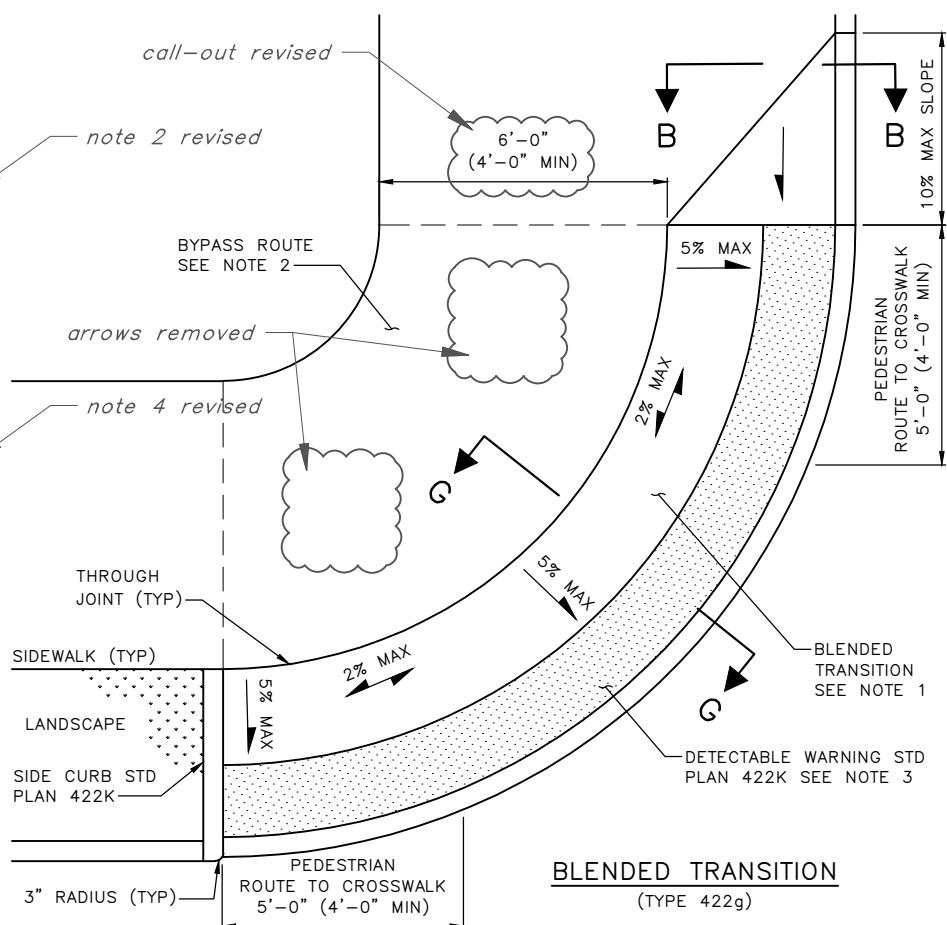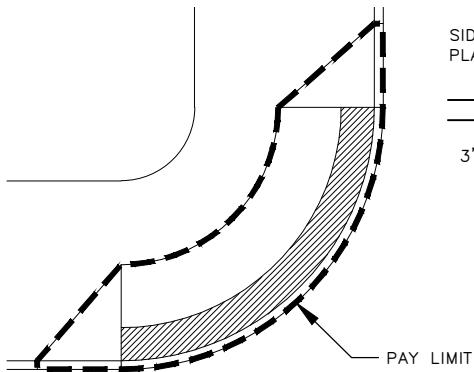

CURB MONOLITHIC WITH RAMP. NEW PAVEMENT BLOCKED OUT FULL DEPTH. EXISTING PAVEMENT REMOVED AT FACE OF CURB

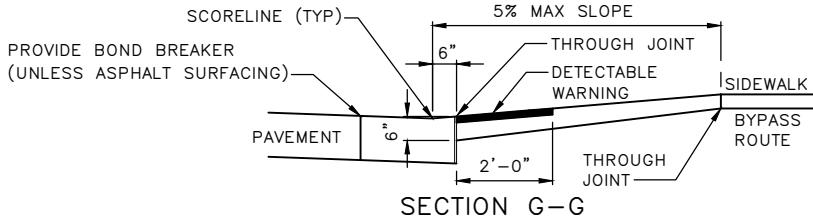

DEPRESSED CURB & GUTTER SEPARATE FROM RAMP.

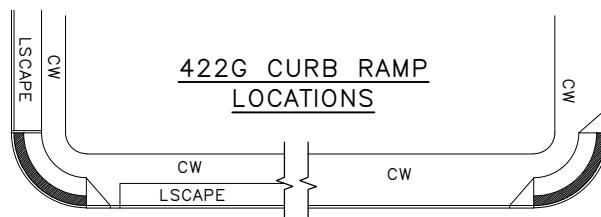

REF STD SPEC SEC 8-14



City of Seattle




NOT TO SCALE

CURB RAMP DETAILS

NOTES:

1. SIZE, SHAPE, AND/OR DIMENSIONS OF CHANNELIZING ISLANDS OR PEDESTRIAN REFUGE ISLANDS MAY VARY. DETAILS SHOWN ARE INTENDED TO SHOW MINIMUM REQUIRED CLEARANCES AND DETECTABLE WARNING SURFACE PLACEMENT LOCATIONS.
2. ACCESS THROUGH CHANNELIZING ISLANDS OR PEDESTRIAN REFUGE ISLANDS MAY BE CUT-THROUGH OR ACCESS MAY BE PROVIDED ~~USING STANDARD CURB RAMP DETAILS.~~
3. AT PEDESTRIAN REFUGE ISLANDS, DETECTABLE WARNING MUST NOT TO BE INSTALLED IF THE REFUGE AREA IS LESS THAN 6'-0" IN DEPTH (IN THE DIRECTION OF TRAVEL).
4. PROVIDE A MINIMUM 4'-0" WIDTH ~~4'-0"~~ DEPTH CLEAR SPACE FOR ACCESS FROM THE CHANNELIZING ISLAND OR PEDESTRIAN REFUGE ISLAND FOR EACH CROSSWALK.

2% MAX
MAX SLOPE IN EITHER DIRECTION

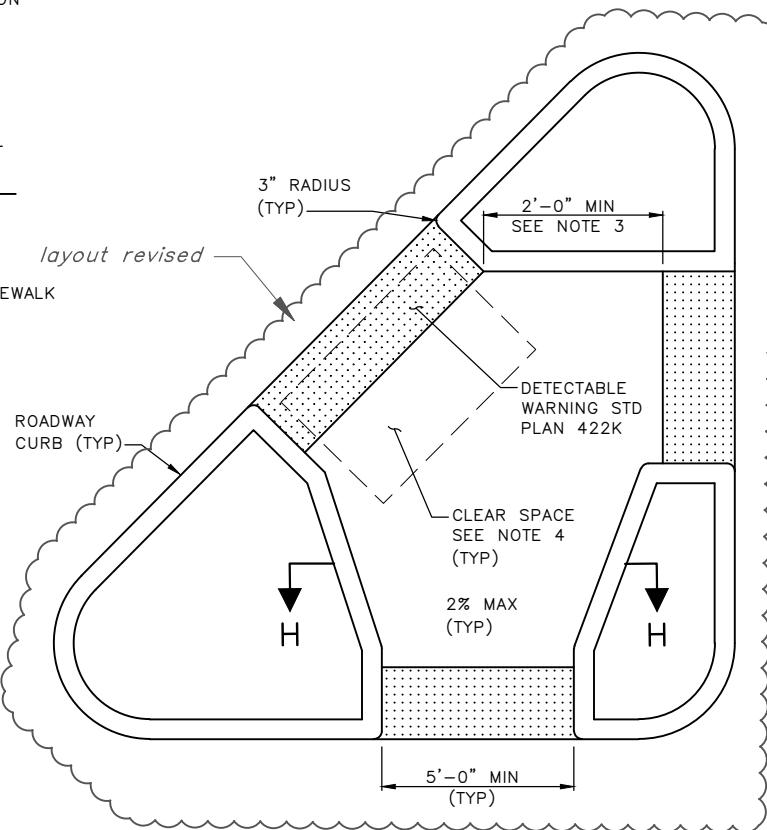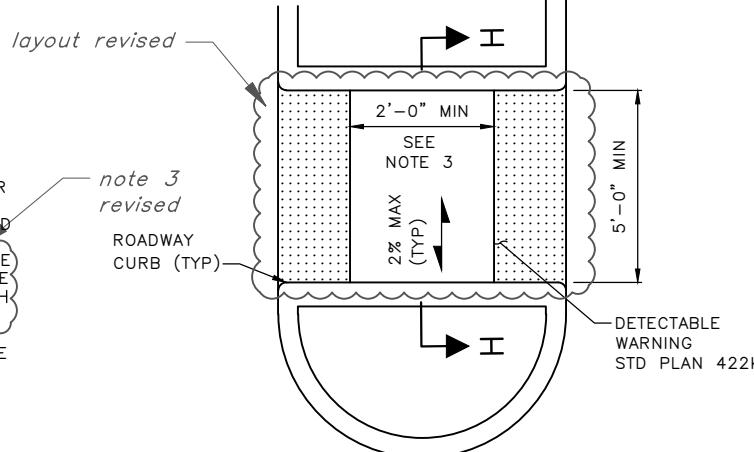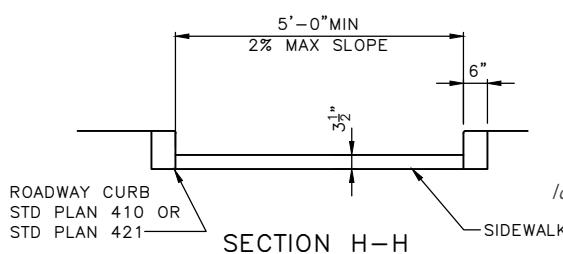

ISLAND CUT-THROUGHS
(TYPE 422H)

REF STD SPEC SEC 8-14



City of Seattle


NOT TO SCALE

CURB RAMP DETAILS


new standard plan

LENGTH PER THE DRAWINGS
5'-0" MAX
1'-0" MIN.


REV DATE: OCT 2022

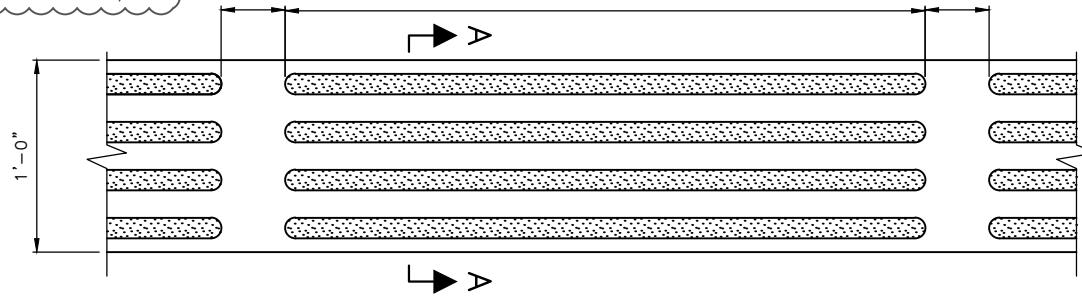


DETECTABLE DIRECTIONAL STRIP – SURFACE APPLIED

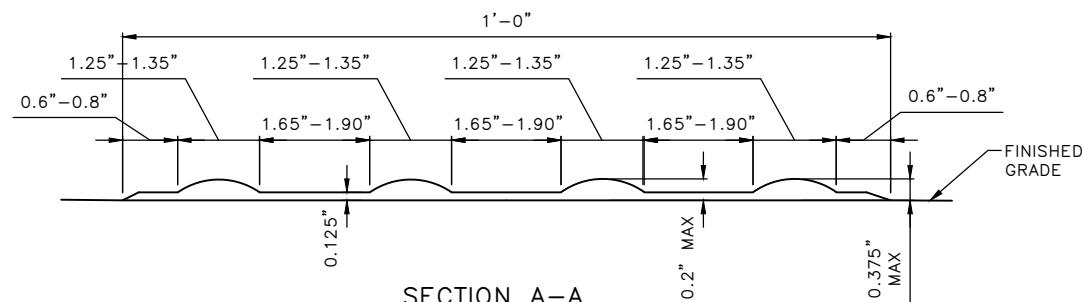

SECTION A-A

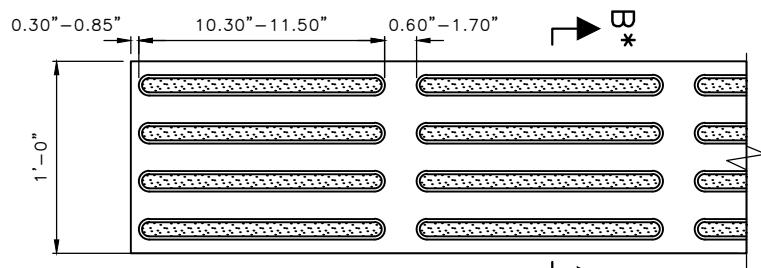

DETECTABLE DIRECTIONAL STRIP - CAST-IN-PLACE

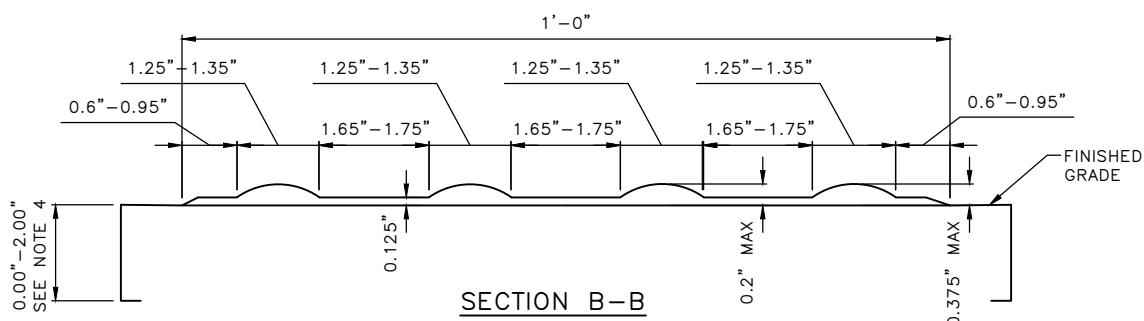

SECTION B-B

NOTES:

NOTES:

1. DETECTABLE DIRECTIONAL STRIP MUST BE "FEDERAL YELLOW", UNLESS OTHERWISE APPROVED BY THE ENGINEER.
2. STRIP CENTERLINE MUST BE PARALLEL TO THE ALIGNMENT OF THE PEDESTRIAN ACCESS ROUTE.
3. METHYL METHACRYLATE (MMA) DIRECTIONAL STRIP MUST COMPLY WITH ALL THE DIMENSIONS RANGES SHOWN ON THIS STANDARD PLAN FOR SURFACE APPLIED.
4. CAST-IN-PLACE DIRECTIONAL STRIP MAY BE BOLTED DOWN IF APPROVED BY THE ENGINEER.

REF STD SPEC SEC 8-14, 9-36



City of Seattle

NOT TO SCALE

DETECTABLE DIRECTIONAL STRIP

CURB RAMP GENERAL NOTES:

1. TWO CURB RAMPS MUST BE INSTALLED AT EACH CORNER UNLESS OTHERWISE DIRECTED BY ENGINEER. SHARED DIAGONAL PERPENDICULAR RAMPS MUST NOT BE INSTALLED UNLESS ALL OTHER DESIGN OPTIONS ARE UNABLE TO BE CONSTRUCTED DUE TO EXISTING SITE CONSTRAINTS.
2. CURB RAMPS MUST BE AS CLOSELY ALIGNED WITH THE SIDEWALK AND THE PEDESTRIAN STREET CROSSING SERVED AS POSSIBLE.
3. CURB RAMP MUST BE CONSTRUCTED WITH COMPANION RAMP ON OPPOSITE SIDE OF THE ROADWAY WHERE NO RAMP IS PROVIDED UNLESS OTHERWISE DIRECTED BY ENGINEER.
4. CURB RAMPS MUST HAVE A MAXIMUM RUNNING SLOPE OF 8.3% AND A MINIMUM WIDTH OF 4'-0" UNLESS OTHERWISE DIRECTED BY ENGINEER. THE CROSS SLOPE OF CURB RAMPS MUST BE A MAXIMUM OF 2%. CURB RAMPS ARE NOT REQUIRED TO EXCEED A LENGTH OF 15 FEET UNLESS OTHERWISE DIRECTED BY ENGINEER.*
5. GRADE BREAKS AT THE TOP AND THE BOTTOM OF CURB RAMP RUNS MUST BE PERPENDICULAR TO THE PATH OF TRAVEL. CURB RAMP RUNS ARE DEFINED BY RUNNING SLOPES THAT EXCEED 5% BUT ARE NO MORE THAN 8.3%. SURFACES ABUTTING AT CURB RAMP GRADE BREAKS MUST BE FLUSH.
6. AREAS ADJACENT TO CURB RAMPS OR CURB RAMP LANDINGS USABLE BY PEDESTRIANS MUST COMPLY WITH STANDARD PLAN SIDEWALK SLOPE LIMITS OR A CURB RAMP WING MUST BE PROVIDED AS SHOWN IN THE APPLICABLE CURB RAMP DETAILS. THE INSTALLATION OF CURBED EDGES MAY BE USED AT THE SIDES OR BACKS OF CURB RAMPS OR CURB RAMP LANDING WHERE THE ADJACENT SURFACE IS LANDSCAPED OR OTHERWISE NOT USABLE BY PEDESTRIANS.
7. THE COUNTER SLOPE OF THE GUTTER OR THE STREET AT THE BOTTOM OF CURB RAMP RUNS MUST BE 5% MAXIMUM. IF TURNING OR CHANGE OF ORIENTATION IS REQUIRED WITHIN THE PEDESTRIAN CROSSING AT THE BOTTOM OF CURB RAMP RUNS, THE SLOPE MUST BE 2% MAXIMUM IN ANY DIRECTION FOR A MINIMUM 4'-0" WIDTH X 4'-0" DEPTH MEASURED FROM THE RAMP BOTTOM GRADE BREAK.
8. CURB RAMPS WITH RUNS THAT TERMINATE AT THE ENTRANCE TO THE PEDESTRIAN STREET CROSSING MUST HAVE A CLEAR SPACE AT THE BOTTOM OF THE RAMP. "CLEAR SPACE" IS DEFINED AS A NAVIGABLE 4'-0" BY 4'-0" SPACE, EXTENDING FROM THE RAMP LOWER GRADE BREAK, THAT FALLS WHOLLY WITHIN THE LEGAL CROSSWALK, MARKED OR UNMARKED, AND OUTSIDE THE PARALLEL VEHICULAR TRAFFIC LANE.
9. A 4'-0" MINIMUM WIDTH UNOBSTRUCTED PEDESTRIAN ACCESS ROUTE MUST BE PROVIDED FROM EACH CURB RAMP, BLENDED TRANSITION, OF FLUSH TRANSITION TO THE LEGAL CROSSWALK THAT IS SERVED, MARKED OR UNMARKED, AND LOCATED OUTSIDE THE PARALLEL VEHICULAR TRAFFIC LANE.
10. DETECTABLE WARNING MUST BE PROVIDED AT CURB RAMPS AND AT LOCATIONS WHERE THE SIDEWALK AND ROADWAY ARE FLUSH. THE DETECTABLE WARNING SURFACE MUST HAVE A TRUNCATED DOME PATTERN AS SHOWN, WITH A MINIMUM DEPTH OF 2'-0", AND MUST BE PLACED AT THE BACK OF CURB BUT NO MORE THAN 8" FROM THE FACE OF CURB FOR MONOLITHIC CURBS OR ATYPICAL CURB WIDTHS. DETECTABLE WARNING MUST MATCH THE WIDTH OF THE RAMP RUN OR THE OPENING WHERE THE SIDEWALK AND ROADWAY ARE FLUSH. THE TRUNCATED DOMES ON THE

11. DETECTABLE WARNING SURFACE SHOULD ALIGN WITH THE CURB RAMP RUN OR THE DIRECTION OF TRAVEL. DOMES MAY BE ON A RADIAL GRID PATTERN WHERE RADIAL DETECTABLE WARNING SURFACE IS PLACED AT CURB RADII. OTHERWISE DIRECTED BY THE ENGINEER.

12. DETECTABLE WARNING SURFACES MUST NOT BE CUT OR ALTERED TO FIT UNLESS OTHERWISE DIRECTED BY THE ENGINEER. IT APPROVED, CUT OR ALTER THE DETECTABLE WARNING SURFACE PER THE MANUFACTURER'S DIRECTIONS. DETECTABLE WARNING SURFACES PLACED AT CURB RADII MUST MATCH THE CURB RADII WITHOUT GAPS OR INCONSISTENCIES IN PLACEMENT. HANDHOLES, UTILITY CASTINGS, OR ANY OTHER SURFACE OBSTRUCTIONS MUST NOT BE INSTALLED IN THE CURB RAMP RUN(S) OR LANDING(S) UNLESS OTHERWISE DIRECTED BY THE ENGINEER. IF NECESSARY DUE TO EXISTING CONSTRAINTS, HANDHOLES, UTILITY CASTINGS, OR OTHER SURFACE OBSTRUCTIONS MAY BE LOCATED WITHIN A RAMP RUN, LANDING, OR TURNING SPACE BUT MUST ADHERE TO SURFACE REQUIREMENTS. LEVEL CHANGES BETWEEN SURFACES MUST NOT EXCEED 1/4" OR 1/2" WITH A 1:2 BEVEL. GAPS BETWEEN SURFACES OR GRATINGS MAY NOT EXCEED 1/2". SURFACES MUST BE FIRM, STABLE, AND SLIP RESISTANT. HANDHOLES, UTILITY CASTINGS, OR OTHER SURFACE OBSTRUCTIONS MUST NOT REDUCE THE REQUIRED DEPTH OF DETECTABLE WARNING.




13. POLES, HYDRANTS AND OTHER ABOVE GROUND OBSTRUCTIONS MUST HAVE A MINIMUM LATERAL CLEARANCE OF 1'-0" FROM RAMP RUN(S) OR LANDING(S). EXCEPT FOR PUSHBUTTON POSTS.

14. ALL CHANGES IN LEVEL ACROSS JOINTS MUST BE FLUSH. ANY DIFFERENCE IN ELEVATION OF 3/16 INCH OR GREATER MUST BE REPAIRED OR REPLACED.


15. CURB RAMPS ARE DESIGNED TO ENSURE THAT WATER DOES NOT ACCUMULATE ON RAMP SURFACES AND IN FRONT OF THE CURB RAMP WHERE IT IS FLUSH WITH THE ROADWAY. THE CONTRACTOR MUST CHECK GRADE LINES AND GUTTER FLOW LINE PRIOR TO CONSTRUCTION. IF THE CHECK REVEALS THAT SITE CONDITIONS WOULD RESULT IN PONDING, OR WOULD CONFLICT WITH OBTAINING THE GRADES AT THE BOTTOM OF CURB RAMPS OR AT CURB RAMP LOWER LANDINGS AS SHOWN ON THE DRAWINGS OR PLANS, THE CONTRACTOR MUST NOTIFY THE ENGINEER IMMEDIATELY AND STOP WORK ON THE CURB RAMP UNTIL DIRECTED TO CONTINUE BY THE ENGINEER.

** IT IS RECOMMENDED THAT CURB RAMPS RUNNING SLOPES BE DESIGNED TO 7.5% MAX. AND CURB RAMP LANDINGS BE DESIGNED TO 1.5% MAX TO ALLOW FOR A LIMITED MARGIN OF ERROR DURING CONSTRUCTION.

notes 4, 6, 10, 12, 13, 15 & 17 revised

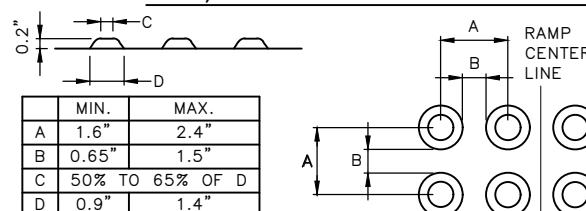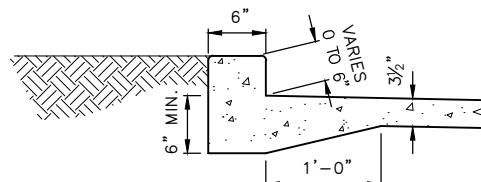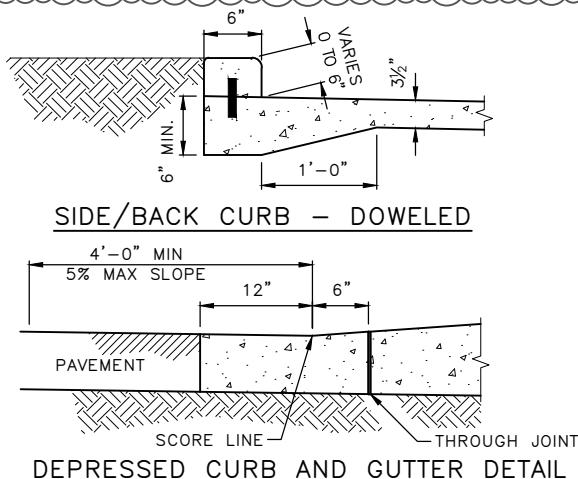

REV DATE: OCT 2022

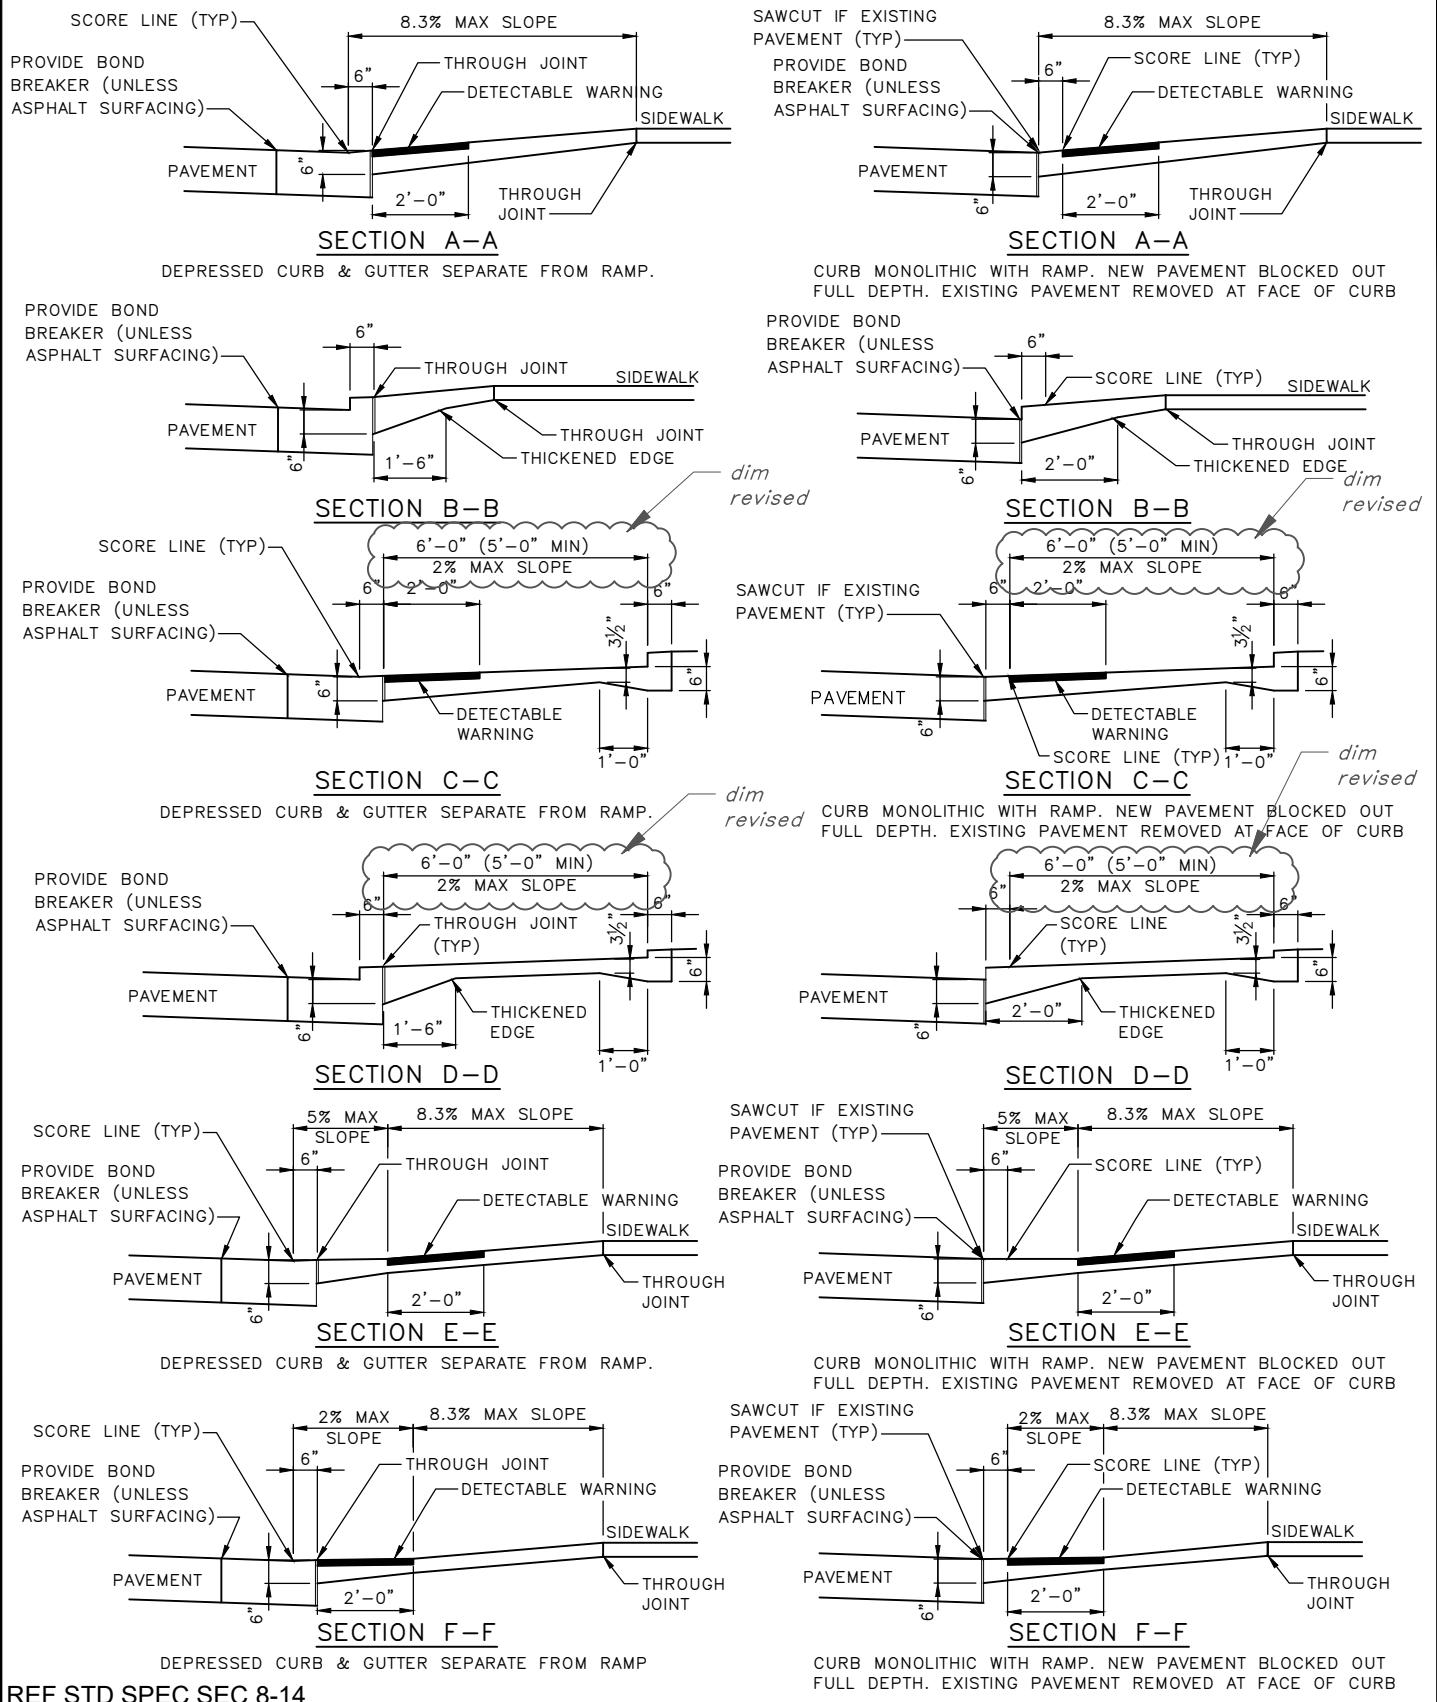

REF STD SPEC SEC 8-14





City of Seattle

NOT TO SCALE

CURB RAMP SECTIONS

REV DATE: AUG 2022

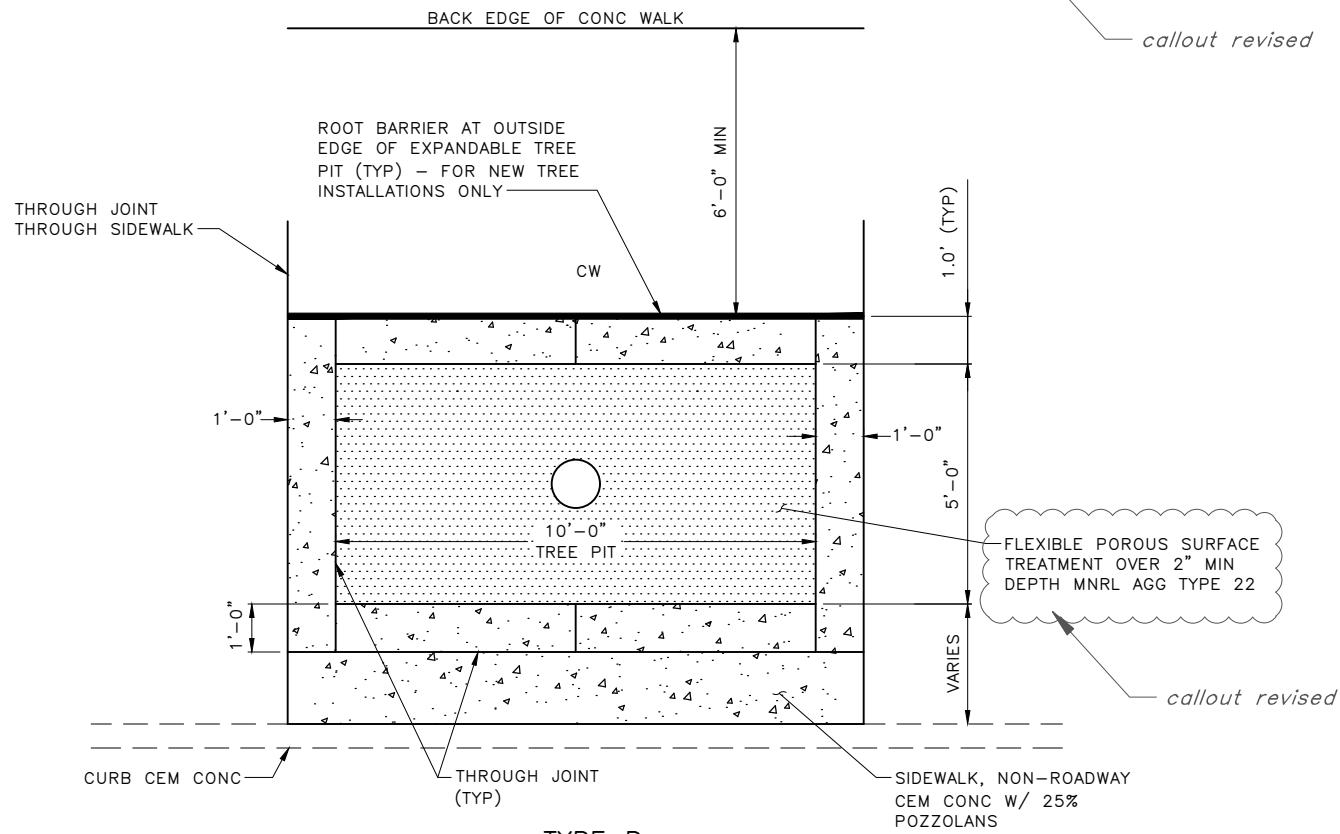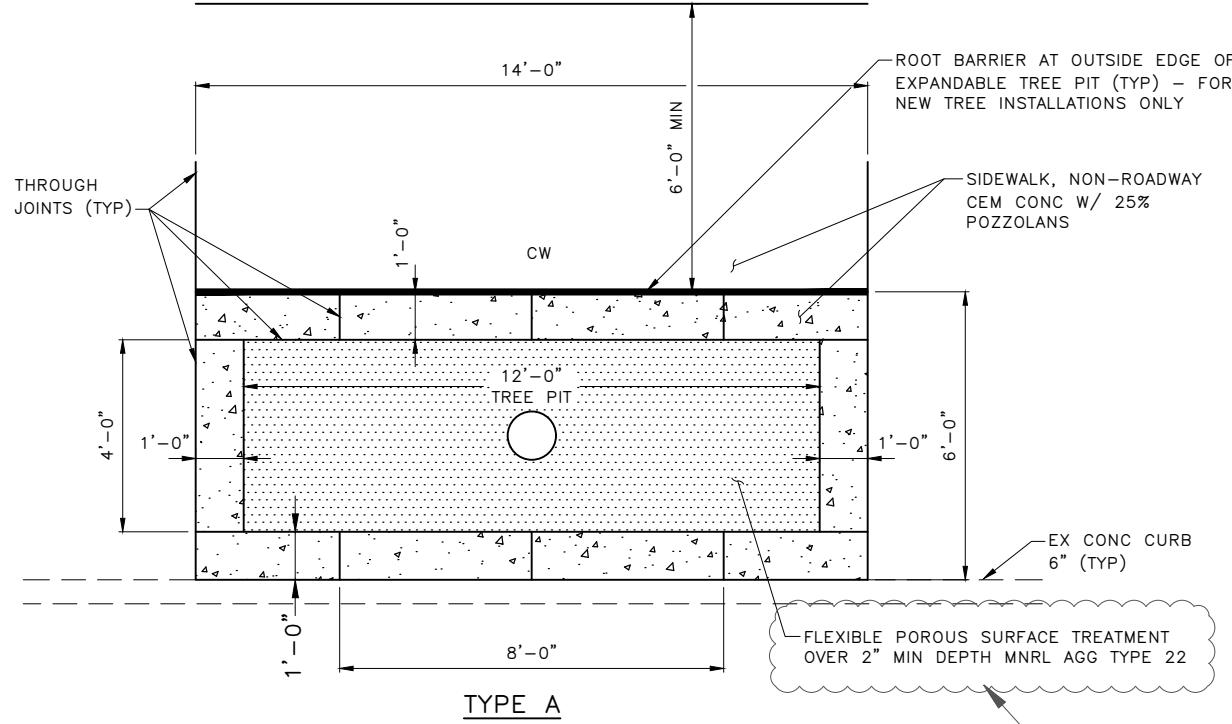

NOTES:

1. SEE STD PLAN 420 FOR CW SCORING DETAILS.
2. INSTALL ROOT BARRIER PER STANDARD PLAN NO 100a.
3. WHEN INSTALLING NEW TREE PITS IN EXISTING SIDEWALK, REMOVE SIDEWALK TO FULL PANEL WIDTH. INSTALL TREE PIT AS SHOWN ON THIS DETAIL.


REF STD SPEC SEC 8-02, 8-14




City of Seattle

NOT TO SCALE

EXPANDABLE TREE PIT DETAIL

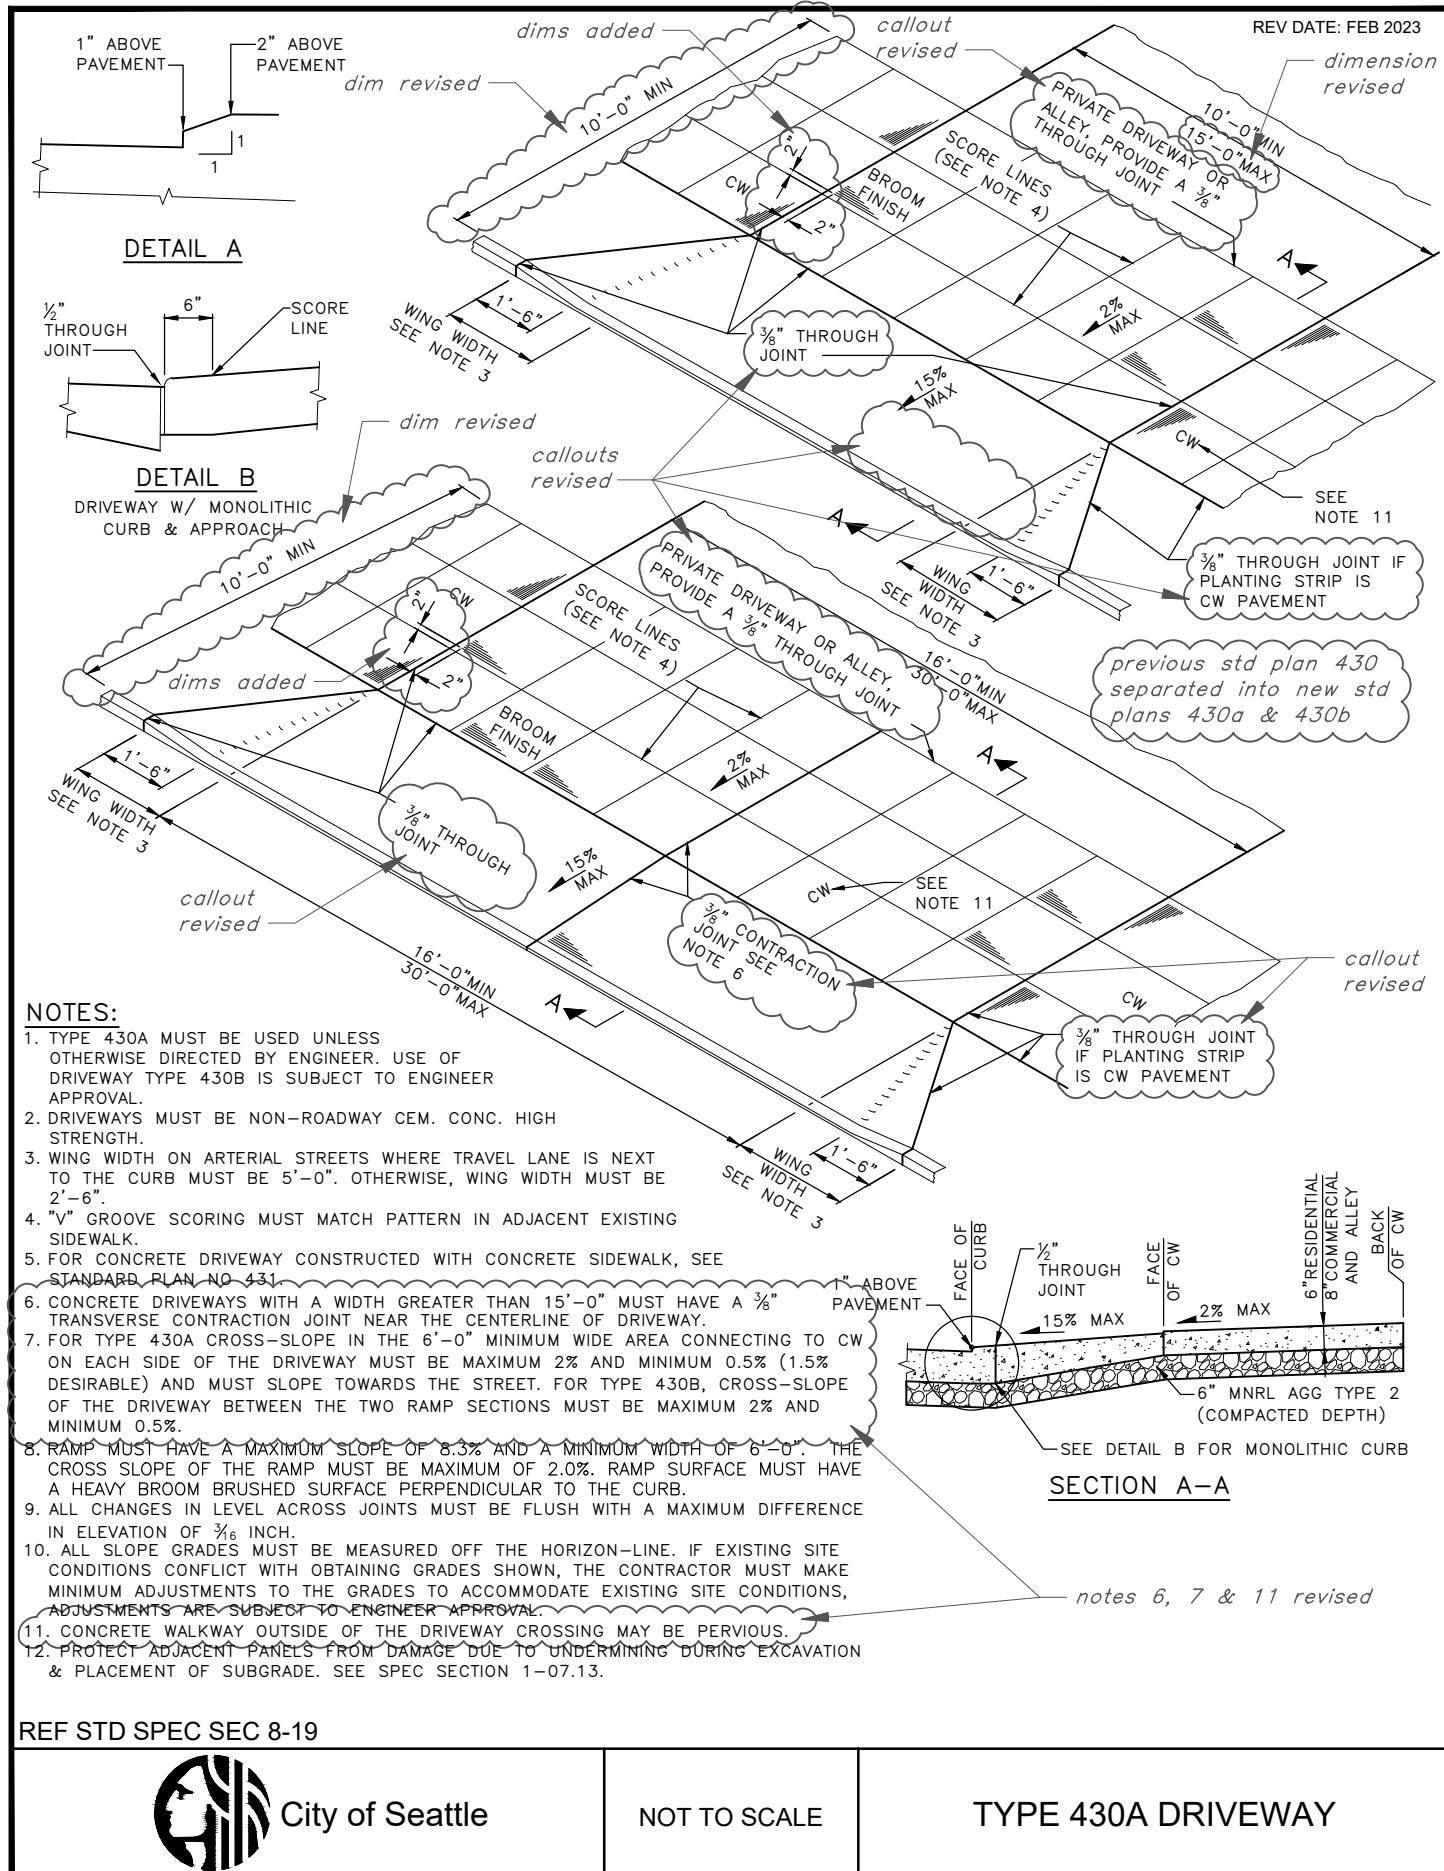


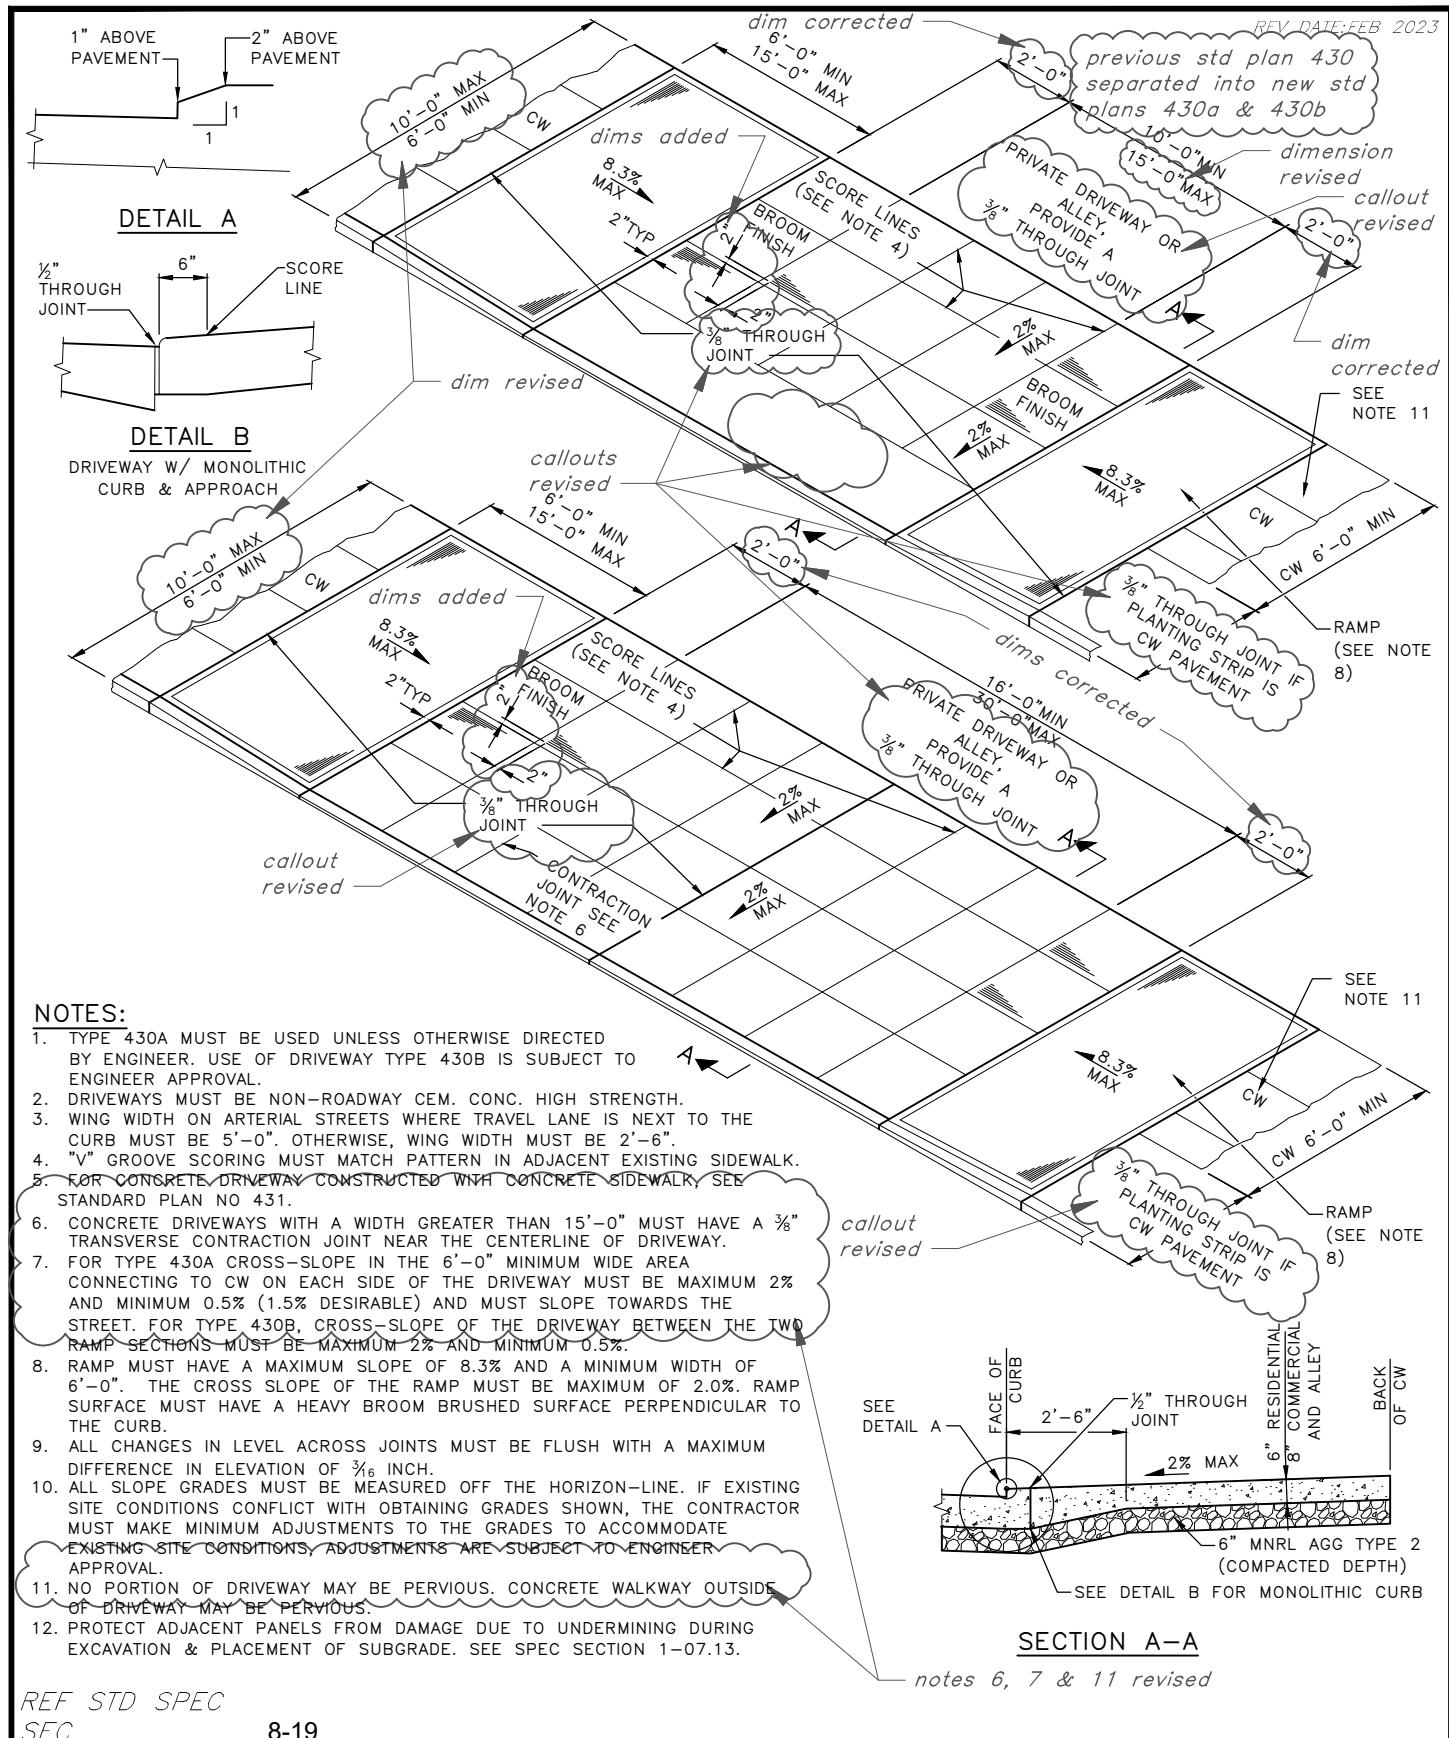

City of Seattle

NOT TO SCALE

TYPE 430b DRIVEWAY

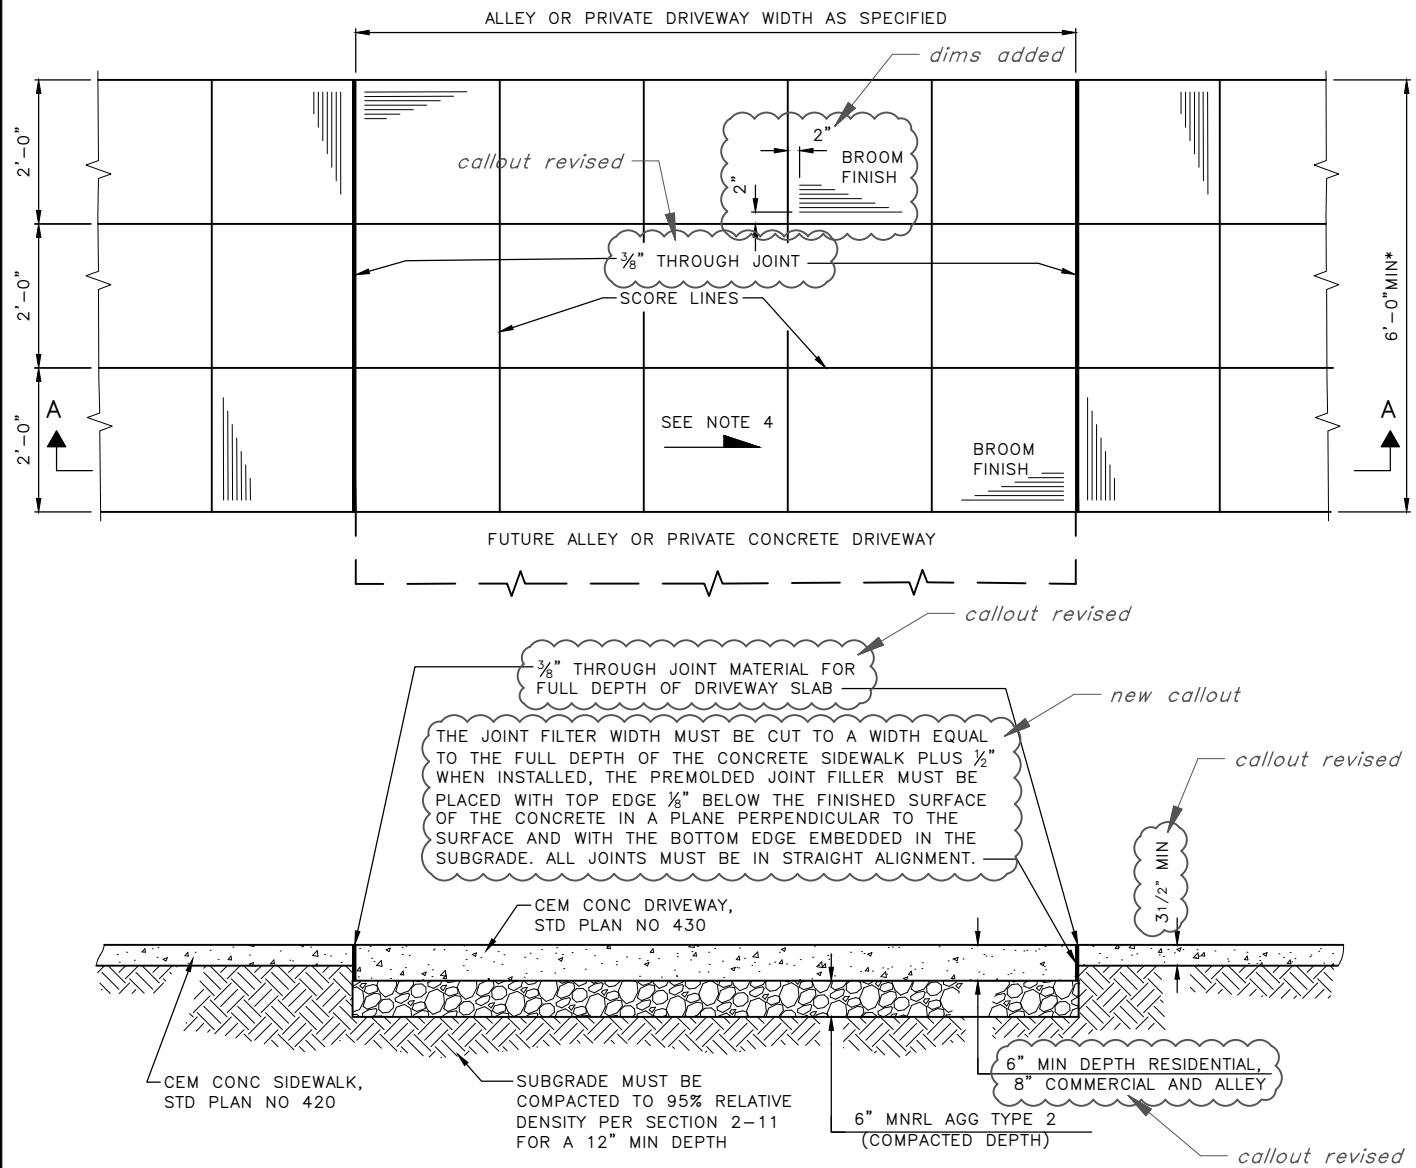

* UNLESS OTHERWISE APPROVED

NOTES:

1. DRIVEWAY WIDTH GREATER THAN 15'-0" MUST HAVE $\frac{3}{8}$ " TRANSVERSE CONTRACTION JOINT AT OR NEAR ITS CENTER.
2. DRIVEWAY GREATER THAN 30'-0" REQUIRES APPROVAL. SET $\frac{3}{8}$ " TRANSVERSE CONTRACTION JOINTS AT INTERVALS OF 8' TO 15', UNLESS OTHERWISE SPECIFIED.
3. PROVIDE SCORE LINES PER STD PLAN NO 420 AND THE DRAWINGS.
4. THE SURFACE MUST BE BRUSHED IN THE TRANSVERSE DIRECTION IN RELATION TO THE CENTERLINE OF THE DRIVEWAY OR ALLEY WITH A FIBER HAIR BRUSH OR OTHER APPROVED BRUSH TYPE.
5. PROTECT ADJACENT PANELS FROM DAMAGE DUE TO UNDERMINING DURING EXCAVATION & PLACEMENT OF SUBGRADE. SEE SPEC SECTION 1-07.13.

REF STD SPEC SEC 8-19




City of Seattle





NOT TO SCALE

CEMENT CONCRETE DRIVEWAY
PLACED WITH CEMENT
CONCRETE SIDEWALK


REV DATE: OCT 2022

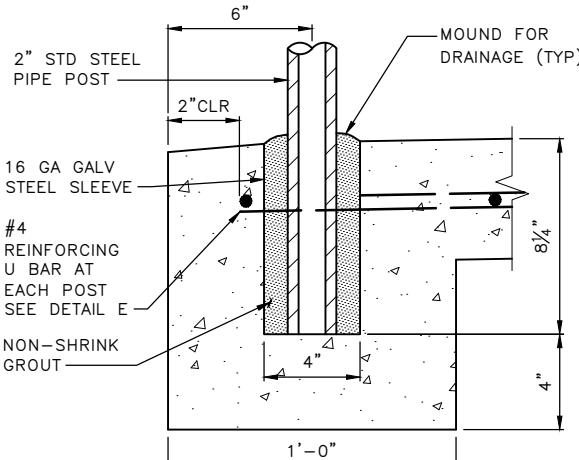

DETAIL A

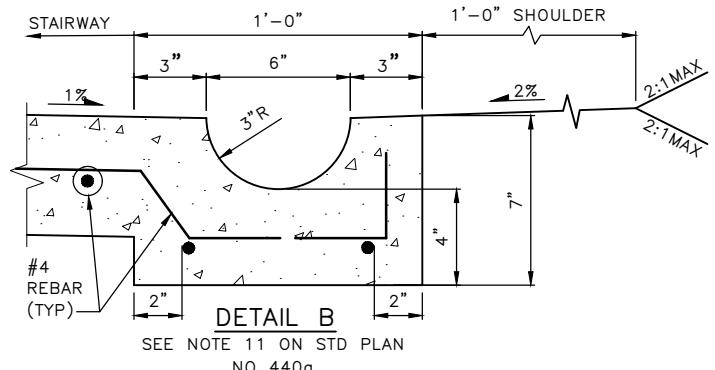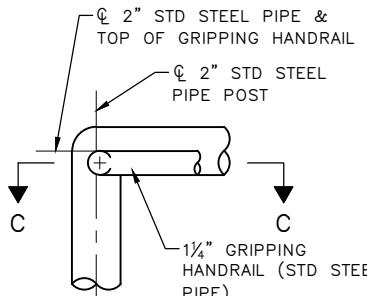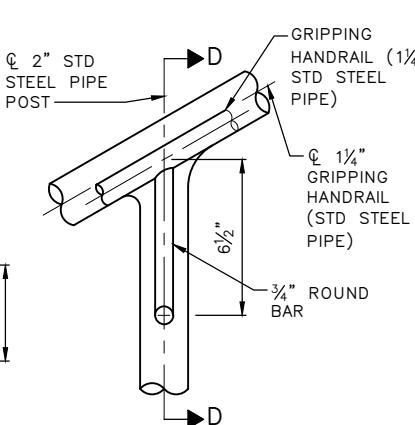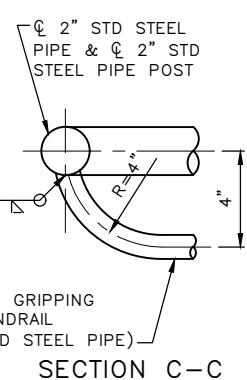DETAIL B
SEE NOTE 11 ON STD PLAN
NO 440aDETAIL C
HAND GRIP TERMINATION


DETAIL D

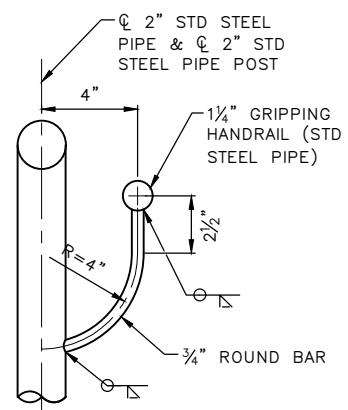


SECTION D-D

NOTE:


PIPE DIAMETERS SHOWN CORRESPOND TO PIPE "SHAPE" AS DEFINED IN AMERICAN INSTITUTE OF STEEL CONSTRUCTION MANUAL.

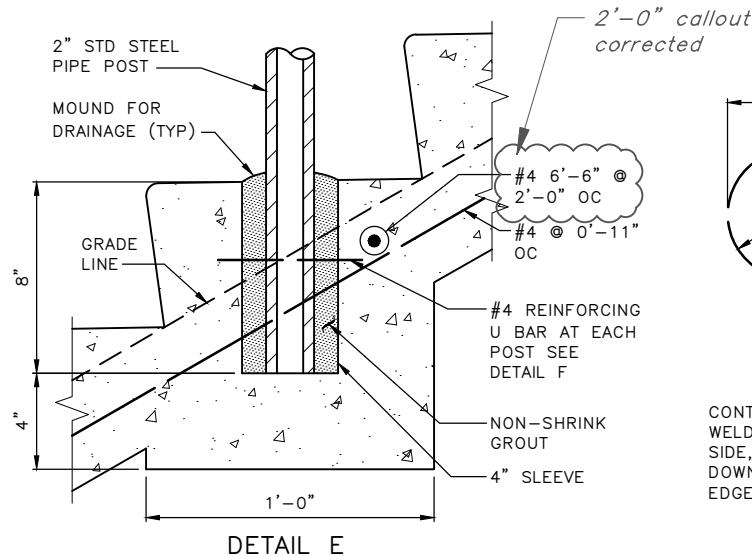

DETAIL E

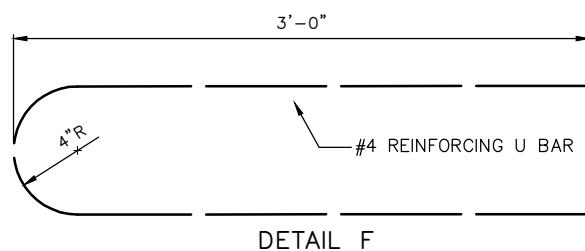

DETAIL F

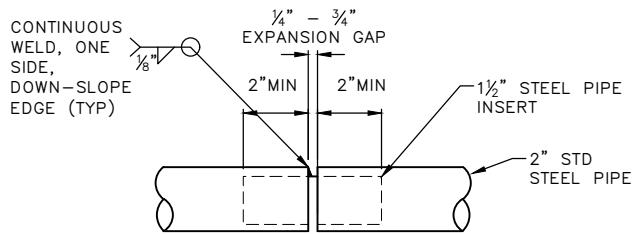DETAIL G
SLIP JOINT


REF STD SPEC SEC 8-18




City of Seattle

NOT TO SCALE

CEMENT CONCRETE
STAIRWAY & HANDRAIL

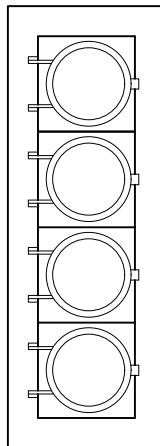





12" HEAD

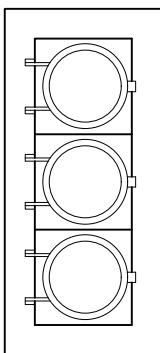



12" HEAD

TYPICAL SIGNAL FACES

W/ TUNNEL VISORS & 5" BACKPLATE (LOUVERED)
1" YELLOW, DIAMOND GRADE RETRO REFLECTIVE
TAPE

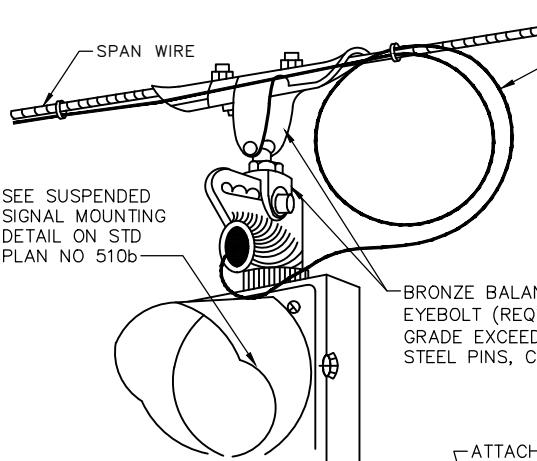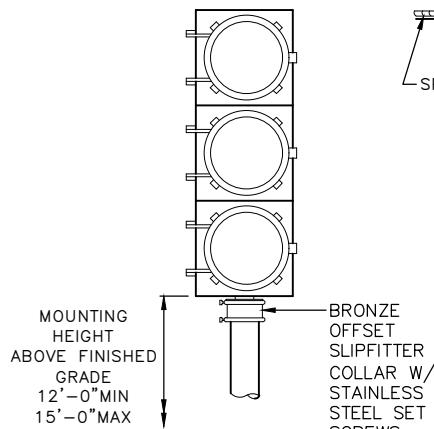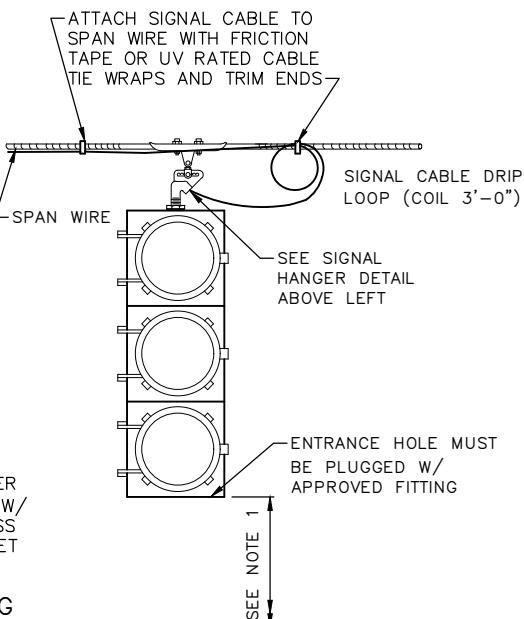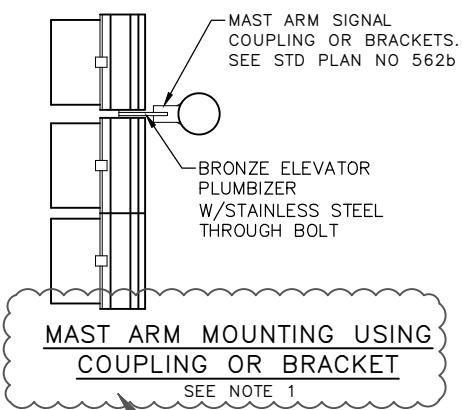
SIGNAL HANGER DETAILPEDESTAL TOP MOUNTING
FOR PEDESTAL SEE STD PLAN NO 524SPAN MOUNTINGMAST ARM MOUNTING USING
COUPLING OR BRACKET

SEE NOTE 1

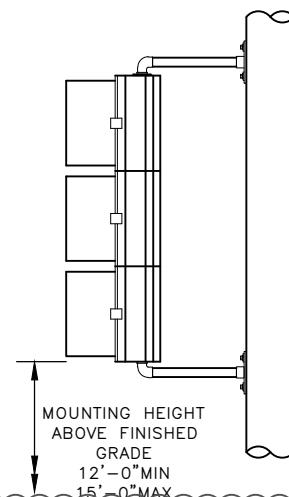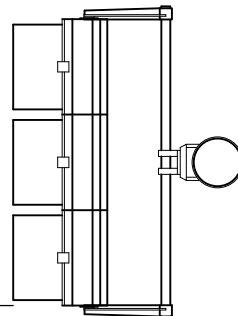BRACKET MOUNTING
FOR POLE MOUNTED
FOR SIGNAL HEAD BRACKET ASSEMBLY
SEE STD PLAN NO 511BRACKET MOUNTING
FOR MAST ARM MOUNTED
FOR SIGNAL HEAD BRACKET ASSEMBLY
SEE STD PLAN NO 562b**NOTES:**

1. VERTICAL CLEARANCE: 17' MIN TO ROADWAY 19'-0" MAX (ON TRUCK ROUTES USE 18' TO 19')
2. BACKPLATES HAVE BEEN OMITTED FROM VARIOUS VIEWS FOR CLARITY





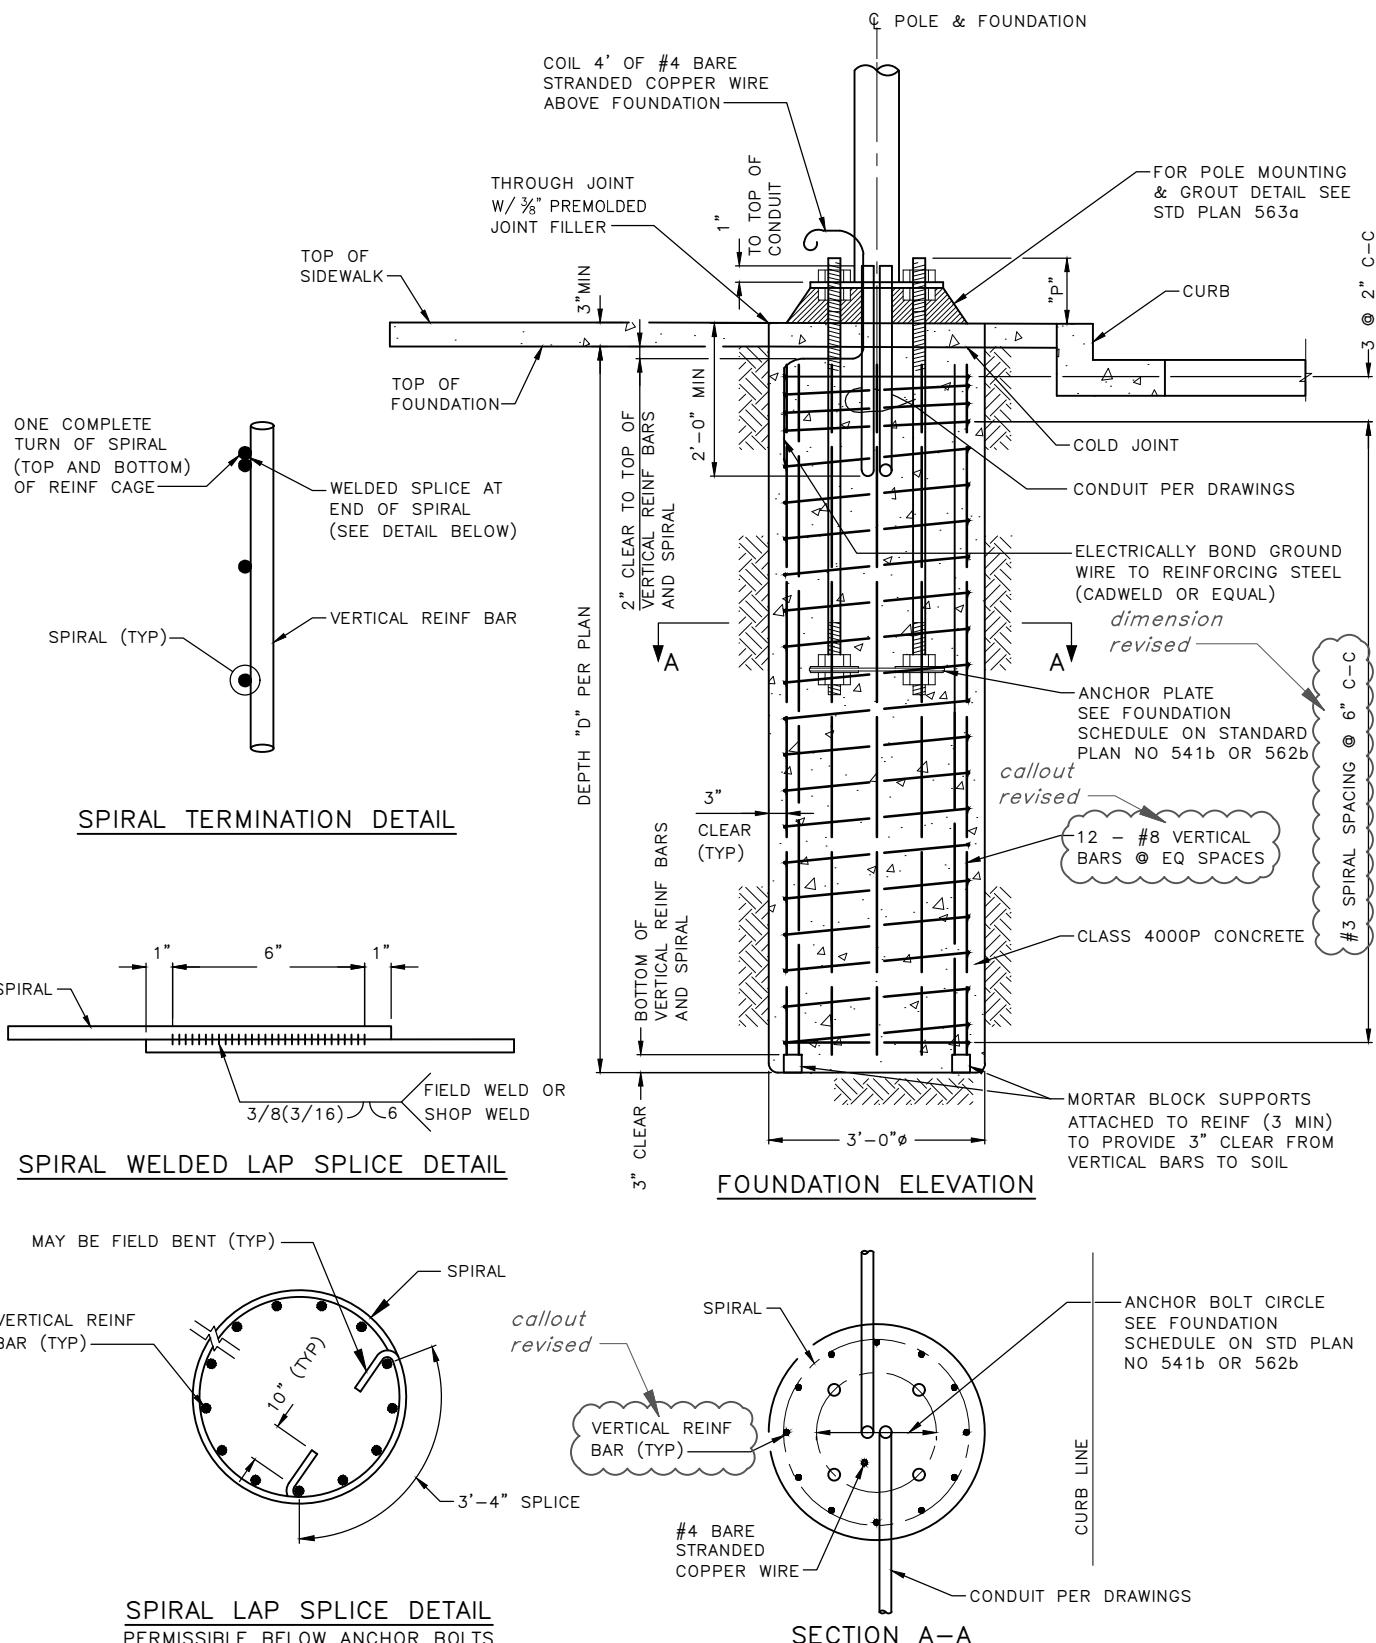

City of Seattle

NOT TO SCALE

TRAFFIC SIGNAL POLE FOUNDATION DETAIL

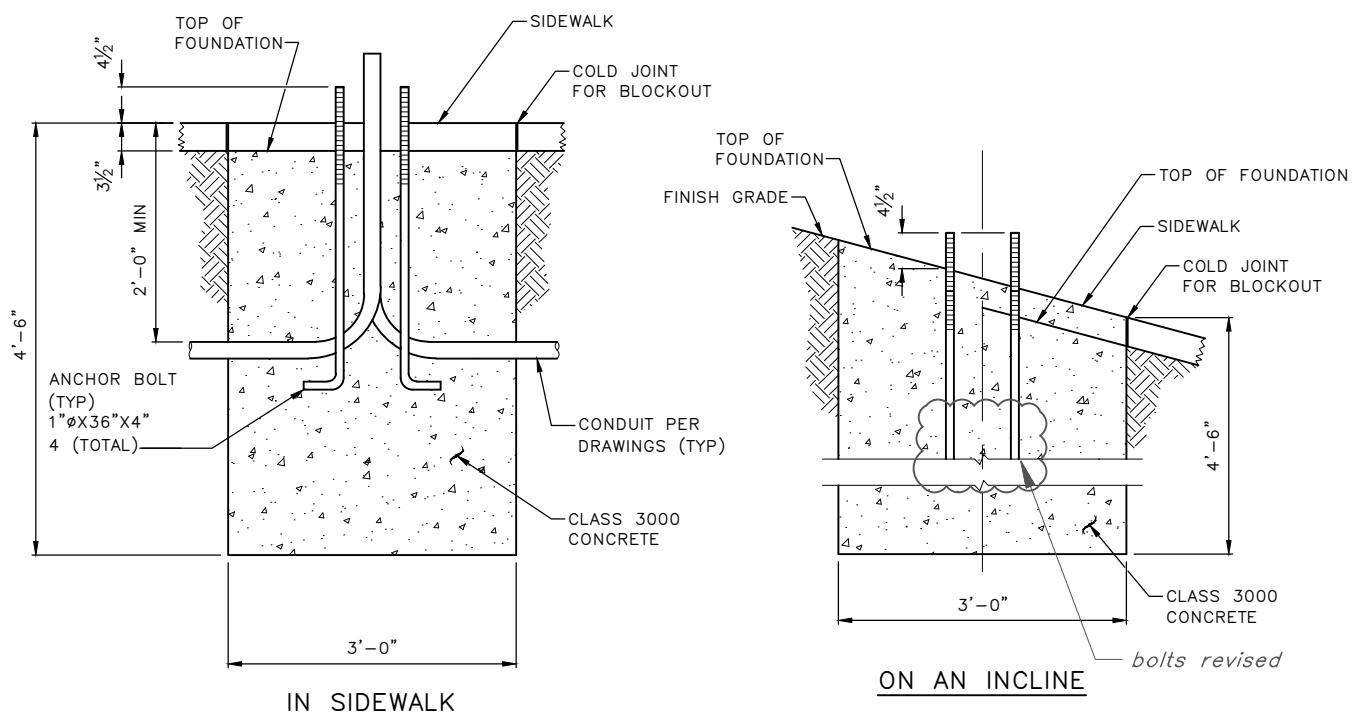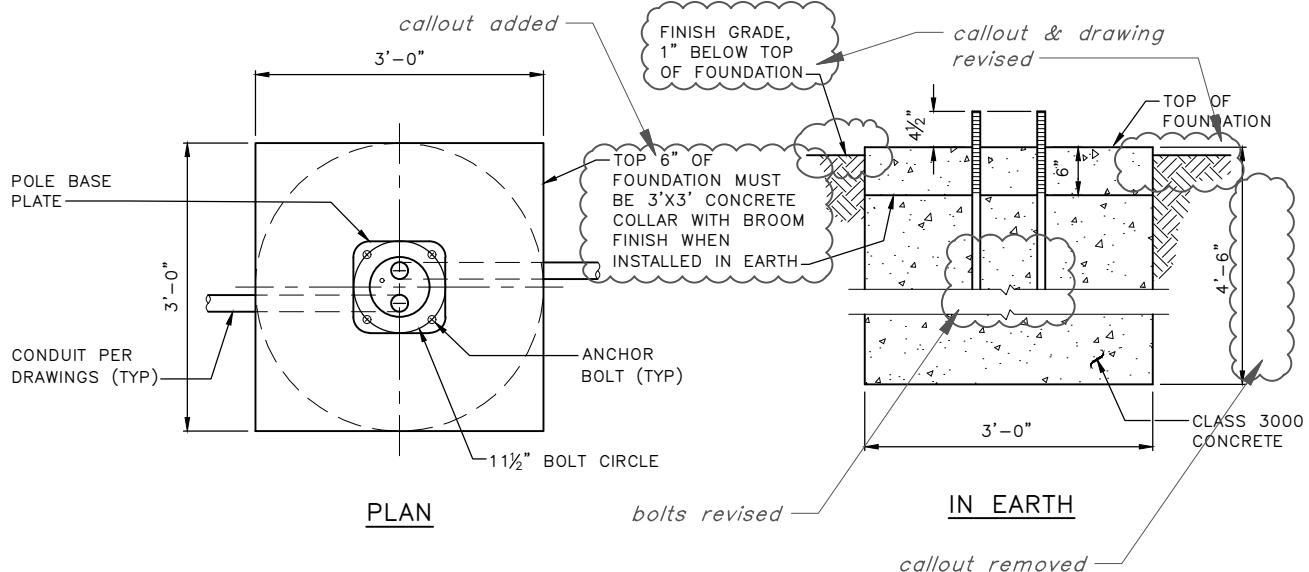



NOTES:

1. SEE SCL CONSTRUCTION STANDARD 1716.34 FOR POLE MOUNTING AND GROUT DETAIL
2. ANCHOR BOLTS MUST BE HOT DIP GALVANIZED ASTM A153 OR F2329, FULL LENGTH AND FABRICATED FROM ASTM F1554 OR A576 WITH 12" THREADS ON TOP
3. ALL SHRUBBERY AND FOLIAGE MUST BE PLANTED A MINIMUM OF 2' FROM SCL STRUCTURE PER SCL CONSTRUCTION STANDARD 0214.00

former note 1 removed

note added



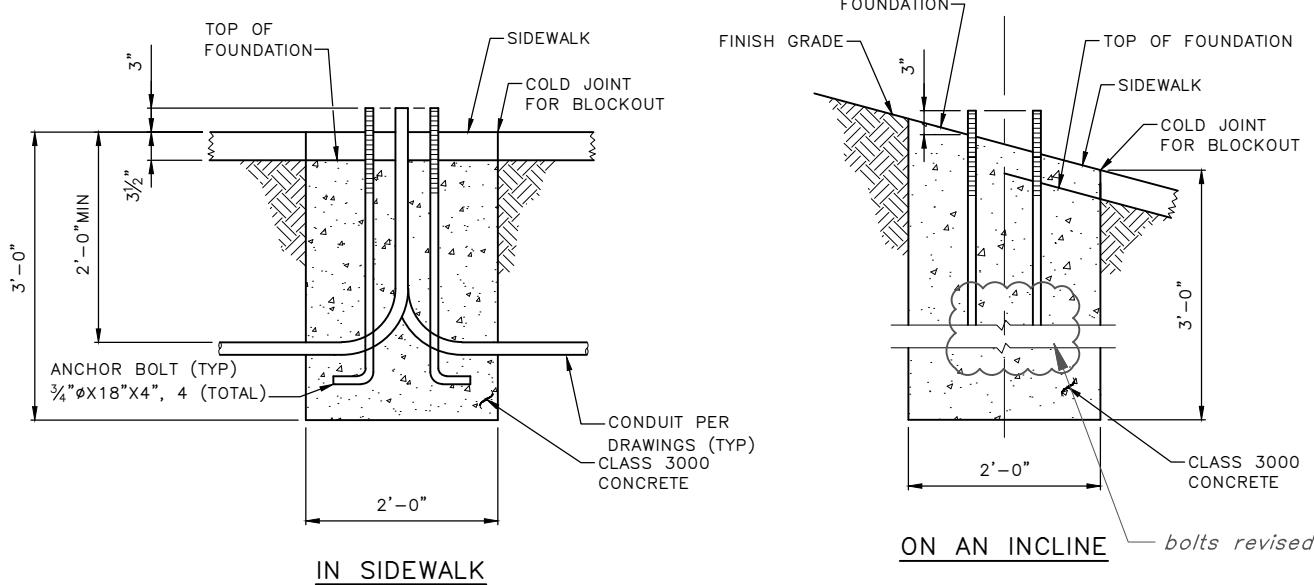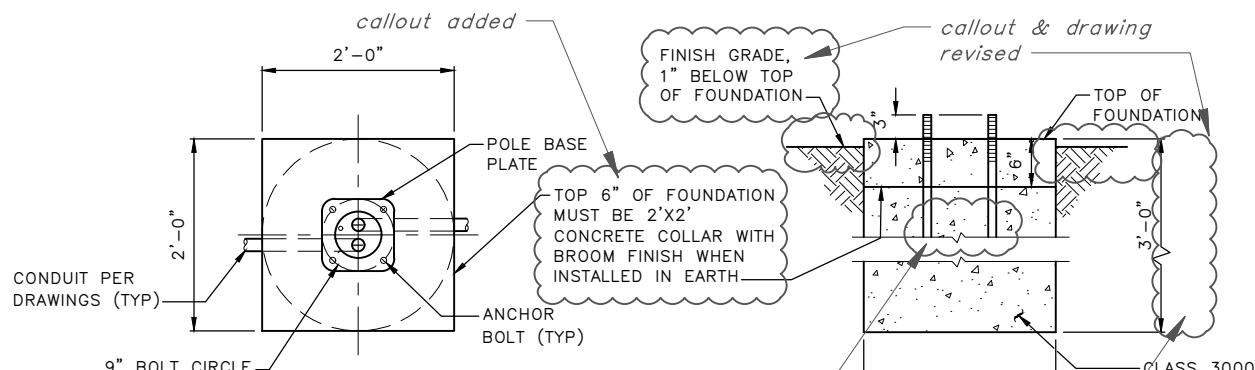

NOTES:

1. SEE SCL CONSTRUCTION STANDARD 1716.34 FOR POLE MOUNTING AND GROUT DETAIL
2. ANCHOR BOLTS MUST BE HOT-DIP GALVANIZED TO ASTM A153 OR F2329, FULL LENGTH AND FABRICATED FROM ASTM F1554 OR A576 WITH 8" OF THREADS ON TOP
3. SEE SCL MATERIAL STANDARD 5756.09 FOR POLES
4. SEE SCL CONSTRUCTION STANDARD 1716.07 FOR STREETLIGHT HANDBEAD AND CONDUIT REQUIREMENTS
5. ALL SHRUBBERY AND FOLIAGE MUST BE PLANTED A MINIMUM OF 2' FROM SCL STRUCTURE PER SCL CONSTRUCTION STANDARD 0214.00

former note 1 removed


note added




NOTES:

type 1 dimensions corrected

1. THE COVER MUST HAVE $\frac{1}{16}$ " TO $\frac{1}{8}$ " CLEARANCE ON EACH EDGE WITHIN THE FRAME AFTER GALVANIZING.
2. THE GROUND ROD MUST EXTEND 4" ABOVE THE BOTTOM OF THE HANDHOLE OR MINERAL AGGREGATE.
3. TYPE 1, 2, 3, 5 & 6 HANDHOLE COVERS MUST HAVE "SDOT" OR "SL" ON THEM, AS APPROPRIATE.
4. TYPE 4 HANDHOLE MUST BE INSTALLED IN ROADWAYS, PARKING LOTS, ETC.
5. FOR PAVEMENT DEPTH GREATER THAN 7" USE FRAME EXTENSIONS (SEE STD PLAN NO 231) TO BRING THE COVER UP THE THE LEVEL OF THE FINISHED PAVEMENT WITHOUT EMBEDDING THE BOTTOM FLANGE OF THE CASTING IN THE PAVEMENT.
6. A 4' LENGTH OF #6 THWN OR THHN COPPER WIRE MUST BE SECURED FROM THE HANDHOLE COVER TO THE FRAME, BOND FROM FRAME LID, AND LID TO GROUND ROD.
7. ALL HANDHOLE COVERS AND FRAMES MUST HAVE A NON-SKID SURFACE (SEE STD SPEC SEC 9-34.6)
8. ALL HANDHOLES MUST HAVE A LOAD RATING OF H20.
9. GROUND ROD REQUIRED IN ALL STREETLIGHT HANDHOLES PER SCL CONSTR STD 1714.50
10. SEE SCL CONSTRUCTION STANDARD 1716.07 & SCL MATERIAL STD 7203.10 FOR STREETLIGHT HANDHOLE AND CONDUIT REQUIREMENTS
11. ALL SHRUBBERY AND FOLIAGE MUST BE PLANTED A MINIMUM OF 2' FROM SCL STRUCTURE PER SCL CONSTRUCTION STANDARD 0214.00

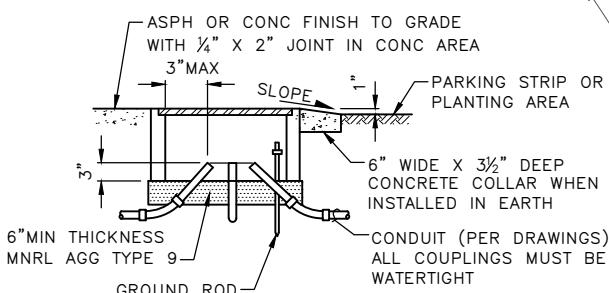

HANDHOLE INSTALLATION DETAIL

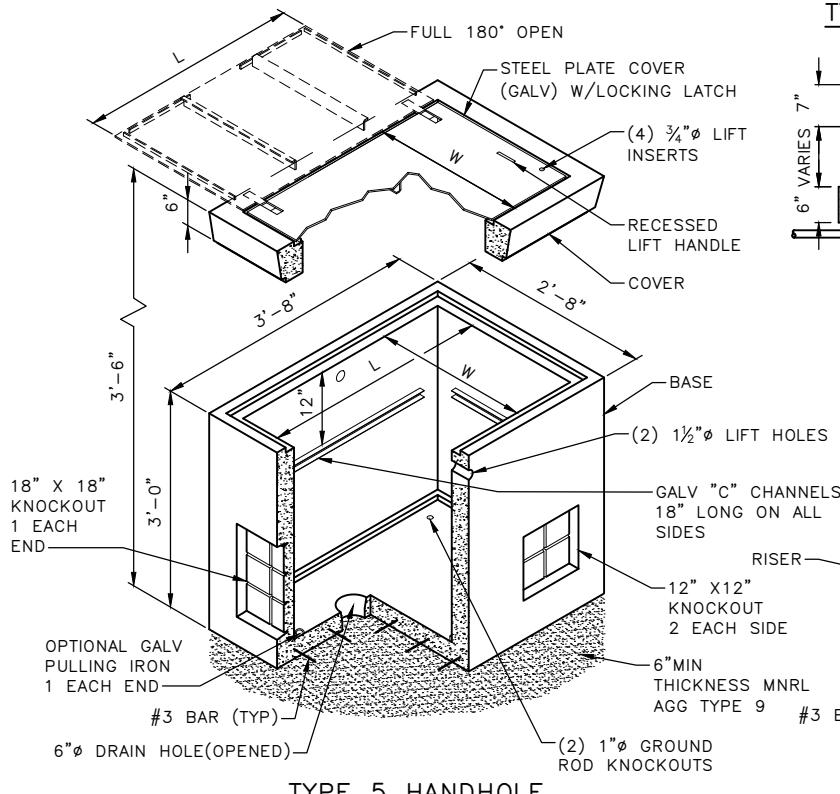

TYPE 5 HANDHOLE

REF STD SPEC SEC 8-33




City of Seattle


NOT TO SCALE

HANDHOLE SCHEDULE

HANDHOLE TYPE	TOP UNIT INSIDE DIMENSION			EXTENSION UNIT(E)	COVER DIMENSIONS	
	L	W	H		L	W
1	22"	17"	12"	12"	17 3/4"	12 3/4"
2	33"	22"	12"	12"	27 3/4"	16 3/4"
3	36"	24"	12"	12"	35"	24"
4	24"φ	VAR		NA	NA	NA
5	36"	24"	32"	NA	35"	24"
6	42"	42"	38 1/2"	NA	33 1/2"	33 3/4"
GRHH	8"φ			NA		

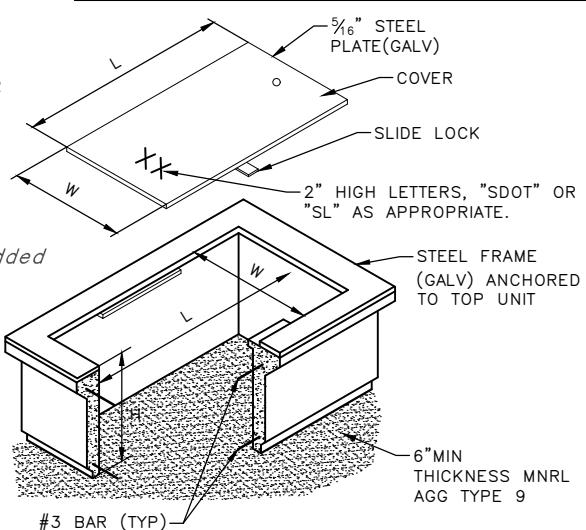


TYPE 1 & 2 HANDHOLE

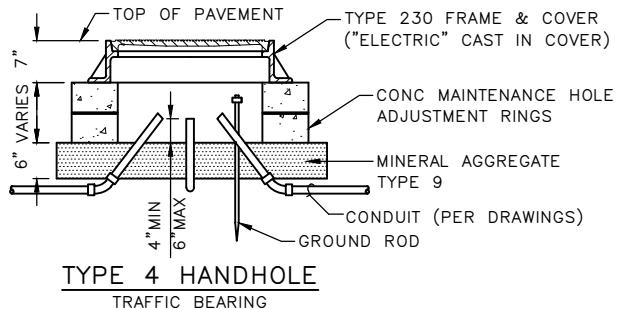

TYPE 4 HANDHOLE

TRAFFIC BEARING

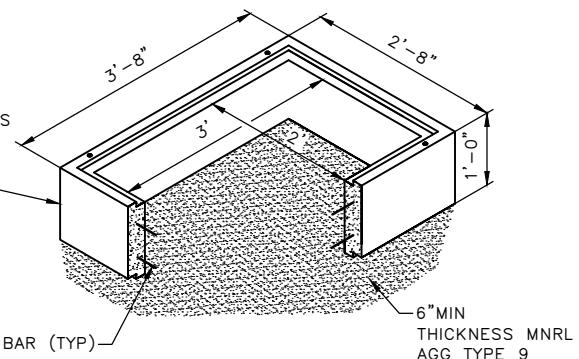TYPE 3 HANDHOLE
(COVER SAME AS TYPE 5)

HANDHOLES

POLE BASE PLATE

SIGNAL COUPLING
COUPLING TO BE FABRICATED & INSTALLED BEFORE GALVANIZING

ANCHOR PLATE
PER FOUNDATION SCHEDULE

INCLINED CONDITION

POLE FOUNDATION NOTES

1. CONCRETE MUST BE CLASS 4000P.
2. ANCHOR BOLTS MUST BE ASTM F1554 GRADE 105 CLASS 2A THREADS INCLUDING SUPPLEMENTARY REQUIREMENTS S2 THROUGH S4. NUTS: ASTM A563 HEAVY HEX GRADE DH. HARDENED STEEL WASHERS: ASTM F436.
3. BOTTOM ANCHOR PLATE: ASTM A36, HOT DIP GALVANIZED PER ASTM A123.
4. ALL REINFORCING BARS MUST BE DEFORMED BILLET STEEL CONFORMING TO ASTM CLASS A706, GRADE 60.
5. ANCHOR BOLTS MUST BE HOT DIP GALVANIZED PER ASTM F2329 INCLUDING NUTS & WASHERS (FULL LENGTH) WITH A MINIMUM OF 18" OF THREADS ON TOP & 12" ON BOTTOM.
6. TAPE THE TOP OF ANCHOR BOLTS WITH CORROSION PROTECTION TAPE PER STD SPEC SEC 8-32.3(2)A PRIOR TO POURING CONCRETE.
7. SEE STD PLAN NO 541a FOR FOUNDATION DETAILS.
8. FOUNDATION DEPTH, REINFORCEMENT AND ANCHOR BOLTS MUST BE IN CONFORMANCE WITH "AASHTO STANDARD SPECIFICATIONS FOR STRUCTURAL SUPPORTS FOR HIGHWAY SIGNS, LUMINAIRES AND TRAFFIC SIGNALS" (6TH EDITION, 2013). DESIGN BASIC WIND SPEED IS 85 MPH AND RECURRENCE INTERVAL/DESIGN LIFE IS 50 YEARS

FOUNDATION SCHEDULE

MAST ARM LENGTH	ANCHOR BOLTS			ANCHOR PLATE DIMENSIONS			
	PROJECTION "P"	BOLT CIRCLE DIA	SIZE	SIZE	BOLT HOLE	CENTER HOLE	CORNER RADIUS
15'-0" TO 30'-0"	7 1/2"	14 1/2"	1 1/2" X 60"	3/8" X 16" X 16"	1 1/8"	10"	1 1/8"
31'-0" TO 40'-0"	9"	16 1/2"	1 3/4" X 72"	3/8" X 16" X 16"	1 1/8"	12 1/2"	1 1/8"
41'-0" TO 45'-0"	9"	18"	1 3/4" X 72"	3/8" X 16" X 16"	1 1/8"	12 1/2"	1 1/8"
46'-0" TO 60'-0"	10"	20"	2" X 72"	3/8" X 18" X 18"	2 1/8"	14"	2"

FOUNDATION DEPTH MUST BE PER PLANS.


REF STD SPEC SEC 8-31, 8-32

 City of Seattle

NOT TO SCALE

STEEL MAST ARM POLE FOUNDATION SCHEDULE & DETAIL W/O METRO TROLLEY LOADS)

ALIGN TAILS OF APPROACH LANE ARROWS. NOTE: THE 10' OFFSET FROM THE END OF THE LANE OR THE STOP BAR SHOULD BE ESTABLISHED BY THE SHORTEST ARROW ON THE APPROACH AND LONGER ARROWS MAY ENCROACH UPON THE 10' OFFSET FROM THE END OF THE LANE TO OBTAIN ALIGNMENT WITH THE TAIL END OF SHORTER ARROWS WHEN PRESENT.

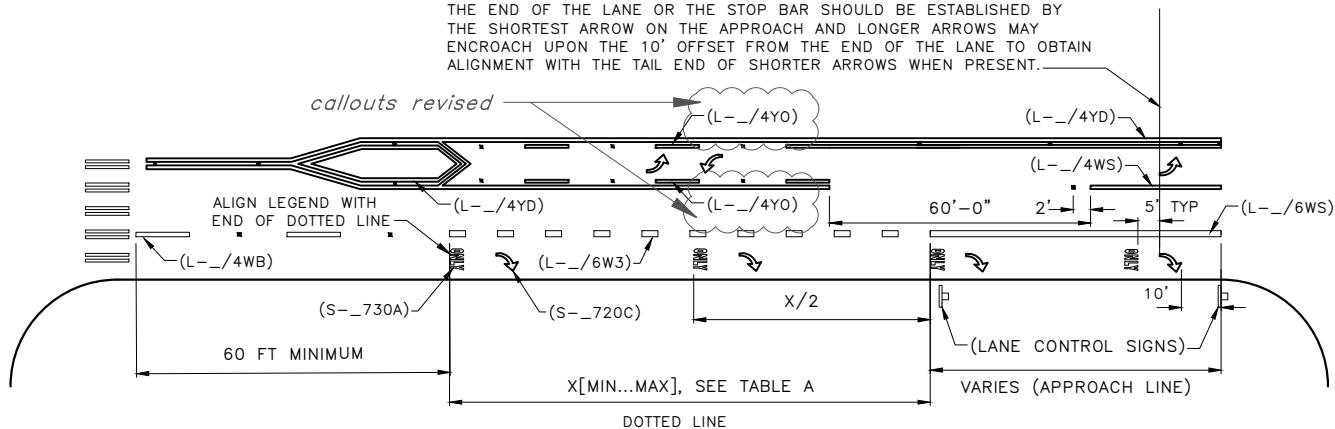

NOTE:

NOTE: LEGENDS, SYMBOLS & ARROWS MUST BE CENTERED WITHIN THE LANE TO WHICH THEY APPLY, AS SHOWN.

TABLE A

POSTED OR 85TH-PERCENTILE SPEED	X	
	MAX	MIN
MUTCD TABLE 2C-4 CONDITION A	MERGING TAPER	
20 MPH	225 FT	75 FT
25 MPH	325 FT	115 FT
30 MPH	460 FT	165 FT
35 MPH	565 FT	225 FT
40 MPH	670 FT	295 FT
45 MPH	775 FT	375 FT

TYPICAL LEGEND AND SYMBOL INSTALLATION DETAILS

LINE LENGTH	LEGEND SETS	
	WITHIN APPROACH LINE	WITHIN DOTTED LINE
LESS THAN 50 FEET	APPROACH LINE (1 TOTAL)	NA
50 FEET TO 120 FEET	ADD 1 SET AT BEGINNING OF APPROACH LINE (2 TOTAL)	ADD 1 SET MIDWAY BETWEEN FIRST SET AND APPROACH LINE (2 TOTAL)
125 FEET TO 300 FEET	ADD 1 SET LOCATED MIDWAY BETWEEN FIRST AND LAST SETS (3 TOTAL)	ADD 1 SET, WITH EQUAL INTERVALS, BETWEEN FIRST SET AND APPROACH LINE (3 TOTAL)
OVER 300 FEET	ADD SETS SPACED AT APPROX. 100 FEET INTERVALS BETWEEN FIRST AND LAST SETS	

NOTE:

NOTE:
1. SEE MUTCD SECTION 2B.20 FOR GUIDANCE ON SIGNS.
2. MANDATORY MOVEMENT LANE CONTROL SIGNS MUST BE PAIRED WITH LEGENDS PLACED WITHIN THE APPROACH LINE



REF STD SPEC SEC 8-22



City of Seattle

NOT TO SCALE

TYPICAL LANE DROP CHANNELIZATION AND LEGEND PLACEMENT

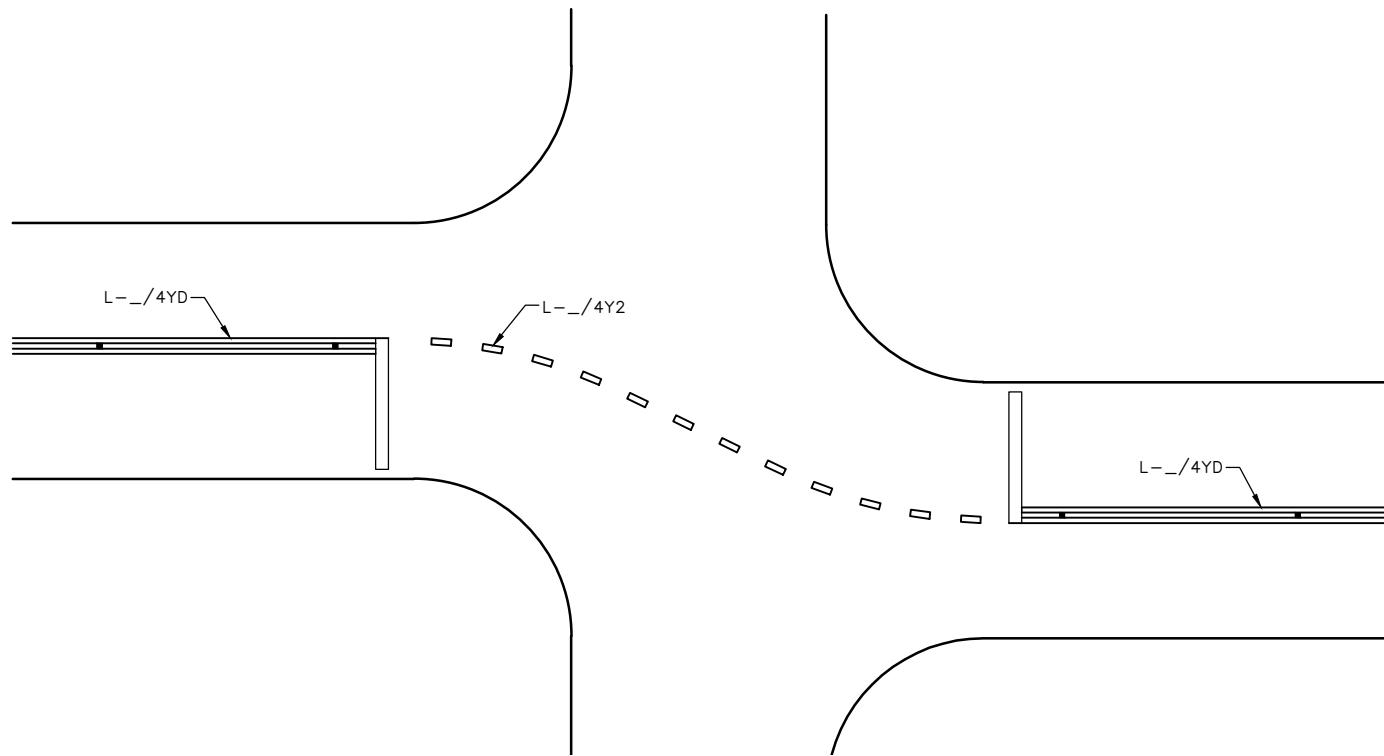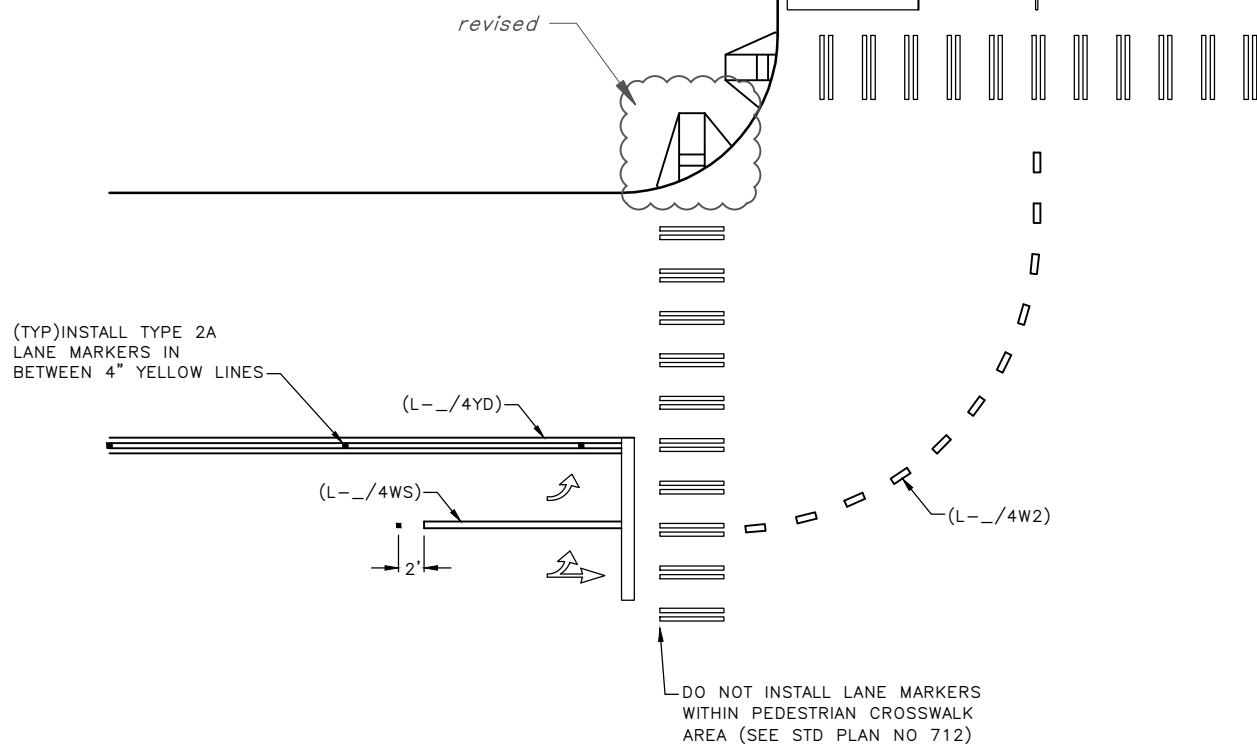


REF STD SPEC SEC 8-22




City of Seattle

NOT TO SCALE

TYPICAL INTERSECTION
GUIDELINE CHANNELIZATION

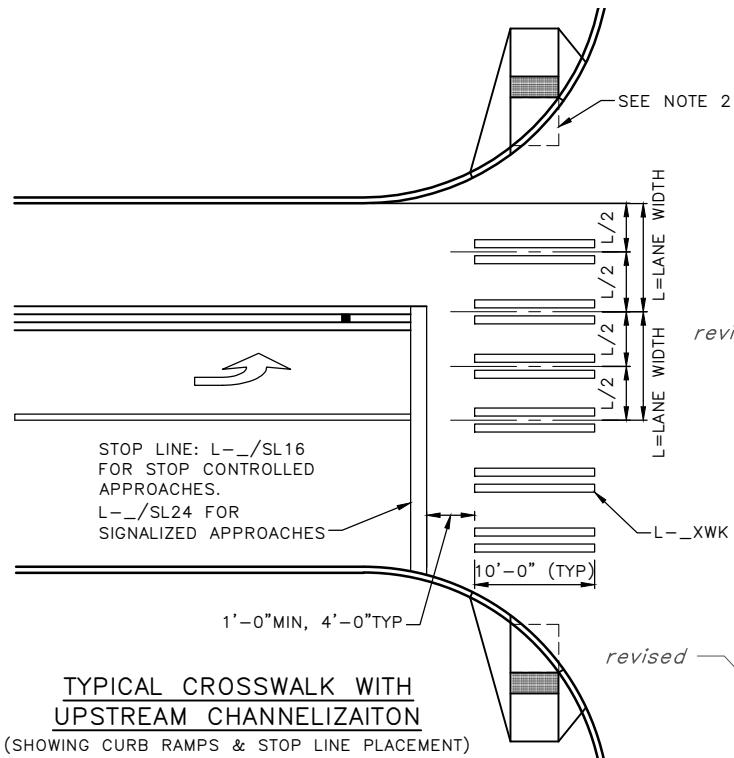


**TYPICAL CROSSWALK WITH
UPSTREAM CHANNELIZATION**
(SHOWING CURB RAMPS & STOP LINE PLACEMENT)

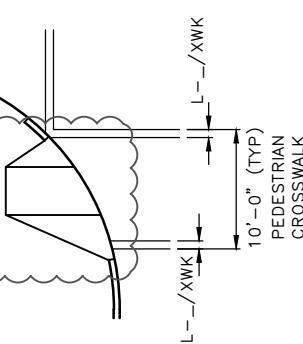

**TYPICAL TRANSVERSE
LINE CROSSWALK**

NOTES:

1. "LADDER STYLE" CROSSWALK MUST BE USED IN MOST APPLICATIONS. "TRANSVERSE LINE" CROSSWALK (L-_-/XWK2, L-_-/XWK) MAY ONLY BE USED WITH APPROVAL OF ENGINEER.
2. LOWER LANDING OF CURB RAMP MUST FALL WHOLLY WITHIN CROSSWALK LINES.
3. WHERE EXISTING TRAFFIC LANE LOCATIONS ARE BETWEEN 1' AND 4' FROM THE EDGE OF CROSSWALK, STOP LINE MAY BE PLACED UP TO 2' FROM THE CROSSWALK WITH THE APPROVAL OF ENGINEER.
4. EXACT LOCATION OF CROSSWALK AND STOP LINES MUST BE APPROVED BY SDOT.
5. COLORED OR TEXTURED PAVEMENT CROSSWALKS MUST BE SUPPLEMENTED WITH "TRANSVERSE LINE" CROSSWALK MARKINGS.
6. EXISTING CROSSWALK MARKINGS THAT CONFLICT WITH NEW CROSSWALK MARKINGS MUST BE REMOVED.
7. WHEN MARKED CROSSWALK ARE NOT PRESENT, STOP BAR MUST BE PLACED AT A MINIMUM DISTANCE OF 4'-0" UPSTREAM FROM THE EDGE OF THE DETECTABLE WARNING SURFACE OR ANTICIPATED PEDESTRIAN TRAVEL PATH, WHICHEVER IS GREATER.

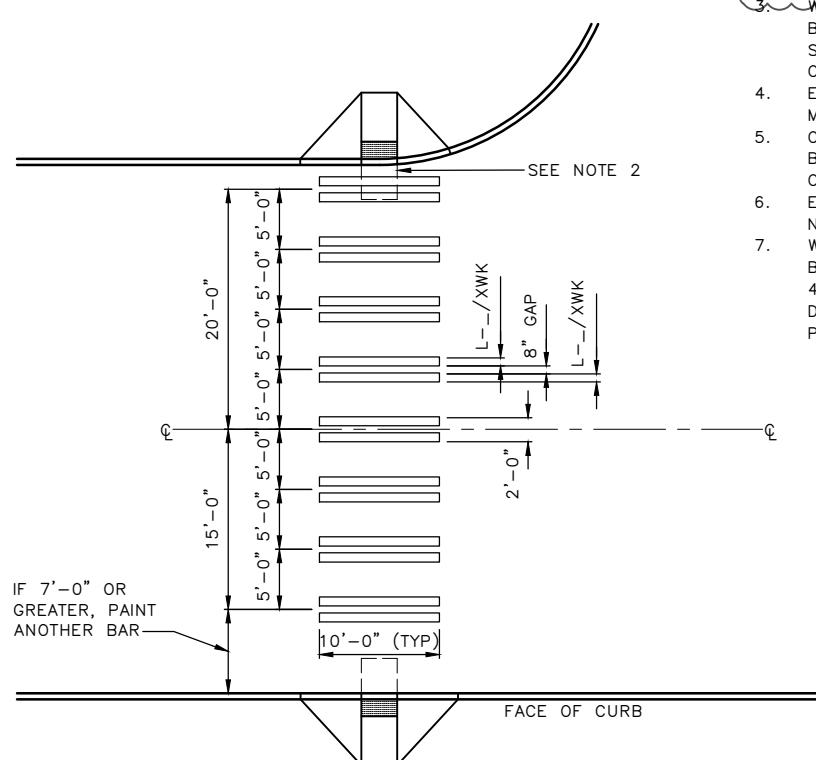

**TYPICAL CROSSWALK WITHOUT UPSTREAM
CHANNELIZATION**
(SHOWING CURB RAMPS & STOP LINE PLACEMENT)

WHERE TRAFFIC LANE LINES ARE NOT USED, LADDER BARS MUST BE 5'-0" CENTER TO CENTER, BEGINNING AT THE MARKED CENTERLINE OF THE ROADWAY

REF STD SPEC SEC 8-22



City of Seattle

NOT TO SCALE

**TYPICAL CROSSWALK & STOP
LINE INSTALLATION DETAILS**

SIGN REGULATING LANE TO BE USED BY BUSES ONLY (TYP).

S-750 (TYP)

IF MORE THAN 200' ADD ONE MORE CENTERED LEGEND TO BLOCK

THERE IS NO CHANNELIZATION FOR RIGHT TURNS BECAUSE THE ONE-WAY STREET DOES NOT ALLOW FOR IT.

BACK OF SIDEWALK

10'-0"

10'-0"

(UNMARKED PED CROSSING)

ONE WAY

renumbered from 717a to 717

S-720C (TYP)

S-730A (TYP)

(L-6WS)

ONLY
ONLY
MANDATORY MOVEMENT SIGN
REGULATING LANE USE AS RIGHT
TURN ONLY EXCEPT BUSES

(L-6W2)

PLACE AT OR NEAR ALLEY OR
MAJOR DRIVEWAY

ALLEY

(L-6WS)

SIGN REGULATING LANE TO BE USED BY BUSES ONLY (TYP). INCLUDE A "RIGHT TURNS PERMITTED" SIGN IF RIGHT TURNS EXIST INTO DRIVEWAYS OR AN ALLEY ALONG THE BLOCKFACE BEFORE THE RIGHT TURN SIGNING AT THE END OF THE BLOCK BEGINS.



REF STD SPEC SEC 8-22



City of Seattle

NOT TO SCALE

TYPICAL CURBSIDE RED
BUS LANE LAYOUT

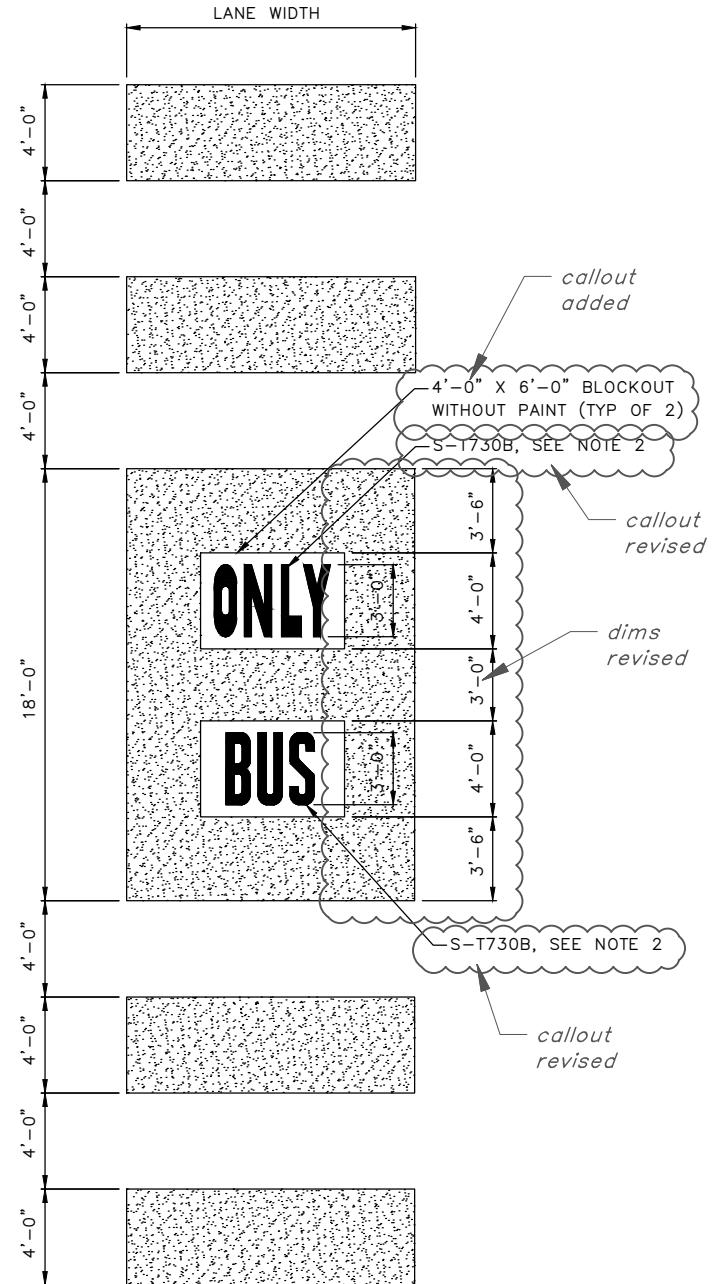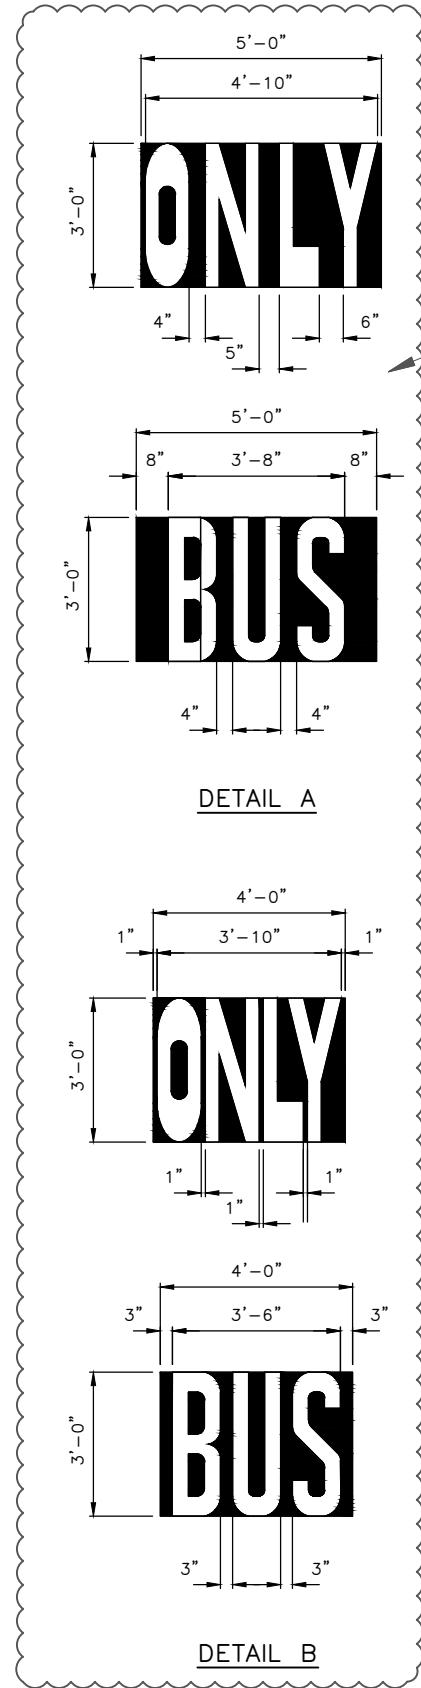

NOTES:

1. FHWA APPROVED RED COLOR FOR BUS LANES MUST BE USED WITH MMA.
2. FOR APPLICATION ON CEM CONC PVMT, LEGENDS PER STANDARD PLAN 730 MUST HAVE A 5'-0" X 3'-0" COLOR BLACK THERMOPLASTIC BACKGROUND PER DETAIL A. FOR APPLICATION ON CEM CONC PVMT IN A STREET CAR TRACK, LEGENDS PER STANDARD PLAN 730 MUST HAVE A 4'-0" X 3'-0" COLOR BLACK THERMOPLASTIC BACKGROUND PER DETAIL B. PROVIDE 6" MINIMUM GAP BETWEEN THERMO LEGENDS AND RED MMA.

750
RED BUS LANE MARKINGS

note 1
revised, note
2 added


REF STD SPEC SEC 8-22




City of Seattle

NOT TO SCALE

RED BUS LANE MARKINGS

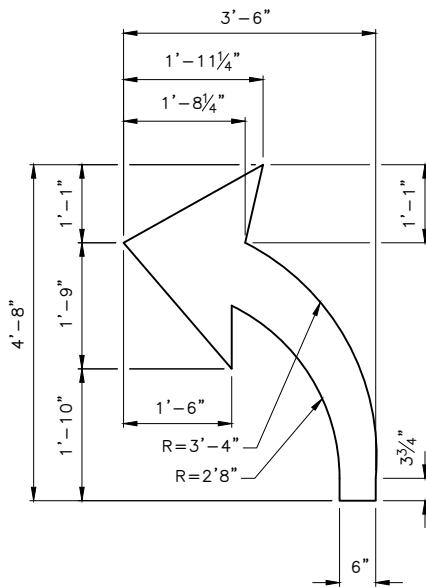

775A
NARROW BIKE LANE
LEFT ARROW

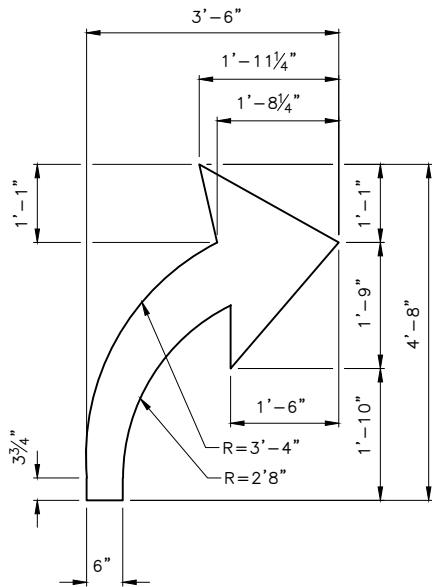

775B
NARROW BIKE LANE
RIGHT ARROW

NOTES:

1. TURN ARROWS TO BE USED IN BIKE LANES LESS THAN 5' WIDE IN COMBINATION WITH THE HELMETED BICYCLIST SYMBOL 770C.
2. LAYOUT SIMILAR TO 770A WITH 6' SPACING.


REF STD SPEC SEC 8-22



City of Seattle

NOT TO SCALE

NARROW BIKE LANE
TURN ARROW SYMBOLS

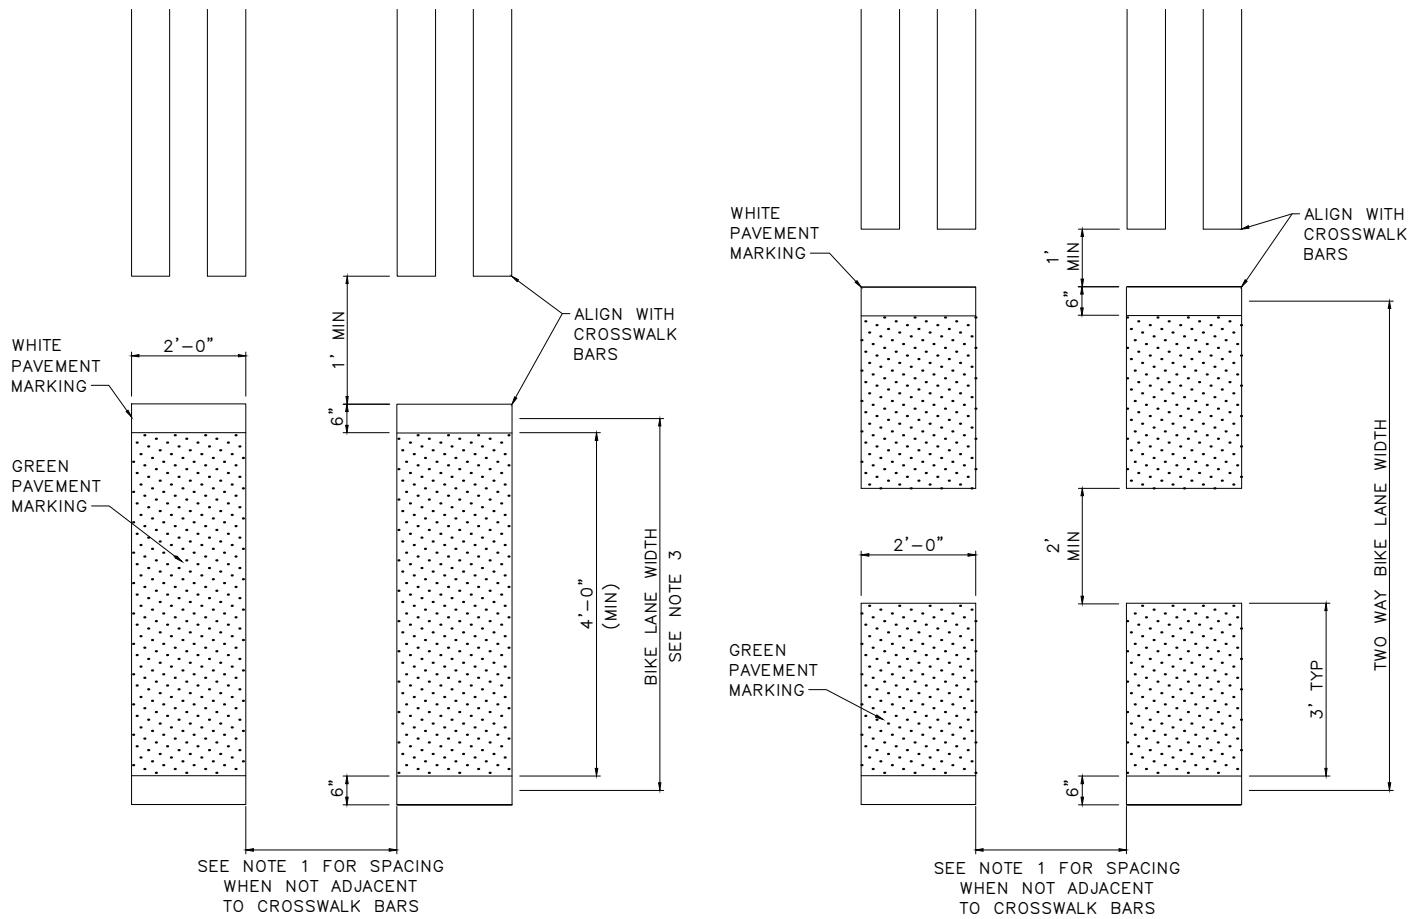**NOTES:**

1. WHERE STRIPED CROSSWALK DOES NOT EXIST, CROSS BIKE MUST BE PLACED AT LANE LINE AND 1/2 LANE WIDTH CONSISTENT WITH STANDARD PLAN 712. IF NO CROSSWALK OR LANE LINE EXISTS, CROSSBIKE MUST BE PLACED AT 5' ON CENTERS.
2. CROSS BIKE MATERIAL MUST BE MMA OR PRE-FORMED THERMOPLASTIC.
3. WHEN CONNECTING BIKE LANES OF VARYING WIDTH, THE CROSSBIKE WIDTH MUST BE SIZED TO THE NARROWER OF THE TWO FACILITIES.

typo corrected

REF STD SPEC SEC 8-22




City of Seattle

NOT TO SCALE

CROSS BIKE
PAVEMENT MARKING

std plan substantially revised

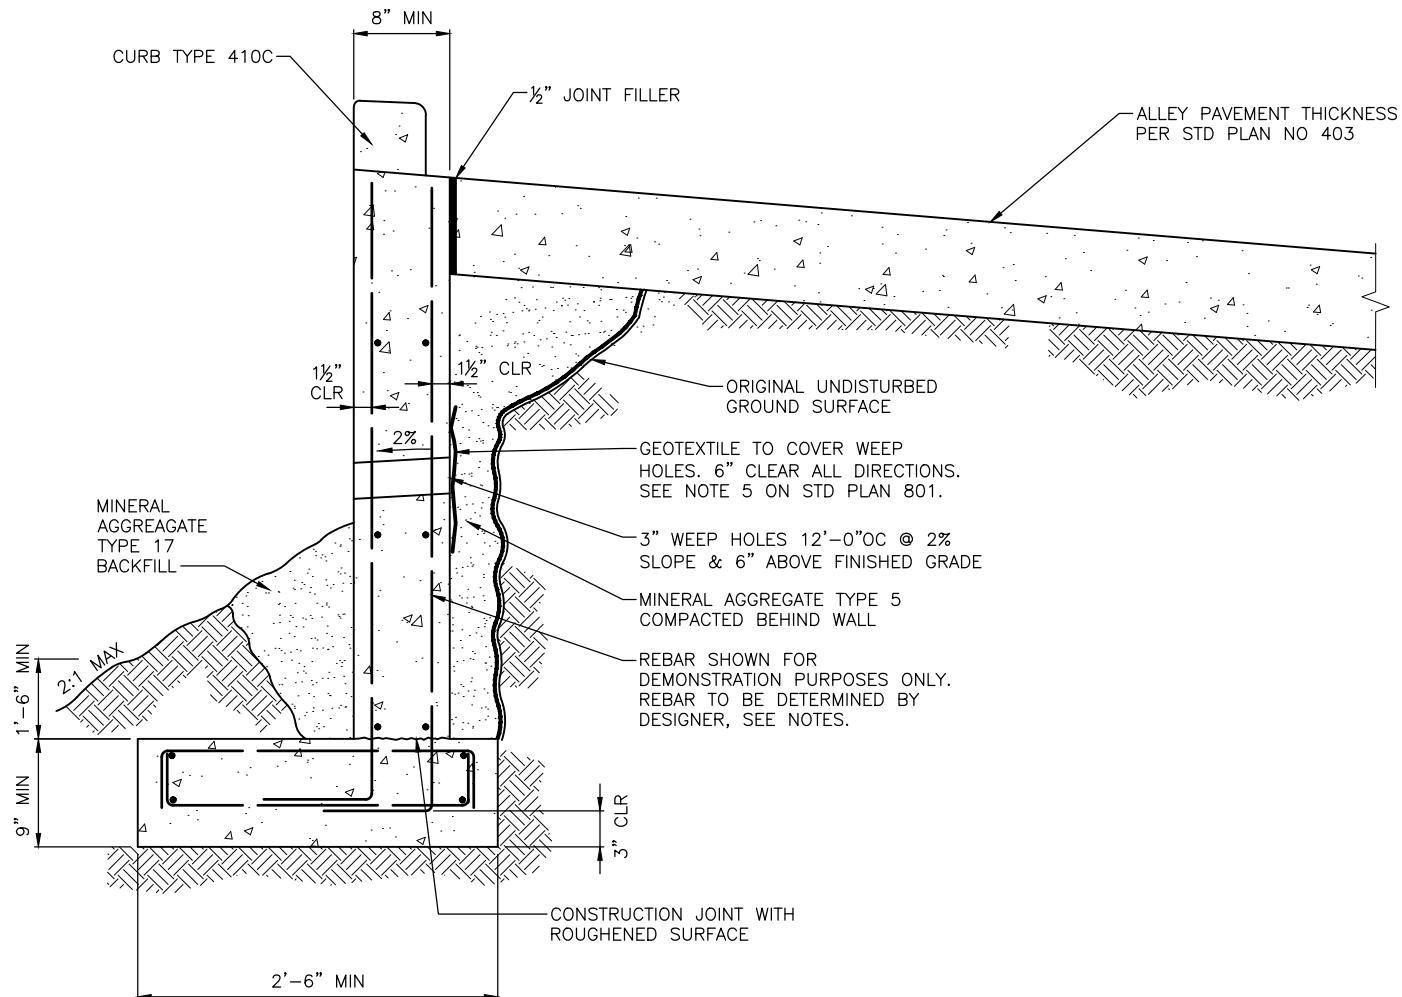**NOTES:**

1. THIS PLAN ONLY COVERS MINIMUM GEOMETRIC REQUIREMENTS. FINAL WALL GEOMETRY MUST BE DETERMINED BY THE DESIGNER AND MUST FOLLOW CURRENT EDITION OF AASHTO LRFD BRIDGE DESIGN SPECIFICATIONS. CALCULATIONS AND GEOTECHNICAL INFORMATION SHALL BE SUBMITTED FOR REVIEW AND APPROVAL.
2. CONCRETE FOR SUPPORT WALL MUST BE CLASS 4000
3. REINFORCING STEEL ASTM A706 (AASHTO M 31 GRADE 60). MINIMUM SIZE BAR, #4.
4. BASE OF SUPPORT WALL TO BE BEARING ON COMPACTED SUITABLE MATERIAL
5. BACK FORM FOR SUPPORT WALL MAY BE OMITTED AND CONCRETE PLACED AGAINST NATIVE EARTH WHEN GROUND CONDITIONS PERMIT. CLEAR COVER MUST BE 1-1/2" UNLESS NOTED OTHERWISE.
6. WALL MUST BE DESIGNED TO ACCOMODATE VEHICULAR LOADS AND PEDESTRIAN RAILING.


REF STD SPEC SEC 8-17, 8-19



City of Seattle

NOT TO SCALE

SUPPORT WALL

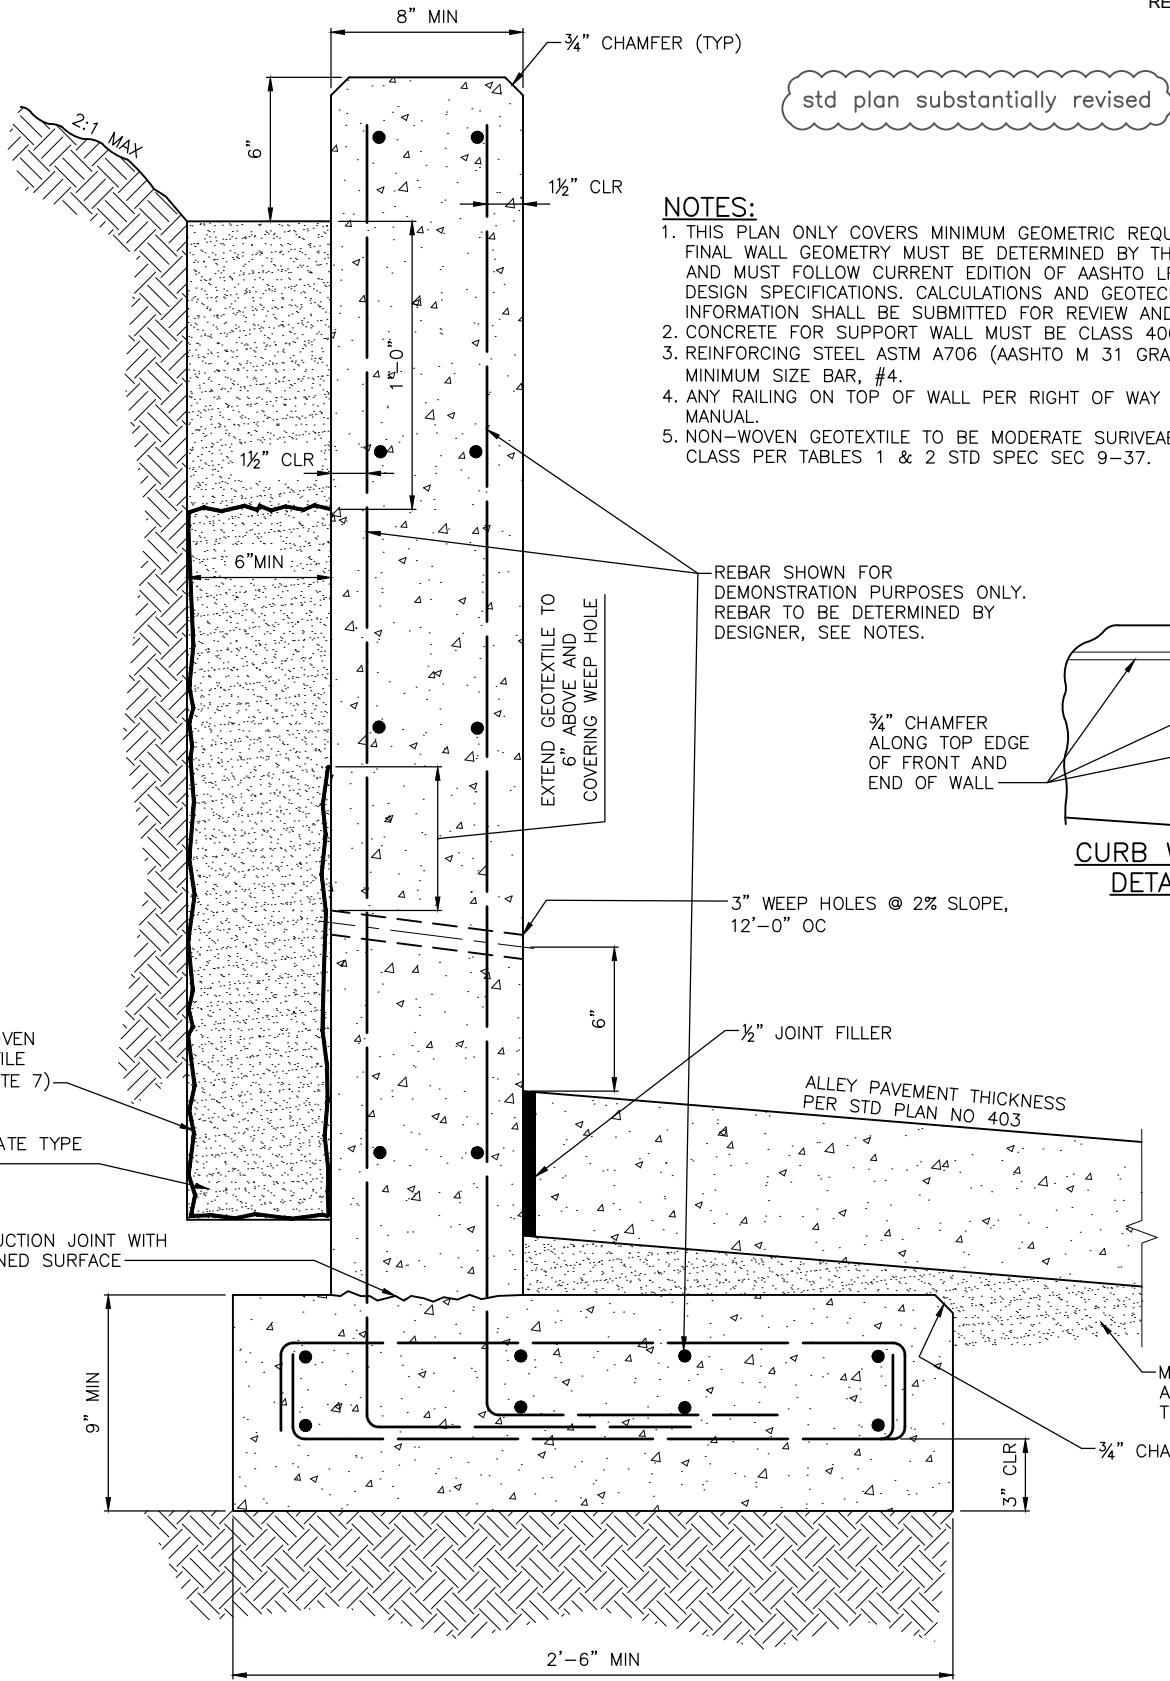

REF STD SPEC SEC 8-17



City of Seattle

NOT TO SCALE

CURB WALL