


REV	DESCRIPTION	DATE	APPROVED

MECH. CONTRACTOR
EMERALD AIRE, INC.
PROJECT MANAGER

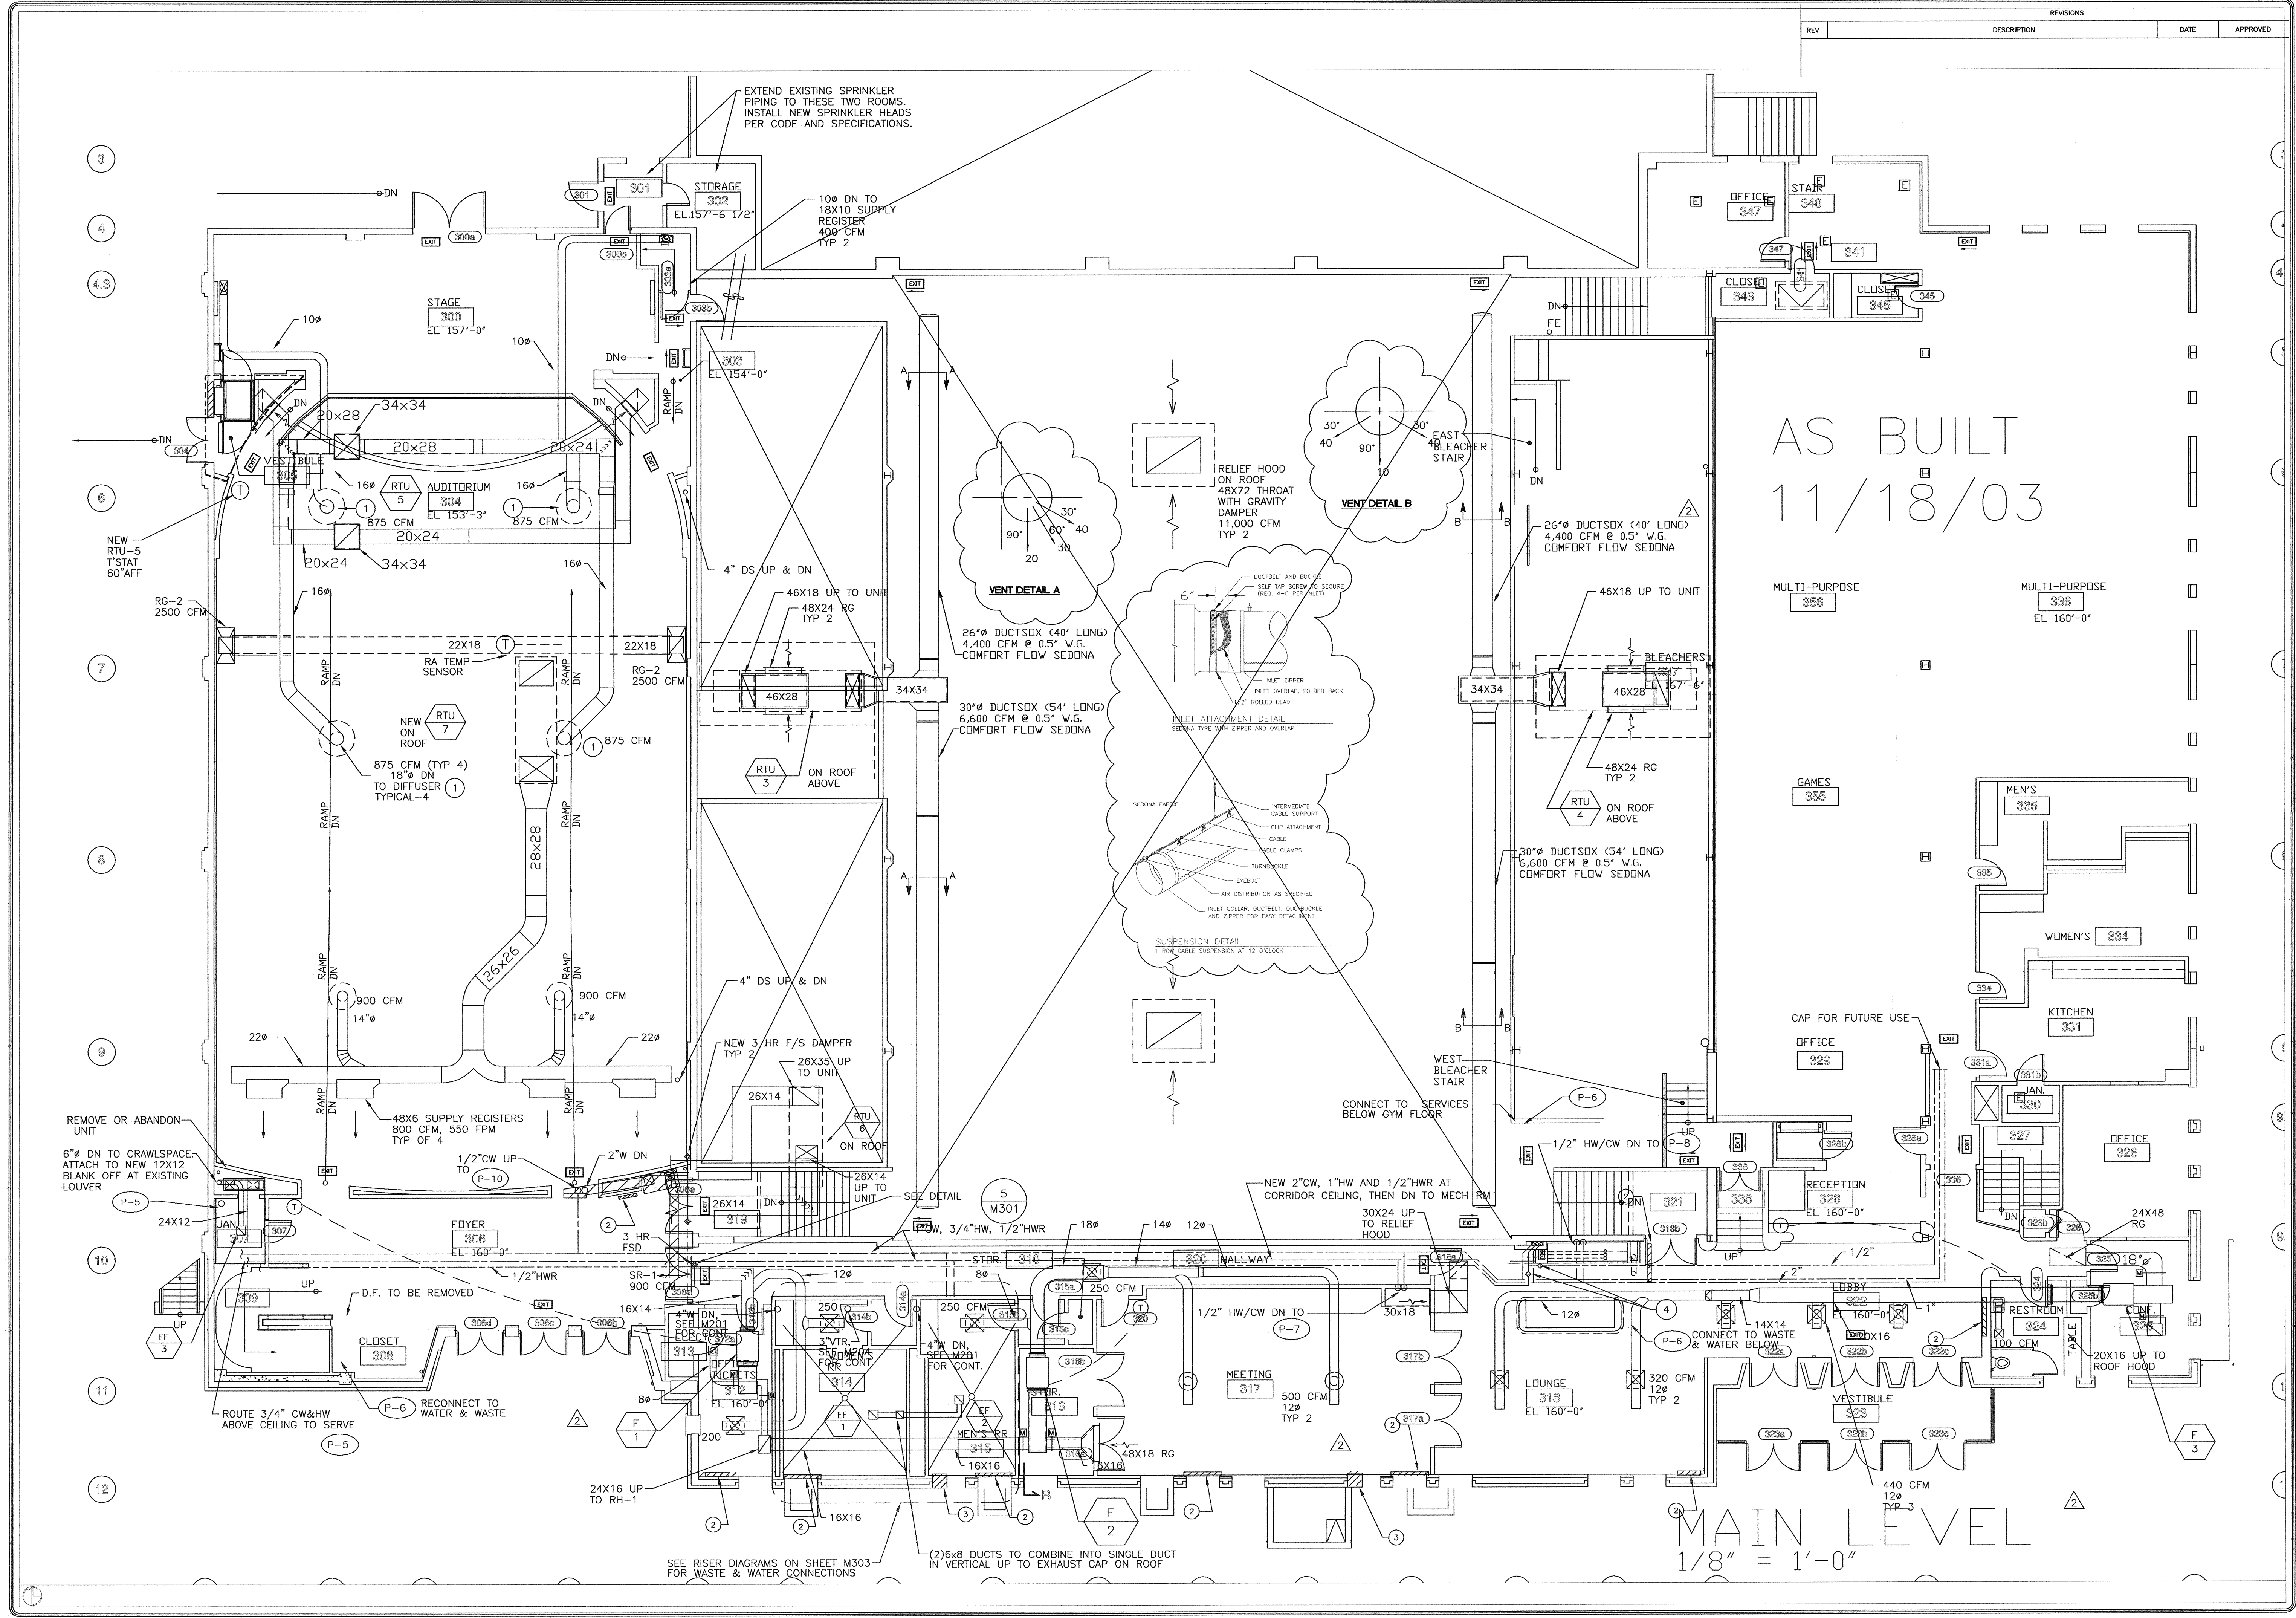

MAGNUSON PARK COMM. CNTR.
BLDG 47 SAND POINT WAY
SEATTLE, WA
PLUMBING TODAY
MAIN LEVEL

TITLE:
SHEET CONTENTS:

Excellence & Integrity

EMERALD AIRE

AP AIR CONDITIONING HEATING REFRIGERATION CONTROLS
SALES SERVICE INSTALLATION

5108 D STREET NW
AUBURN, WA 98001
(253) 872-5665 - (800) 291-5191
FAX: (253) 872-5797
CONT. #EMERAA 0558L

DRAWN	M STOKES
CHECKED BY	G KNAPINSKI
DATE	11/17/03
SCALE	AS NOTED
JOB NO.	302-426
M3	

\\Server1\Company\CAD Drawings\Magnuson Park\As Built Drawings\As Built M3.dwg, Layout1, 11/19/2003 11:00:05 AM