

FLAG NOTES

- 1

STONE BENCH, SEE

5

L5.1
- 2

STONE LOOKOUT, SEE

AA

TBD
- 3

PLAY AREA RAMP, TYP, SEE

6

L5.0
- 4

PLAY AREA CURB OR WALL, TYP, SEE C5.0 &

4

L5.1
- 5

3-RAIL FENCE, PARKS STD

LAYOUT NOTES

1. SEE NOTES L0.1
2. SEE CIVIL SHEETS FOR GRADING & DRAINAGE

KEY

- EXISTING TREES ADJACENT TO WORK
- CONCRETE PAVING, SEE

4

L5.0
- EXPOSED AGGREGATE PAVING, SEE

5

L5.0
- COBBLE PAVING, SEE

5

L5.0
- CRUSHED ROCK PAVING, TYP, SEE

3

L5.0
- EWf SURFACING, SEE

4

L5.1
- LOG, TYP, SEE

3

L5.1
- BOULDER, TYP, SEE

2



L5.1
- INTERPRETIVE BOULDER, TYP, SEE

2

L5.1
- ROCKERY, TYP, SEE

1

L5.1

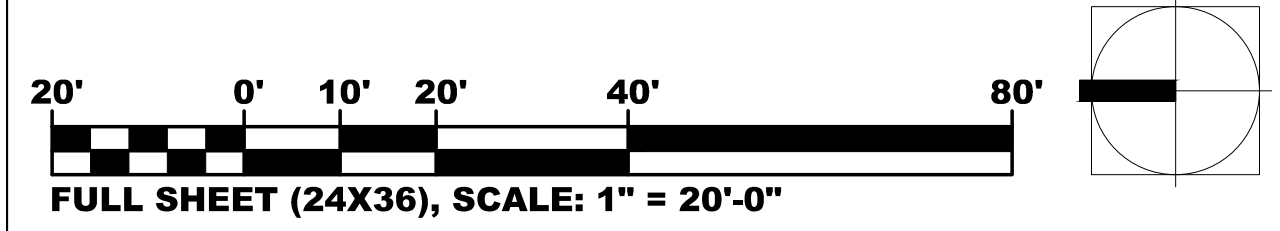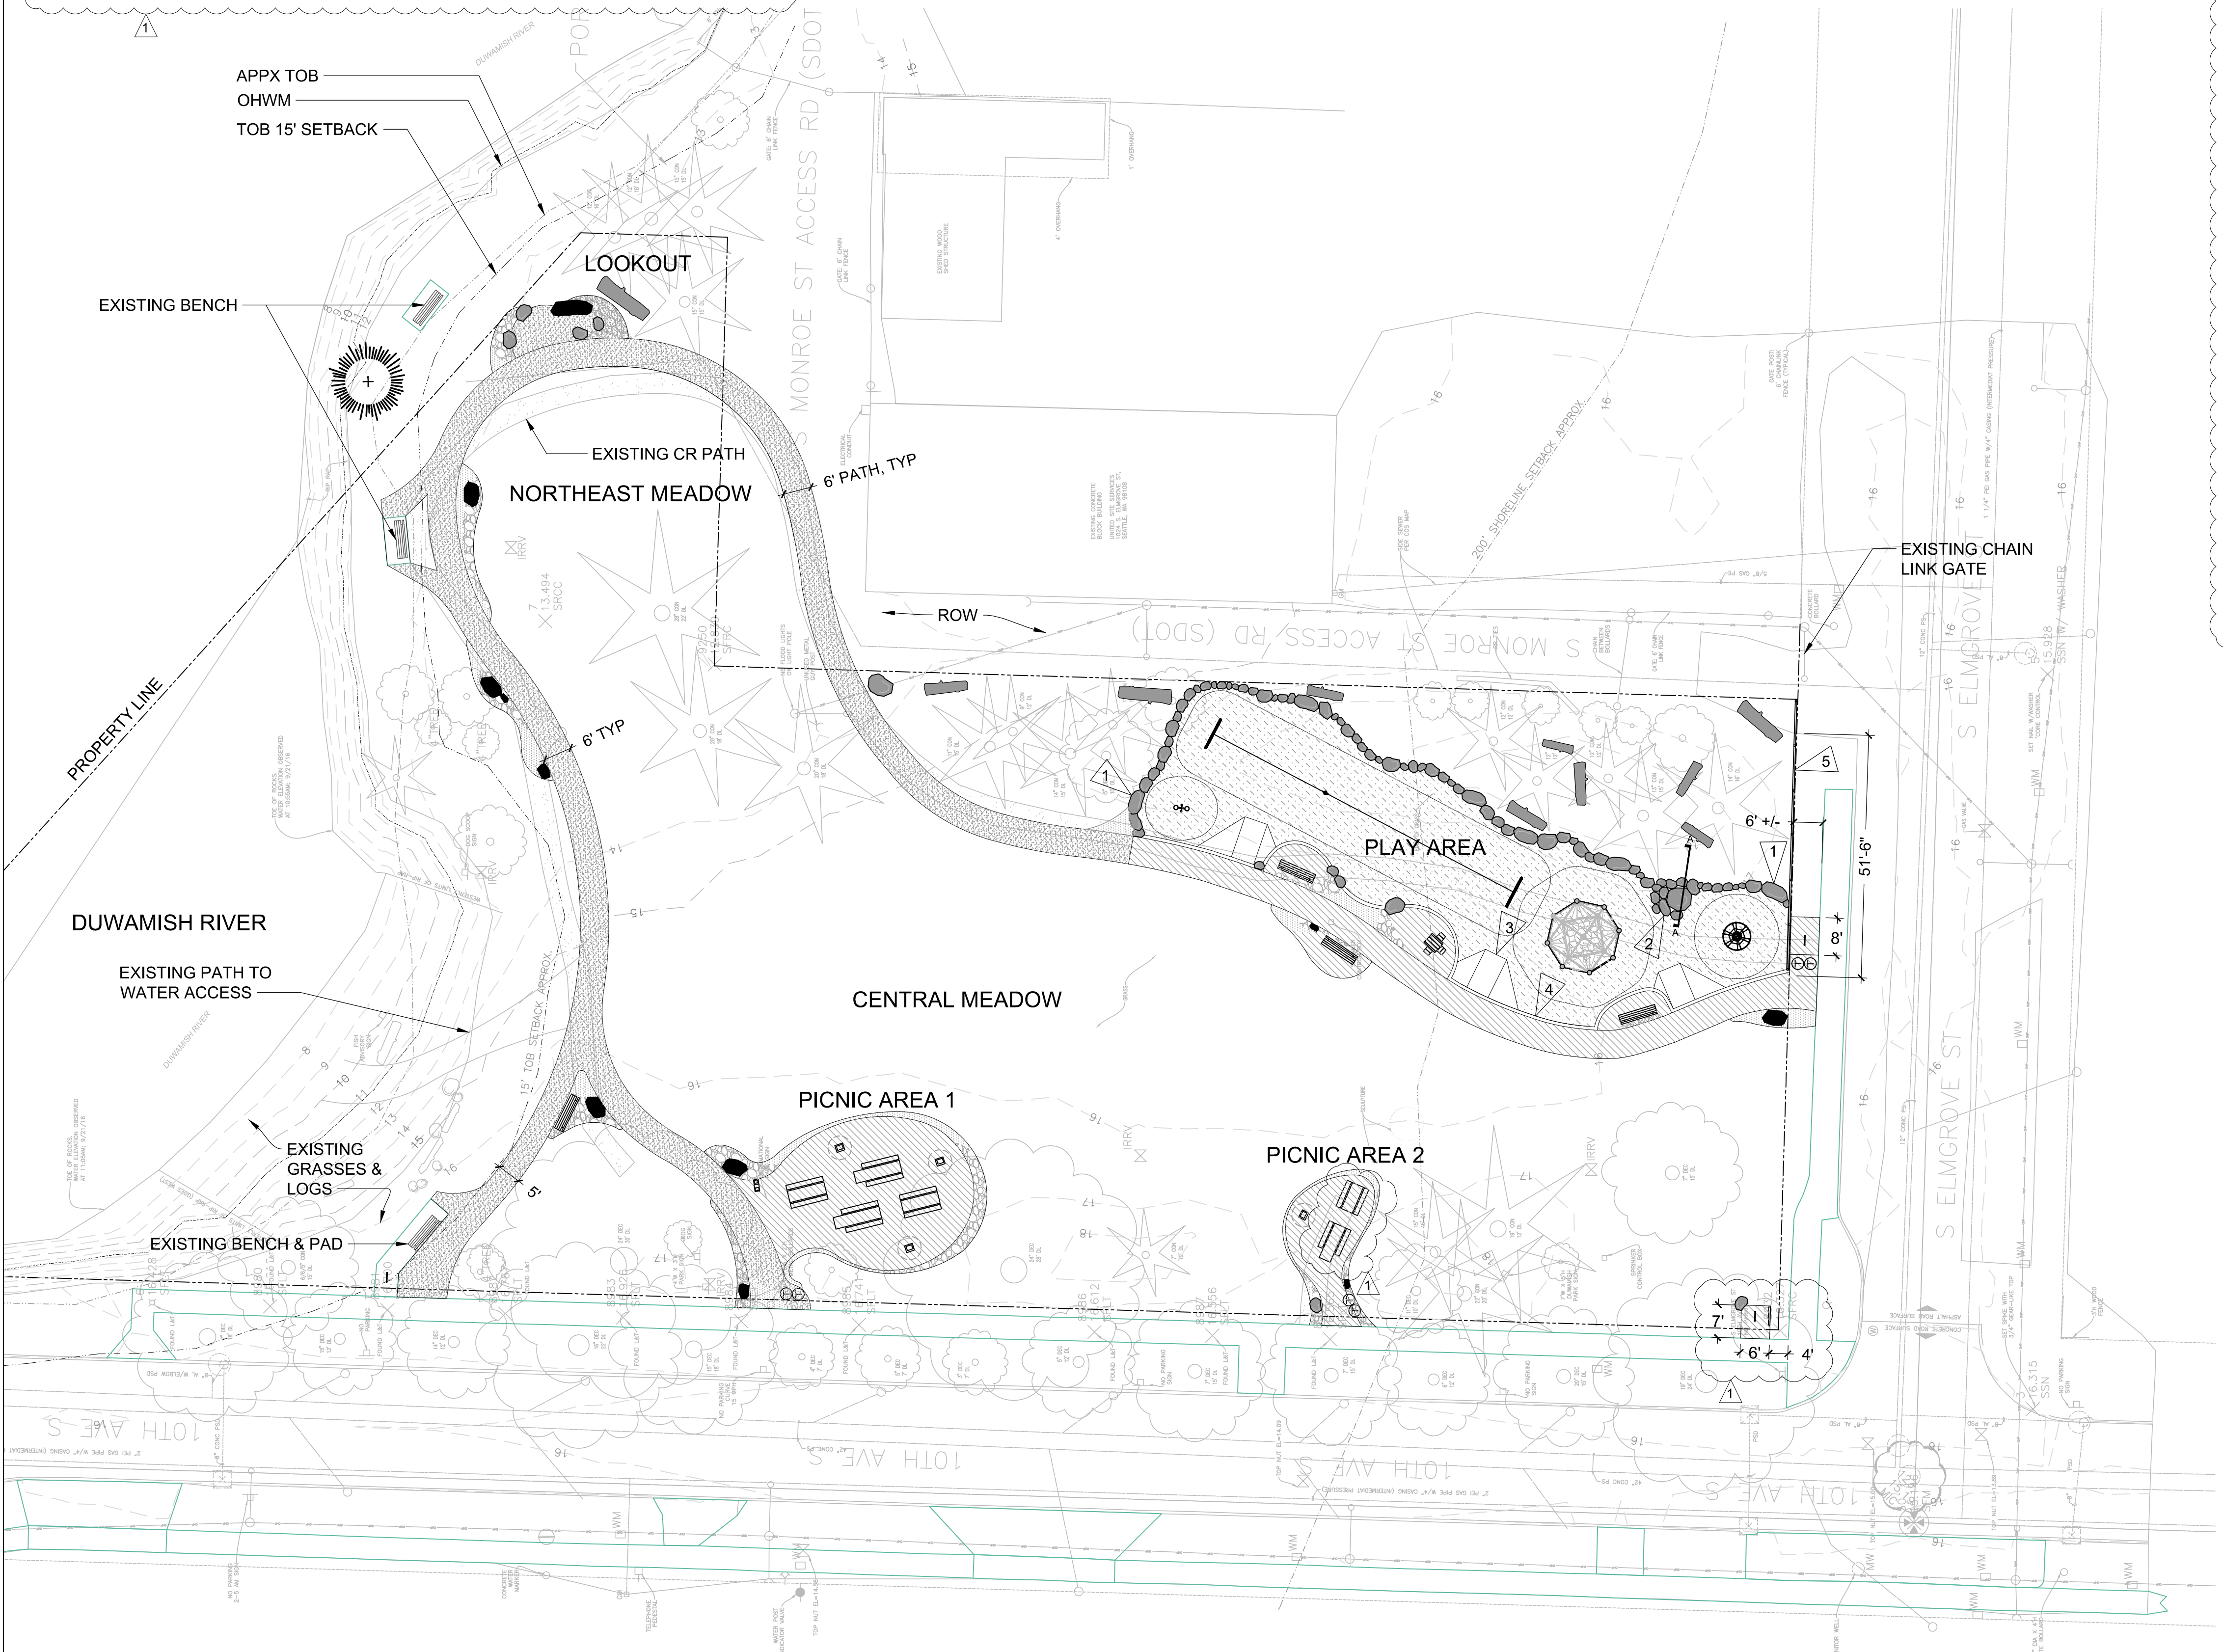

>>>>CAUTION - CALL 811<<<<
UTILITY NOTIFICATION CENTER
BEFORE YOU DIG!
WWW.CALL811.COM
ALSO CONTRACT WITH A COMMERCIAL UNDERGROUND UTILITIES LOCATOR SERVICE TO IDENTIFY BELOW-GROUND INFRASTRUCTURE THAT MAY NOT BE LOCATED BY CALL 811 BEFORE-YOU-DIG.
100% CONSTRUCTION DOCUMENT
NOT FOR CONSTRUCTION
13 MAY 2019

3		
2		
1	1 PERMIT REVISIONS	7/18/19
NO.	REVISION - AS BUILT	DATE

REVIEWED: _____ DATE _____
PARK ENGINEER _____
All work done in accordance with the City of Seattle Standard Plans and Specifications in effect on the date shown above, and supplemented by Special Provisions.

JOHNSON SOUTHERLAND
3827B South Edmonds St.
Seattle, WA 98118
Ph. 206-723-8275
Fax 206-723-0392

MARGARET E. JOHNSON
CERTIFICATE NO. 426

Seattle Parks & Recreation

DUWAMISH WATERWAY PARK
7900 10TH AVE SOUTH, SEATTLE, WA 98106

RENOVATION

LAYOUT PLAN

DESIGNED MJ	DATE 13 MAY 2019
DRAWN SB	SHEET 6 OF 18
CHECKED MJ	
ORDINANCE NO. #####/#####	L2.0
CONTRACT NO. #####	
SCALE 1"=20'-0"	